


CORNER RECORD

City of Costa Mesa

Document Number 2001-1606 B
County of Orange, California

Brief Legal Description Fairview Road & Adams Avenue & El Camino Drive

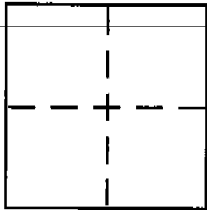

CORNER TYPE

Government Corner ☐ Control ☐
Meander ☐ Property ☐
Rancho ☐ Other ☒
Date of Survey 7/17/01

COORDINATES (Optional)

N. _____
E. _____
Zone _____ NAD27 ☐ NAD83 ☐
NAD83 Epoch _____
Elev. _____
Vert. Datum: NGVD29 ☐ NAVD88 ☐
Meas. Units: Metric ☐ Imperial ☐

Corner — Left as found ☐ Found and tagged ☐ Established ☐ Reestablished ☒ Rebuilt ☐

Identification and type of corner found: Evidence used to identify or procedure used to establish or reestablish the corner:

Found as described on the reverse of this sheet. Points tied out 7/17/00 prior to the paving efforts by the City of Costa Mesa.

A description of the physical condition of the monument as found and as set or reset: _____

These ties are for the purpose of perpetuating the found monumentation. No claim is made as to the relationship of the points or lines shown hereon to true boundary location.

SURVEYOR'S STATEMENT

This Corner Record was prepared by me or under my direction in conformance with
the Land Surveyor's Act on October 30, 2001

Signed [Signature] P.L.S or R.C.E. No. L.S. 5411



COUNTY SURVEYOR'S STATEMENT

NOV 06 2001

This Corner Record was received _____

and examined and filed JAN 07 2002


Signed [Signature] P.L.S or R.C.E. No. L.S. 4408

Title County Surveyor



County Surveyor's Comment _____

SEE CR 2000-372 FOR PRE-CONSTRUCTION

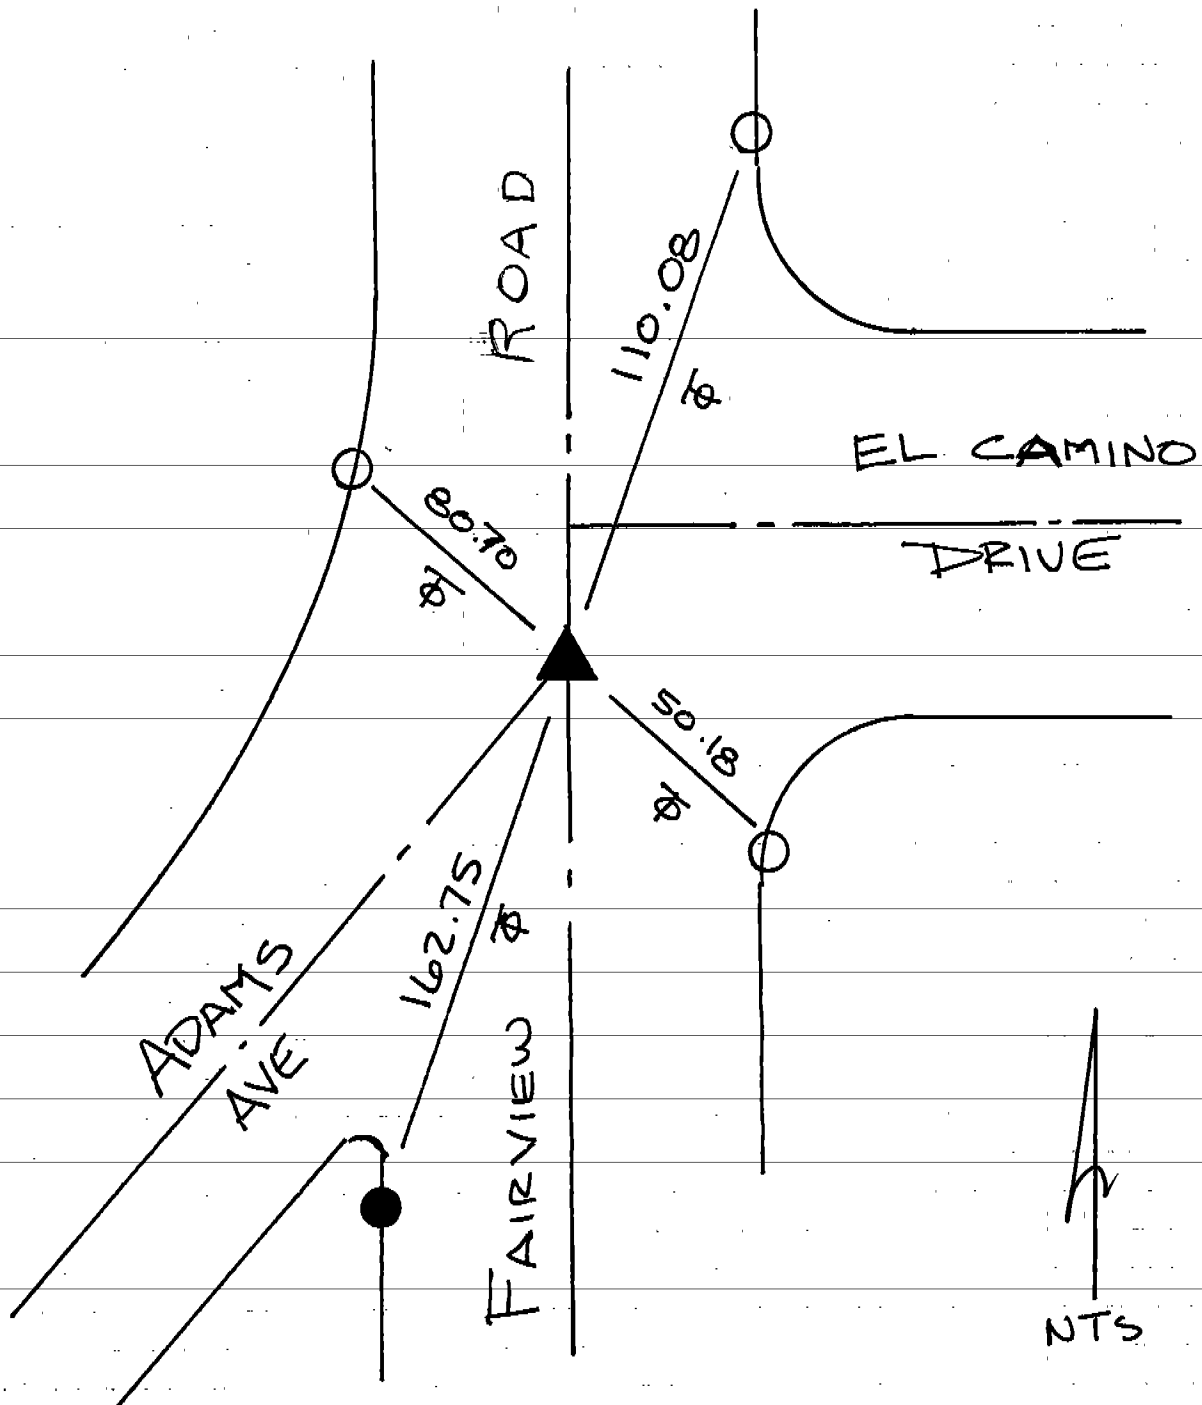

- ▲ - FD SPK/W No REF PRIOR TO CONST. 2/17/00
RESET PK/W L.S. 5411 AFTER CONST 7/17/00,
PER CR 2000-372A
- - FD L/T₄ O.C.S. IN CURB No REF PRIOR TO CONST 2/17/00
- - SET L/T L.S. 5411 IN CURB PRIOR TO CONST 2/17/00