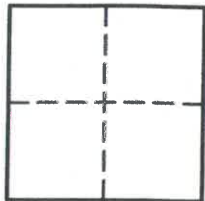


CORNER RECORD

Agency Index

Document Number

2018-0483BCity of COSTA MESACounty of ORANGE, CaliforniaBrief Legal Description BRISTOL STREET & BEAR STREET**CORNER TYPE**

Government Corner ☐ Control
Meander ☐ Property
Rancho ☐ Other

Date of Survey 2/22/2018**COORDINATES (Optional)**

N. _____ E. _____

☒ Elevation _____☐ Units Metric ☐ U.S. Survey Foot ☒☐ Horizontal Datum _____

Zone _____ Epoch Date _____

Vertical Datum _____

☐ Complies with Public Resources Code §§8801-8819☐ Complies with Public Resources Code §§8890-8902PLS Act Ref: ☐ 8765(d) ☒ 8771 ☐ 8773 ☐ Other:

Corner/
Monument: ☐ Left as found ☐ Established ☐ Rebuilt ☐ Pre-Construction
☐ Found and tagged ☒ Reestablished ☐ Referenced ☒ Post-Construction

Narrative of corner identified and monument as found, set, reset, replaced, or removed:

☒ See sheet #2 for description (s):**SURVEYOR'S STATEMENT**


This Corner Record was prepared by me or under my direction in conformance with
the Professional Land Surveyors' Act on 3/5/2018

Signed [Signature] P.L.S. or R.C.E. No. 5411**COUNTY SURVEYOR'S STATEMENT**This Corner Record was received APRIL 4, 2018and examined and filed JUL 27 2018Signed [Signature: Kevin R. Hills] P.L.S. or R.C.E. No. 6617Title COUNTY SURVEYOR

County Surveyor's Comment _____

REFERENCES

R-1 = COUNTY OF ORANGE CORNER RECORD 2018-0474A
 [] = RECORD & MEASURED DISTANCE PER R-1

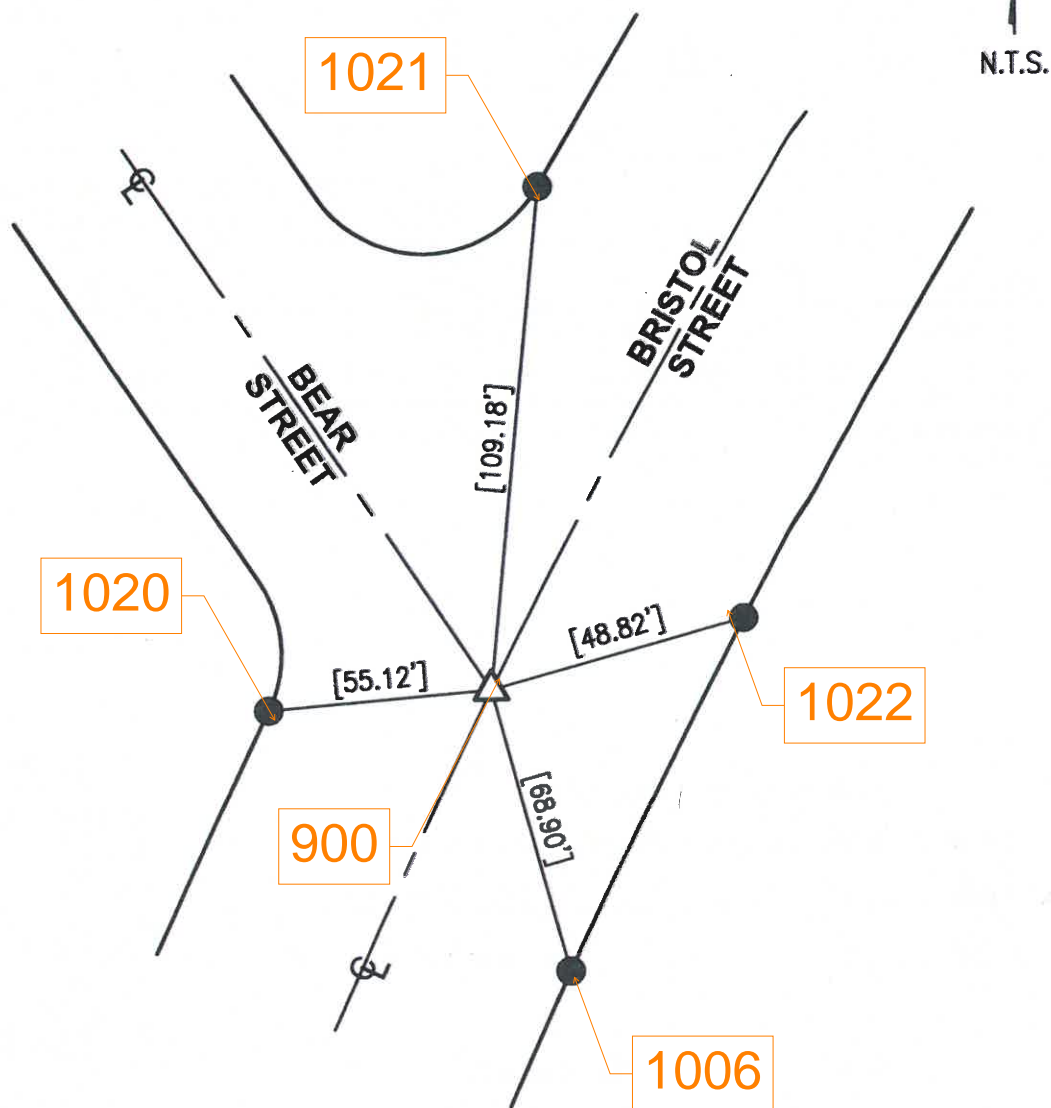

MONUMENT NOTES

- △ FOUND NOTHING, SET GEAR SPIKE & WASHER STAMPED "LS 5411" PER TIES ON R-1, FLUSH, AFTER CONSTRUCTION.
- FOUND LEAD, TACK & TAG "LS 5411" IN T.C. PER R-1.

THE PURPOSE OF THIS RECORD IS TO DOCUMENT THE PERPETUATION OF FOUND MONUMENT(S) PURSUANT TO THE PLS ACT SECTION 8771.
 17-SUL-302