
CORNER RECORD			Document Number.		nber
City of	Costa Mesa		C	ounty of	Orange , California
Brief Legal Descrip	otion Baker Stre	et @ B	abb Stree	t (north) and	Babb Street (south)
					COORDINATES (Optional)
	CORN	ER TYP	PΕ		<u>N</u>
	Government Corner		Control	苍	ENAD27
	Meander		Property		NAD83 Epoch
	Rancho		Other	0	Elevation
	Date of Survey	08/0	8/2008		Vertical Datum: NGVD29☐ NAVD88☐ Units: Metric☐ Imperial☐ U.S. Survey☐
Corner — Lef	t as found XXX Found	and tag	ged 🔲	Established	Reestablished Rebuilt
Identification and typ	oe of corner found; Evidence	e used	to identify	or procedure	used to establish or reestablish the corner:
Found a	as described on reverse	this for	rm. Point	s tied out pr	ior to paving effort.
					· · · · · · · · · · · · · · · · · · ·
					170 ° 100 ° 170 °
					
A description of the	physical condition of the	e monu	ment as fo	ound and as	set or reset:
rga.k	C 43			1	A.S. DE S. S. D.
					ntation. No claim is made as
to the re	elationship of the points	or line	es shown	nereon to tru	le boundary locations.
	SURVEYOR'S	S STAT	EMENT		LAND
This Corner Record	d was prepared by me or	under	my directio	on in conform	nance with
// /			-		
the Professional La	profesurveyers) Act on _		October 3	, 2008	(LS 6970
Signed Dery	J Jules		P.L.S. XXX	KRXXXXEX No	
, , , ,	· •				PRES 9-9-75
					OF CALIFOR
	COUNTY SURVE	YOR'S			
This Corner Recor	d was received		OCT 1 '	7 2008	SED LAND SURIL
examined and filed	NOV 04 2008			· .	C. HORNEC
examined and filed	11				
Signed	ffre 1	(P.L.S.)or	R.C.E. No.	7212 Exp. 03/31/10
TitleØEPUTY	COUNTY SURVEYO	R `			*\ *\ \\\\\\\\\\\\\\\\\\\\\\\\\\\\\\
7100	· · · · · · · · · · · · · · · · · · ·		•		OF CALIFORNIA
County Sungayora	Commont				OF CALL
Journey Surveyor's	Comment				

	<u> </u>				

◆ F0115-5

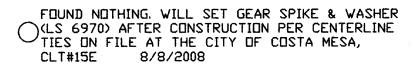

- ➤ FOUND CHIS '+' IN TO PER CENTERLINE TIES ON FILE AT THE CITY OF COSTA MESA, CLT#15E
- OSET LITAT (LS 6970 TIE) IN TO
- FOUND NOTHING. WILL SET GEAR SPIKE & WASHER (LS 6970) AFTER CONSTRUCTION PER CENTERLINE TIES ON FILE AT THE CITY OF COSTA MESA, CLT#230
- FOUND CHIS "+" IN TO PER CENTERLINE TIES ON FILE AT THE CITY OF COSTA MESA, CLT#230

