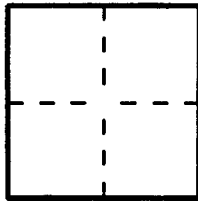


CORNER RECORD

Document Number 2008-2233 ACity of Costa Mesa County of Orange, CaliforniaBrief Legal Description Baker Street @ Milbro Street

CORNER TYPE

Government Corner ☐ Control ☒
Meander ☐ Property ☐
Rancho ☐ Other ☐
Date of Survey 08/08/2008

COORDINATES (Optional)

N. _____
E. _____
Zone _____ NAD27 ☐ NAD83 ☐
NAD83 Epoch _____
Elevation _____
Vertical Datum: NGVD29 ☐ NAVD88 ☐
Units: Metric ☐ Imperial ☐ U.S. Survey ☐

Corner — Left as found ☒ Found and tagged ☐ Established ☐ Reestablished ☐ Rebuilt ☐

Identification and type of corner found; Evidence used to identify or procedure used to establish or reestablish the corner:

Found as described on reverse this form. Points tied out prior to paving effort.


A description of the physical condition of the monument as found and as set or reset: _____

Ties are for the purpose of perpetuating the found monumentation. No claim is made as
to the relationship of the points or lines shown hereon to true boundary locations.

SURVEYOR'S STATEMENT

This Corner Record was prepared by me or under my direction in conformance with
the Professional Land Surveyors' Act on October 3, 2008

Signed Betty L. Mills P.L.S. or R.C.E. No. 6970

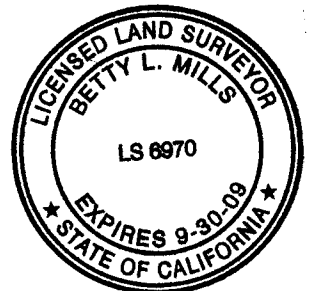

COUNTY SURVEYOR'S STATEMENT

This Corner Record was received OCT 17 2008

examined and filed NOV 18 2008

Signed [Signature] P.L.S. or R.C.E. No. 7212

Title DEPUTY COUNTY SURVEYOR



County Surveyor's Comment _____

PRE CONSTRUCTION

○ FOUND NOTHING. WILL SET GEAR SPIKE & WASHER (LS 6970) AFTER CONSTRUCTION PER CENTERLINE TIES ON FILE AT THE CITY OF COSTA MESA, CLF#232 8/8/2008

✕ FOUND CHIS "+" IN TC PER CENTERLINE TIES ON FILE AT THE CITY OF COSTA MESA, CLF#232

○ SET L,T&T (LS 6970 TIE) IN TC

DISTANCES SHOWN IN () ARE PER CENTERLINE TIES ON FILE AT THE CITY OF COSTA MESA, CLT#232

SCALE 1"=30'

