


FILED
FEB. 10 - 1955
COUNTY SURVEYOR
OF ORANGE COUNTY, CALIFORNIA


RECORD OF SURVEY

OF A PORTION OF LOT 152, BLOCK 51 OF IRVINE'S SUBDIVISION AS SHOWN ON A MAP RECORDED IN BOOK 1, PAGE 88, OF MISCELLANEOUS RECORD MAPS; AND OF A PORTION OF TRACT NO. 706 AS SHOWN ON A MAP RECORDED IN BOOK 21, PAGE 25 OF MISCELLANEOUS MAPS; RECORDS OF ORANGE COUNTY, CALIFORNIA.

January 1955

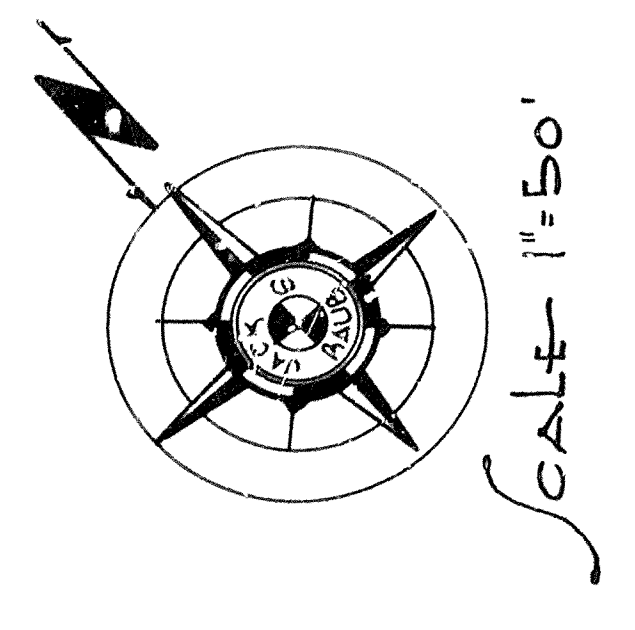

CHESTER L. THOMAS
Surveyor

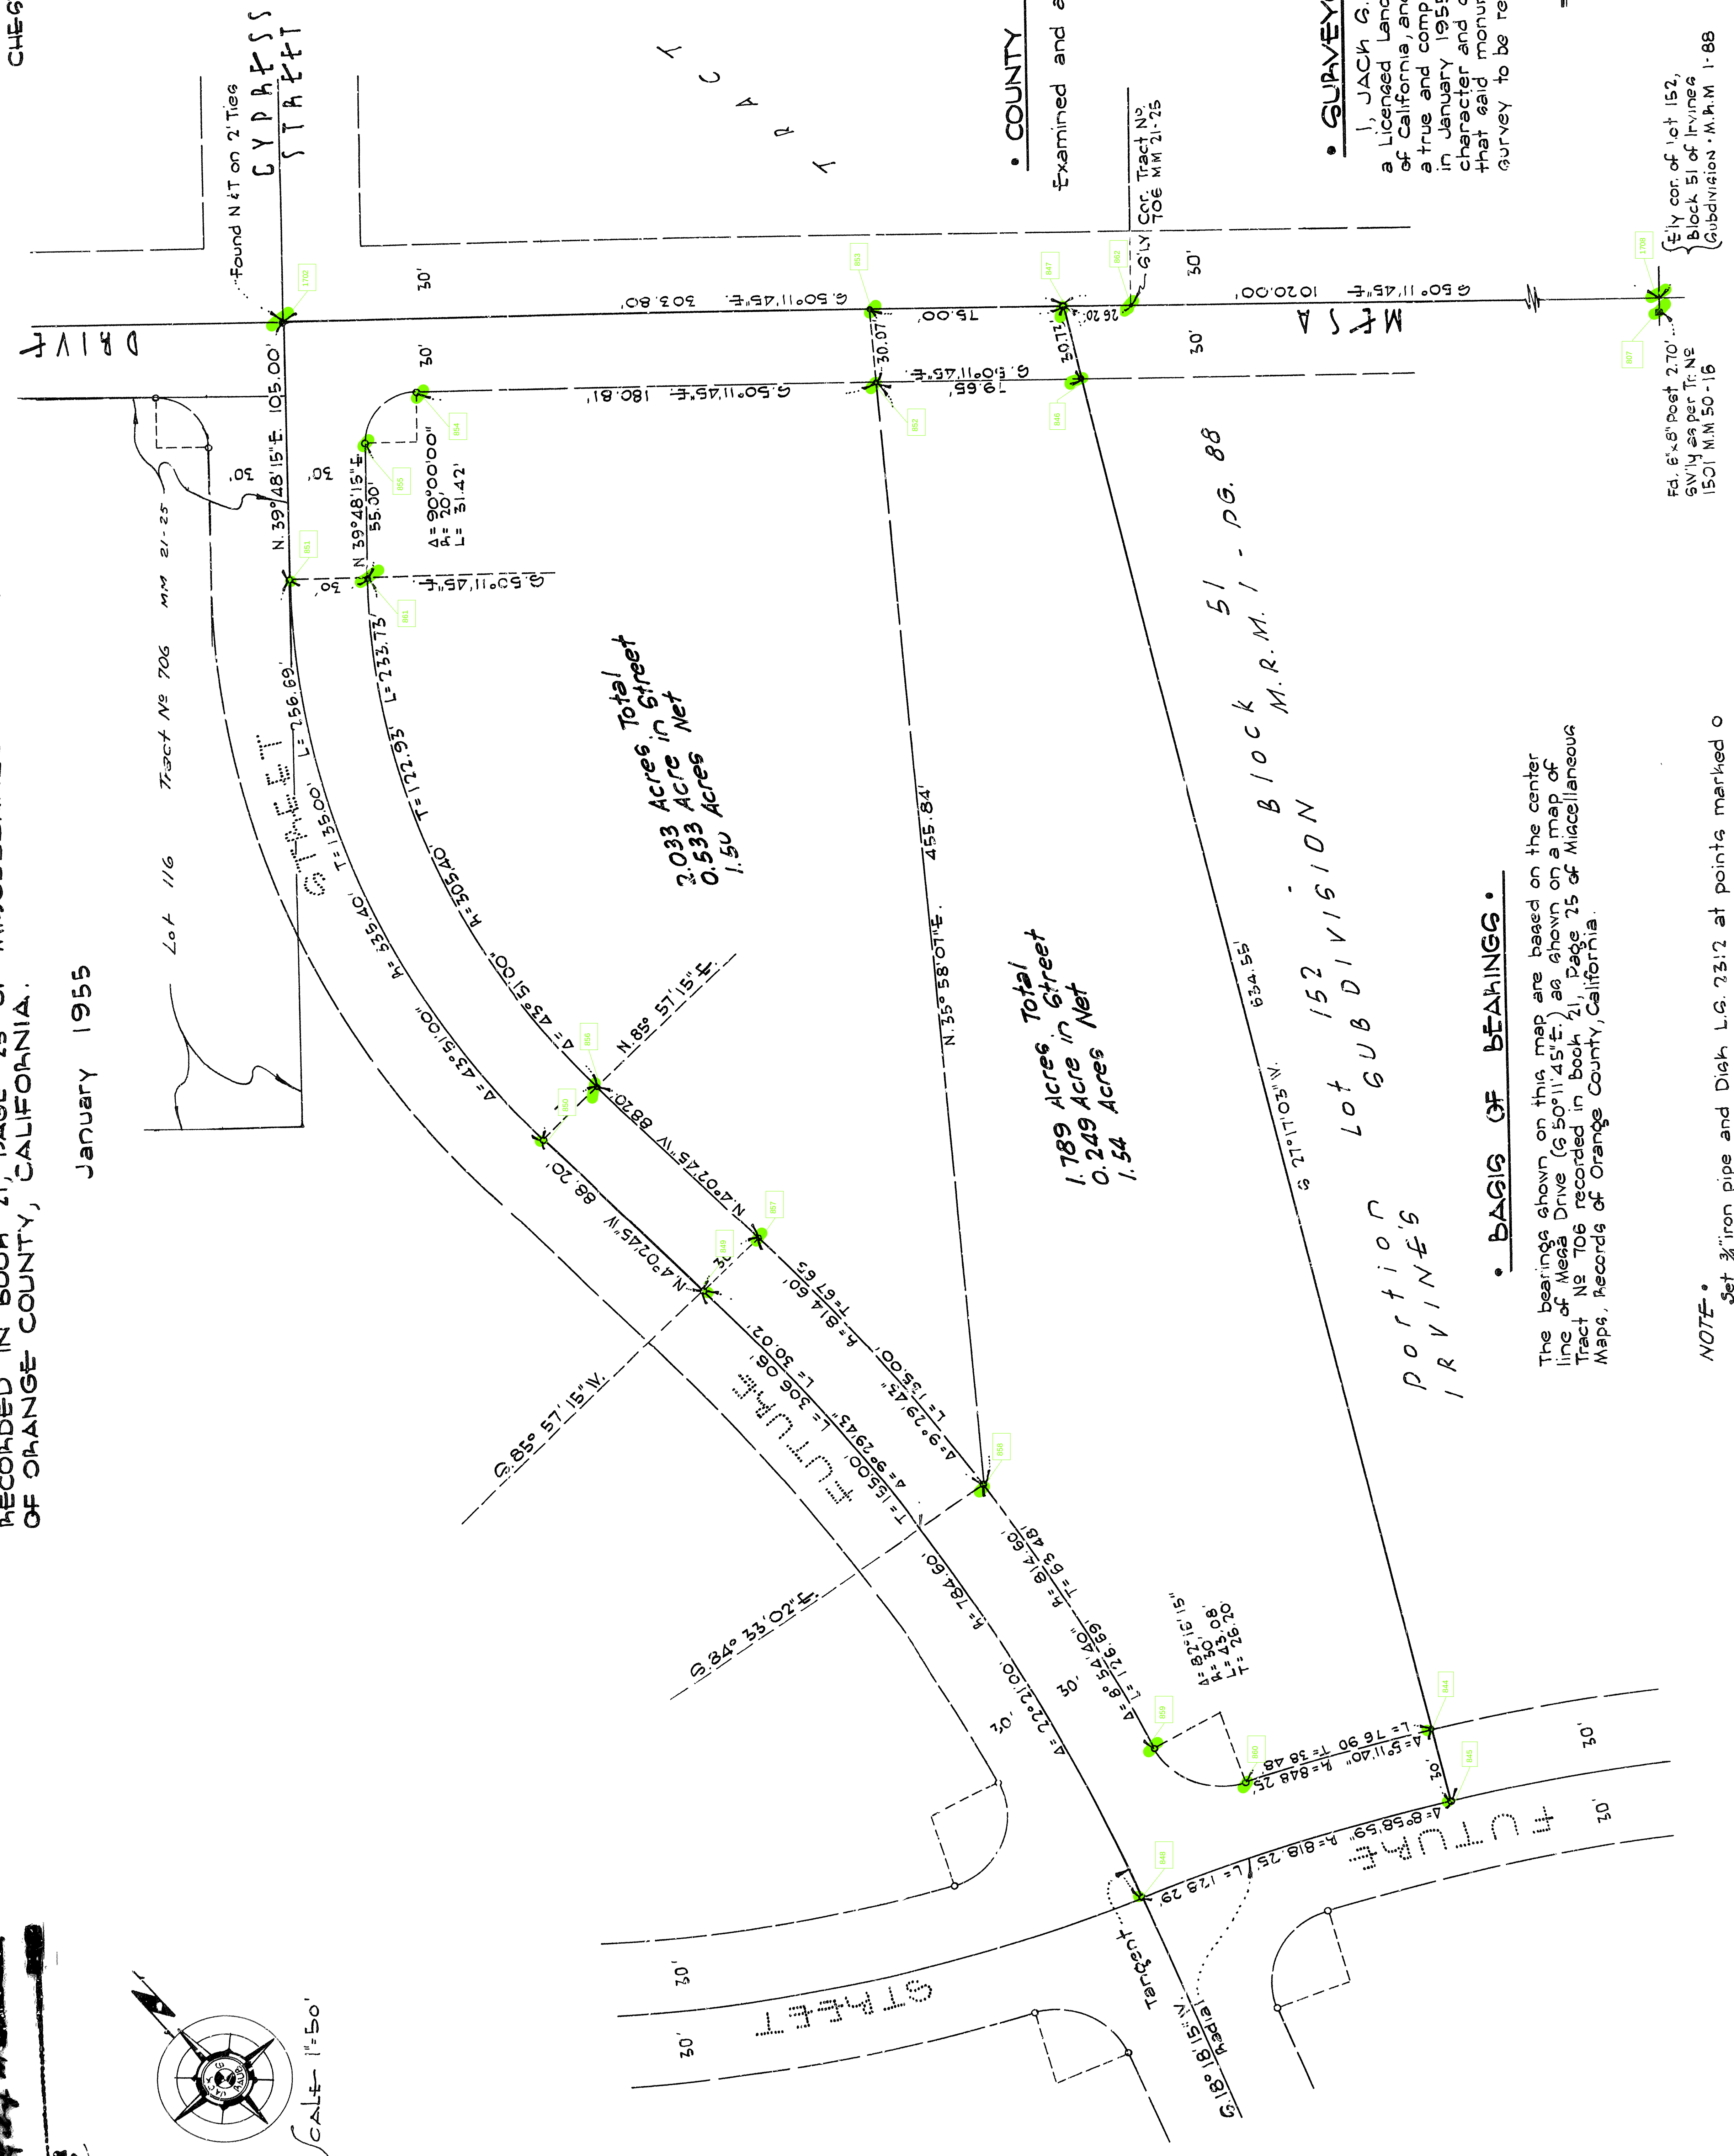

• COUNTY SURVEYOR'S APPROVAL •
Examined and approved this 10 day of Feb. 1955.

Allen A. Roth
County Surveyor

• SURVEYOR'S CERTIFICATE •
I, JACK G. HAUB, hereby certify that I am a Licensed Land Surveyor, No. 2312, of the State of California, and that this map correctly represents a true and complete survey made under my direction in January 1955, that the monuments indicated and character and occupy the positions indicated and that said monuments are sufficient to enable the survey to be retraced.

Jack G. Haub
Licensed Land Surveyor

• BASIS OF BEARINGS •
The bearings shown on this map are based on the center line of Mesa Drive (S 50° 11' 45" E.), as shown on a map of Tract No. 706 recorded in Book 21, Page 25 of Miscellaneous Maps, Records of Orange County, California.

Ed. 6-8 Post 270
Subdivision M.M. 1-88

NOTE -
Set 3/4 inch iron pipe and Dial L.G. 7312 at points marked o