OCPW SURVEY DIVISION

GAUGE AND WELL LOCATIONS Date: 1-20-26

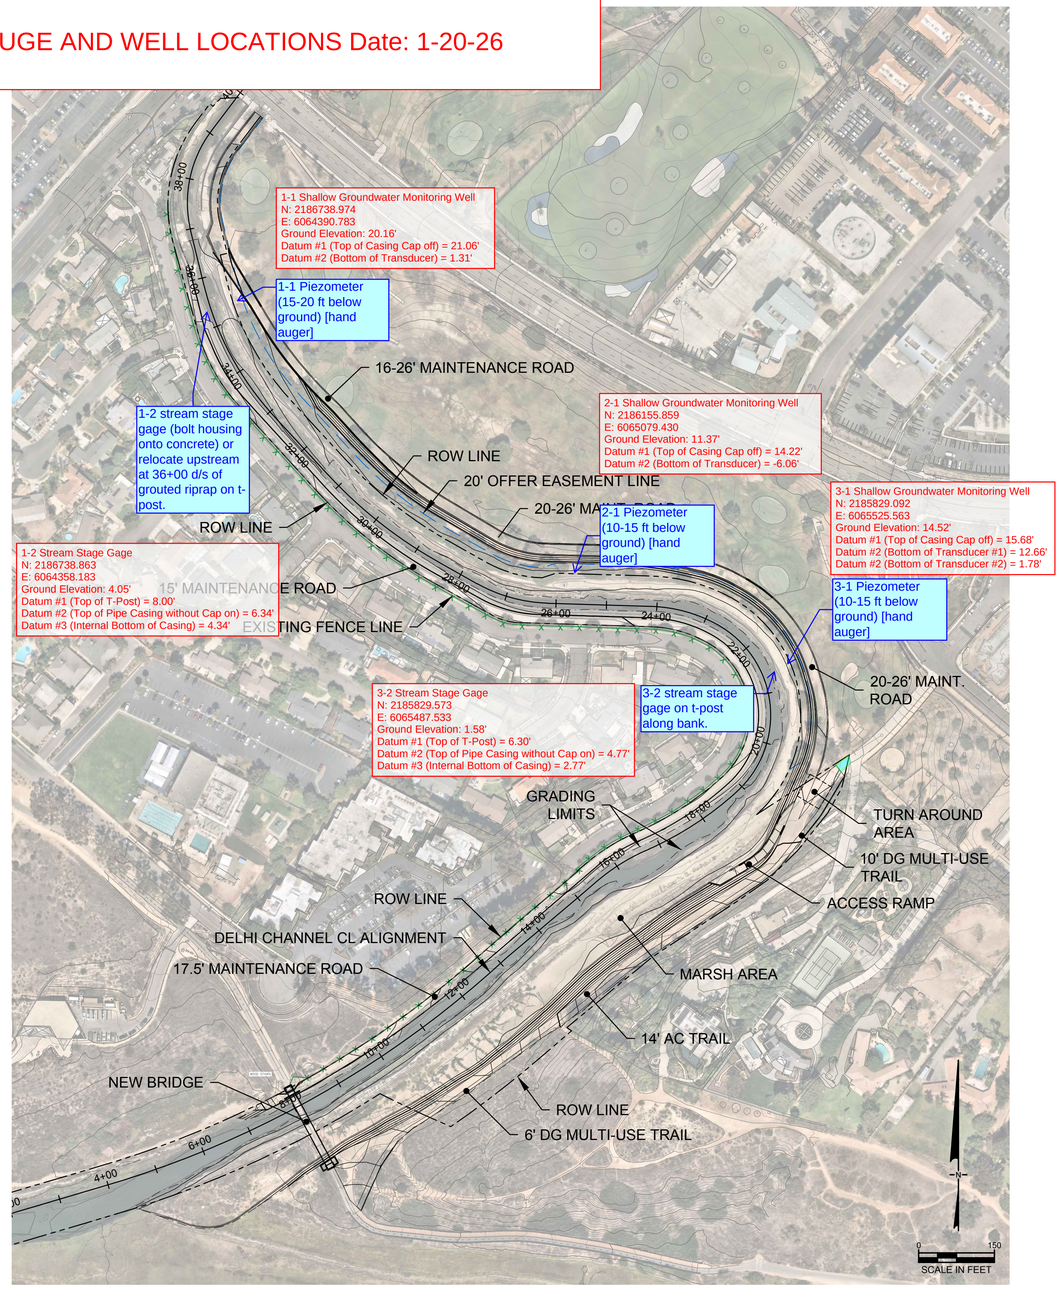

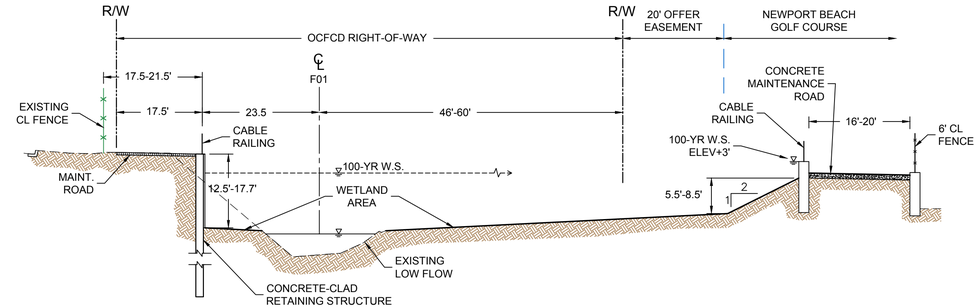

UPPER SEGMENT (STA. 19+75 TO 36+80)
NTS

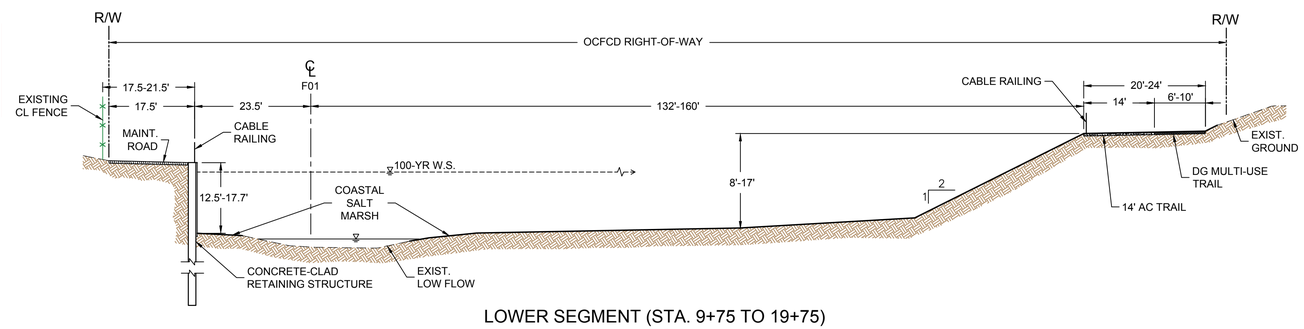

LOWER SEGMENT (STA. 9+75 TO 19+75)
NTS

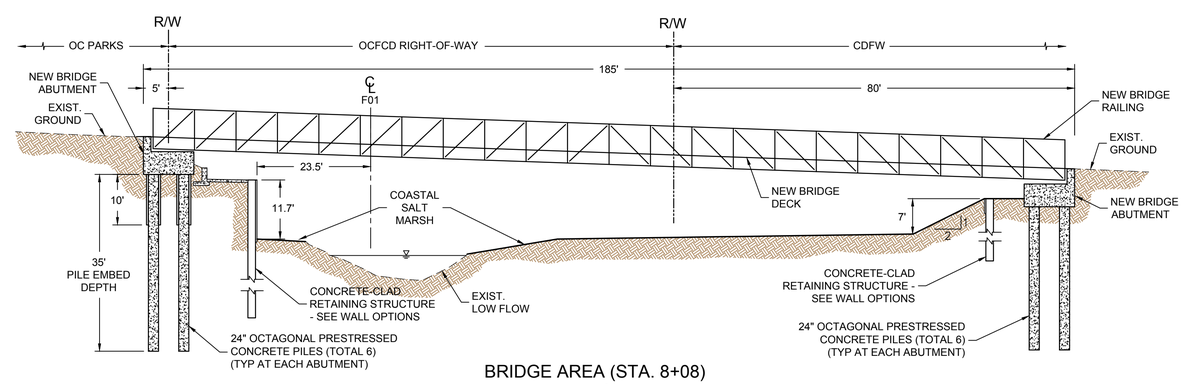

BRIDGE AREA (STA. 8+08)
NTS

OC Public Works	RIGHT OF WAY ENGINEERING DATE: APR 2023	**PLAN AND TYPICAL SECTIONS**
SANTA ANA DELHI CHANNEL (F01) - UPPER NEWPORT BAY TO MESA DRIVE		SCALE: NTS