

CITY OF SANTA ANA

CENTERLINE TIES

EW

DS ✓


BH

BK 10

PG 36

DATE 8-26-9

FOREST AVE & ALTON AVE

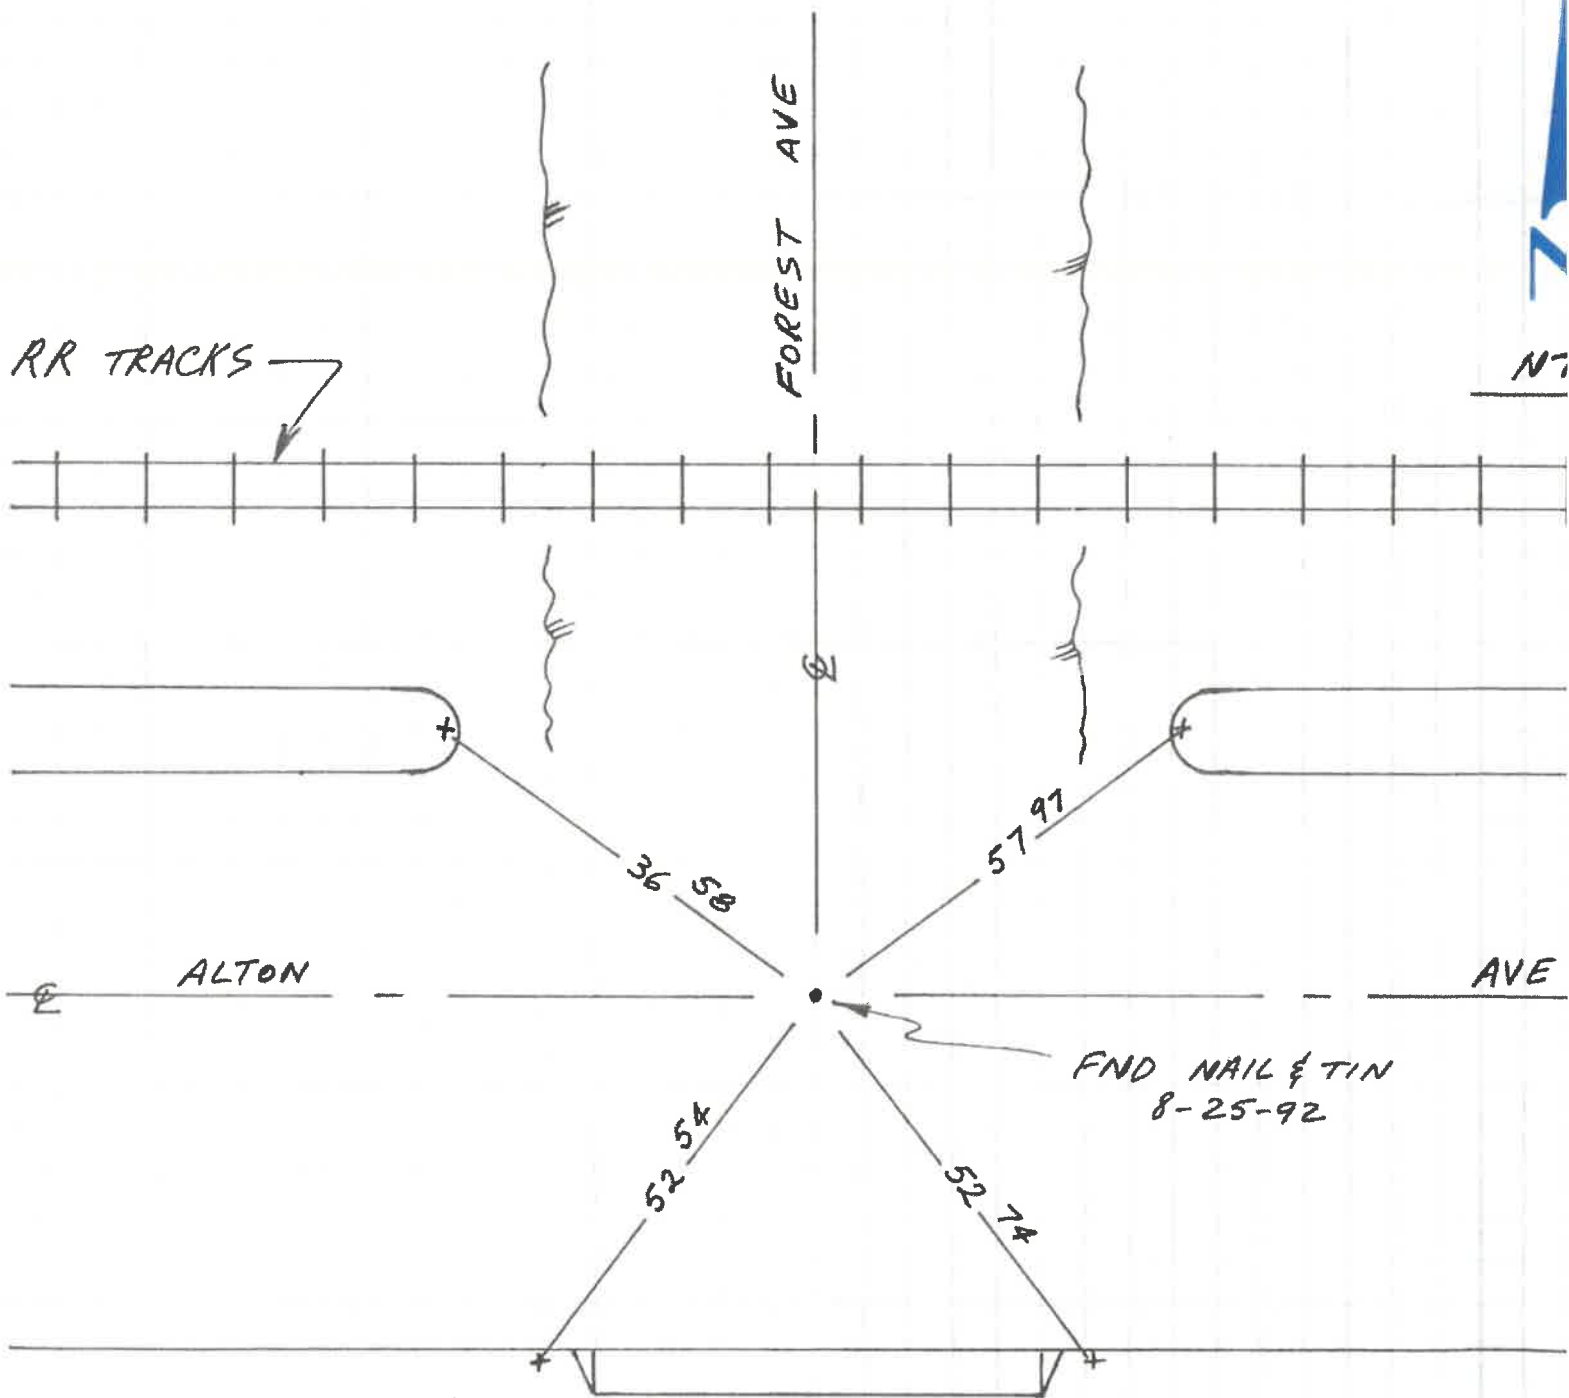

LEGEND:

"+" CHS'LD IN TC