

CITY OF SANTA ANA


CENTERLINE TIES

DRAWN BS
DS

BK 3
PG 92
DATE 4-5-93

FOREST AVE & HARVARD ST
KNUCKLE

SEE CSA TIE
BK 3 PG 91

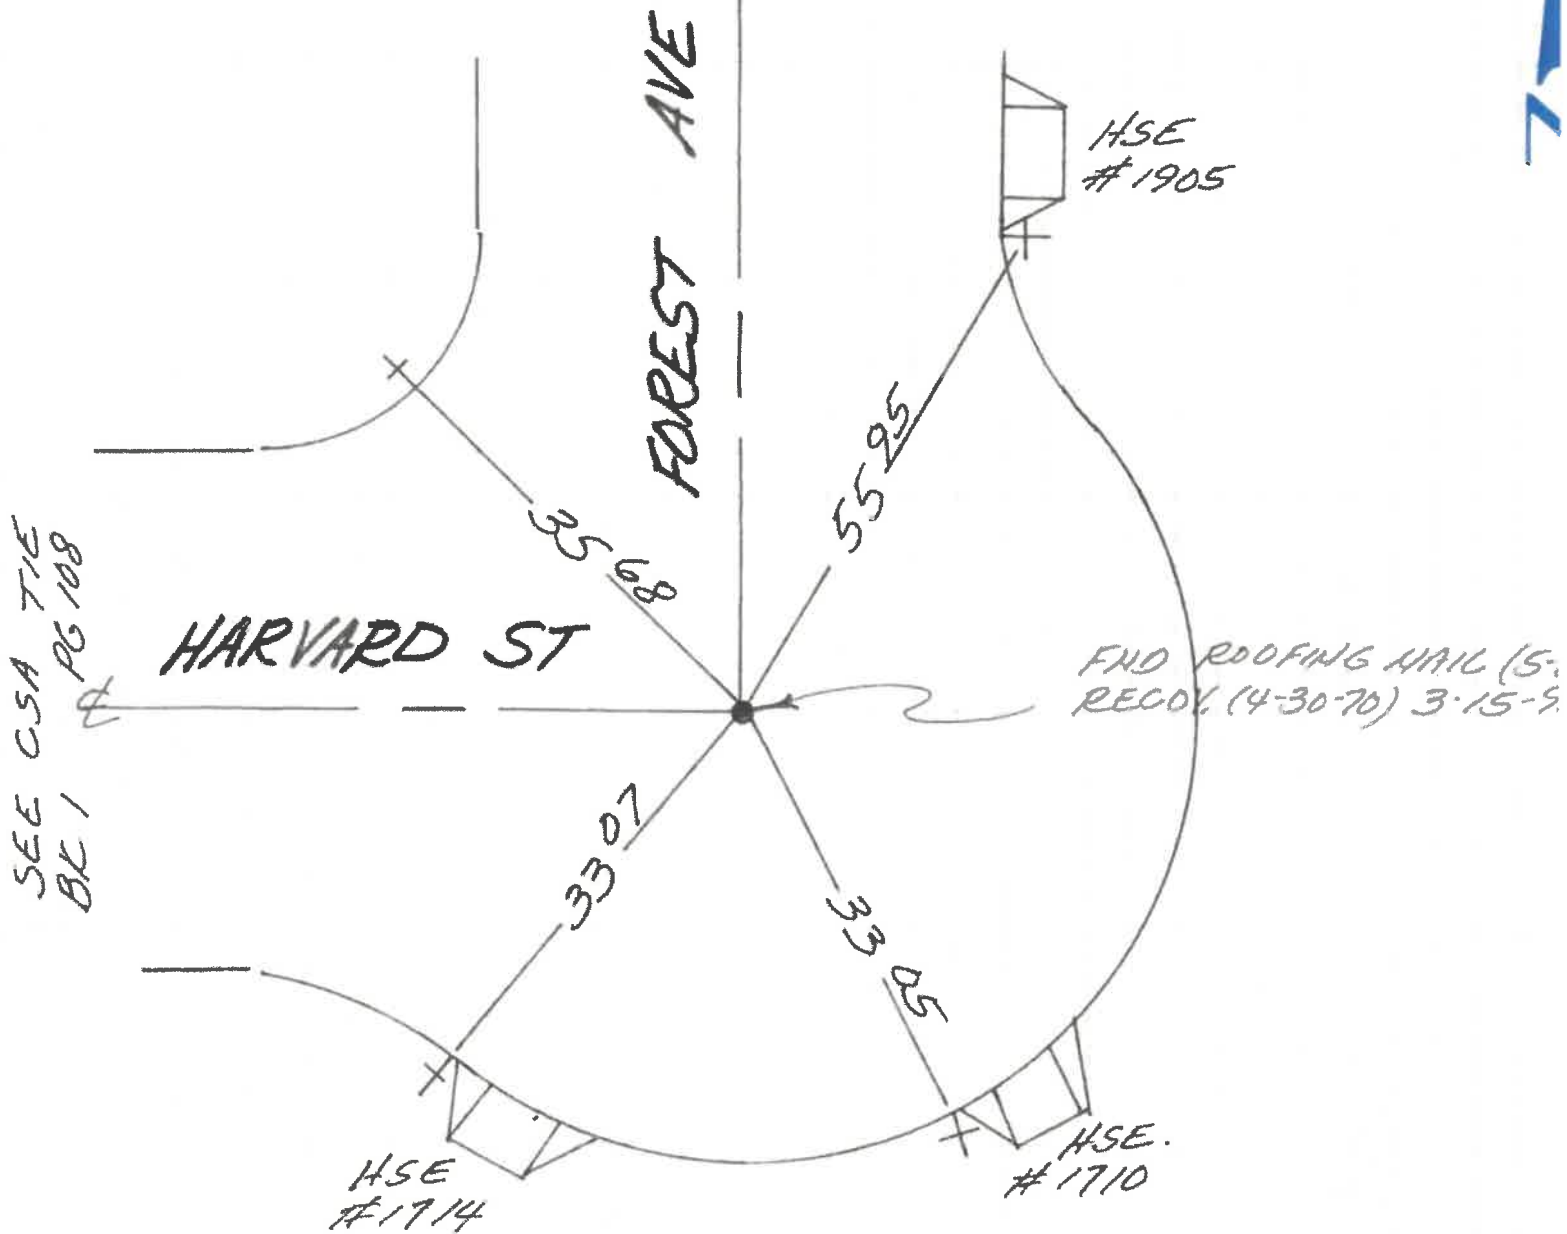

LEGEND

"+" CHISL'D IN T.C.