


TRACT NO 3541

JOHN SIEGEL & CO
1-24-61

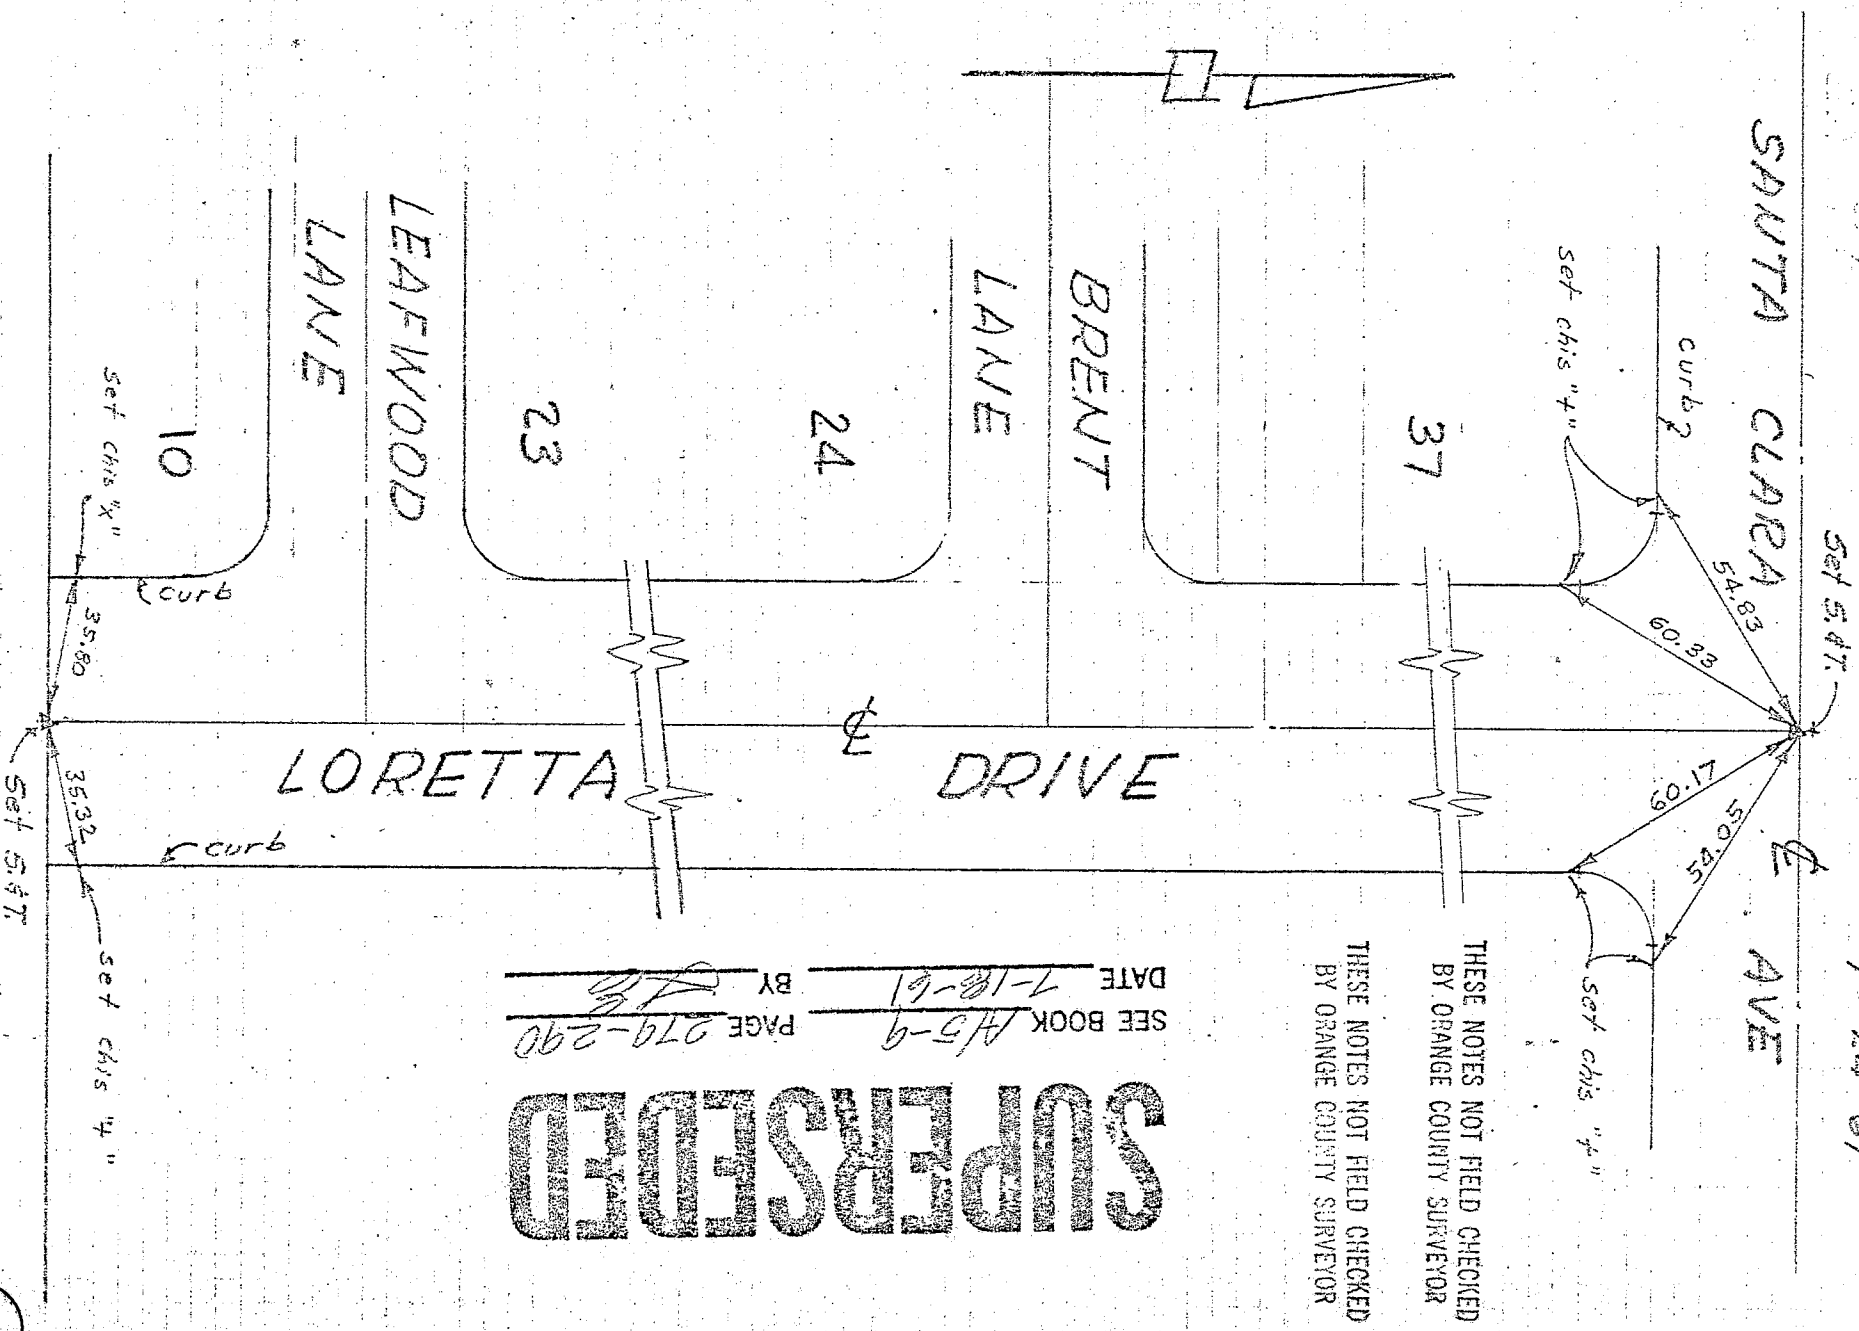

THESE NOTES NOT FIELD CHECKED
BY ORANGE COUNTY SURVEYOR

THESE NOTES NOT FIELD CHECKED
BY ORANGE COUNTY SURVEYOR

SEE BOOK A-5-9
DATE 7-18-61
PAGE 279-290
BY *[Signature]*

SUPERSEDED

TRACT NO 3541


JOHN SIEGEL & CO.
1-24-61

LORETTA

DRIVE

THESE NOTES NOT FIELD CHECKED
BY ORANGE COUNTY SURVEYOR

THESE NOTES NOT FIELD CHECKED
BY ORANGE COUNTY SURVEYOR

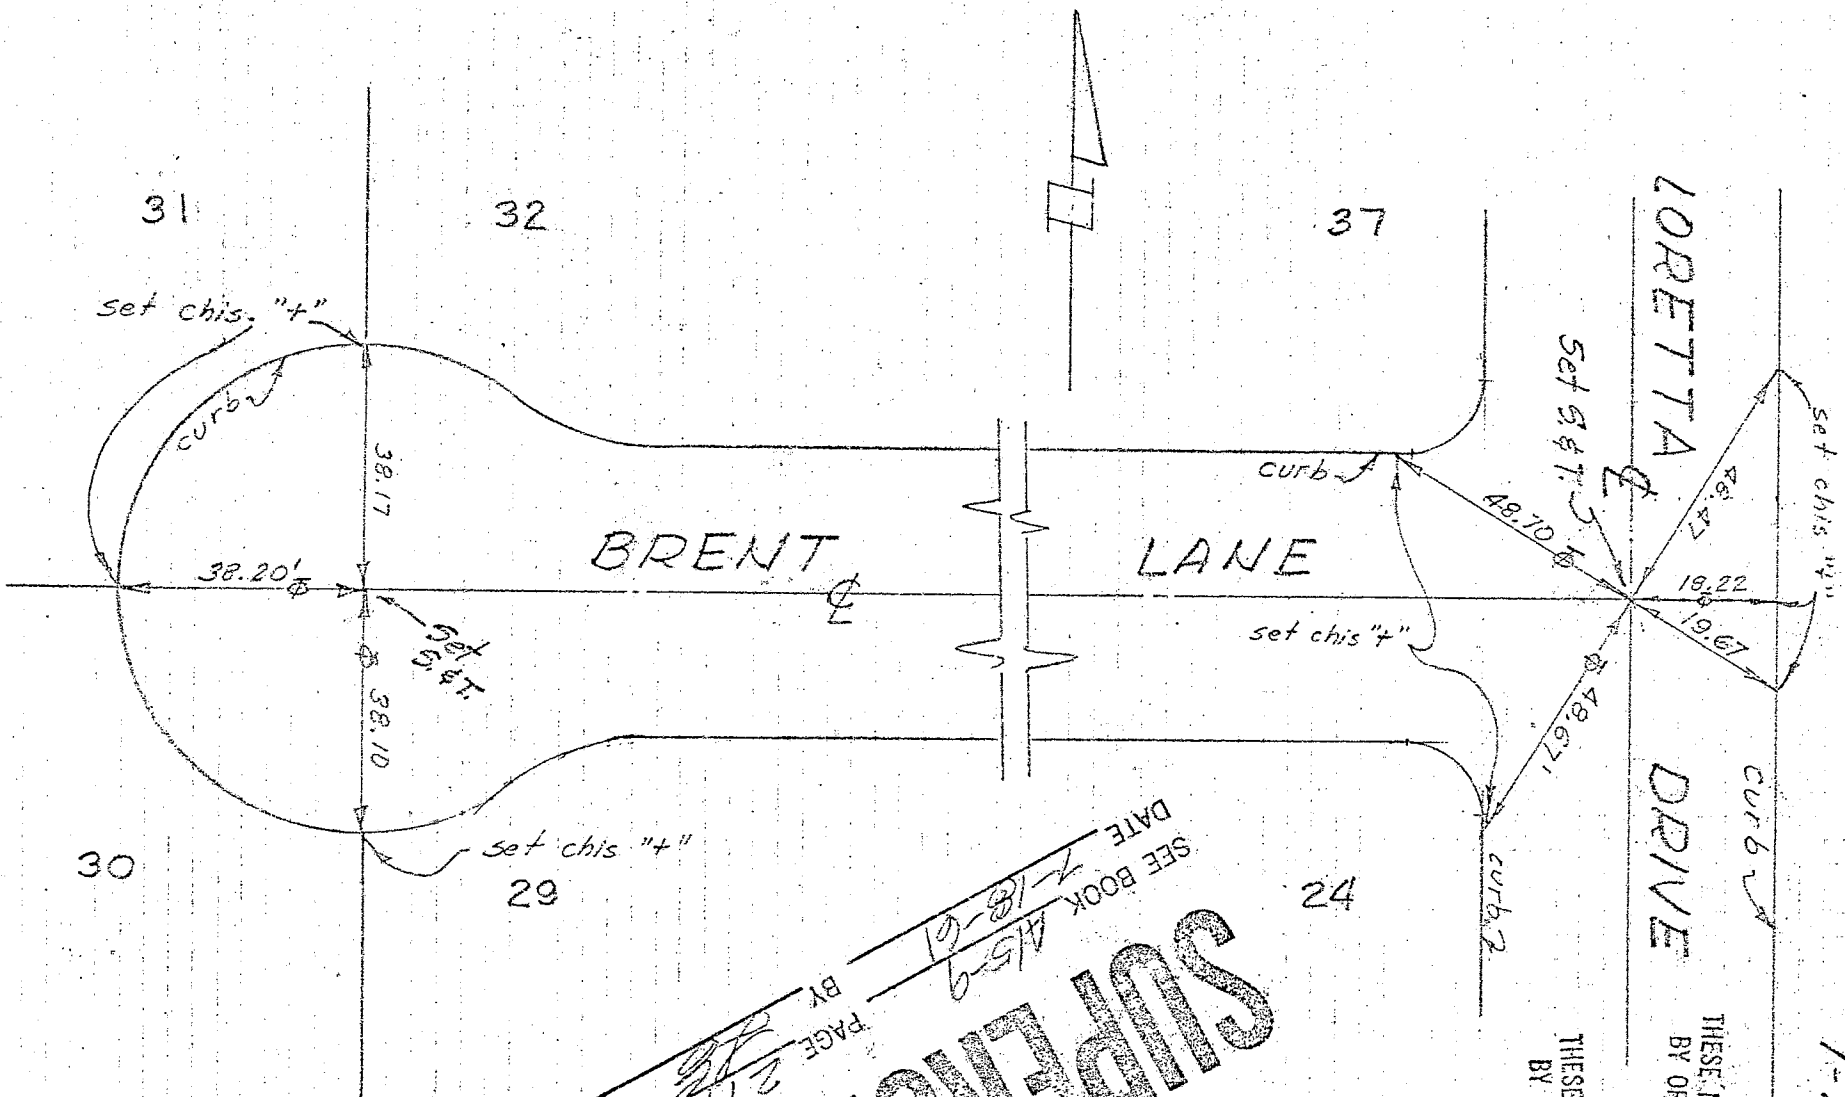

RECEIVED FROM JOHN SIEGEL & CO. 1/61

TRACT NO 3541

JOHN SIEGEL & CO.


1-24-61

LORETTA

DRIVE

23

10

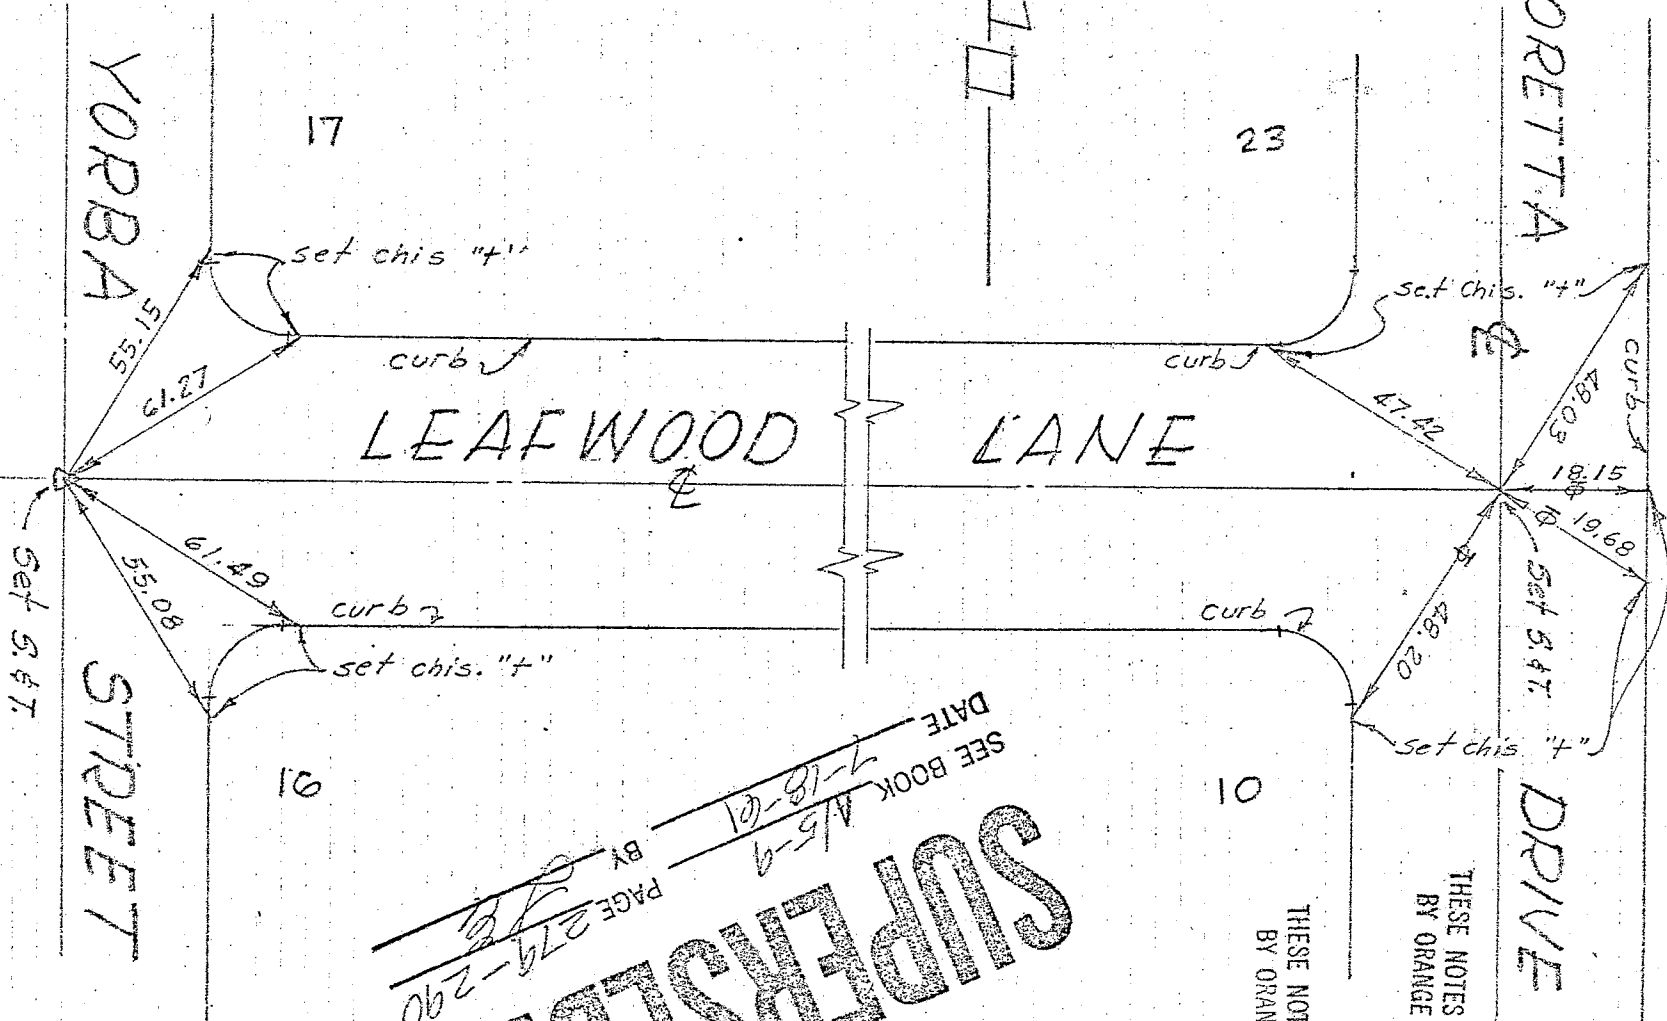


THESE NOTES NOT FIELD CHECKED
BY ORANGE COUNTY SURVEYOR

THESE NOTES NOT FIELD CHECKED
BY ORANGE COUNTY SURVEYOR

SUPERSEDED

SEE BOOK 115-9
DATE 7-18-61
BY [Signature]
PAGE 279-290

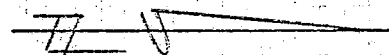

SANTA

CLARA

AVENUE

54.83'

60.31'

60.14'


54.04'

LORETTA DRIVE

LORETTA


CHECKED BY LOPEZ & PTY. DATE JUNE 29, 1961

ORANGE COUNTY SURVEYOR

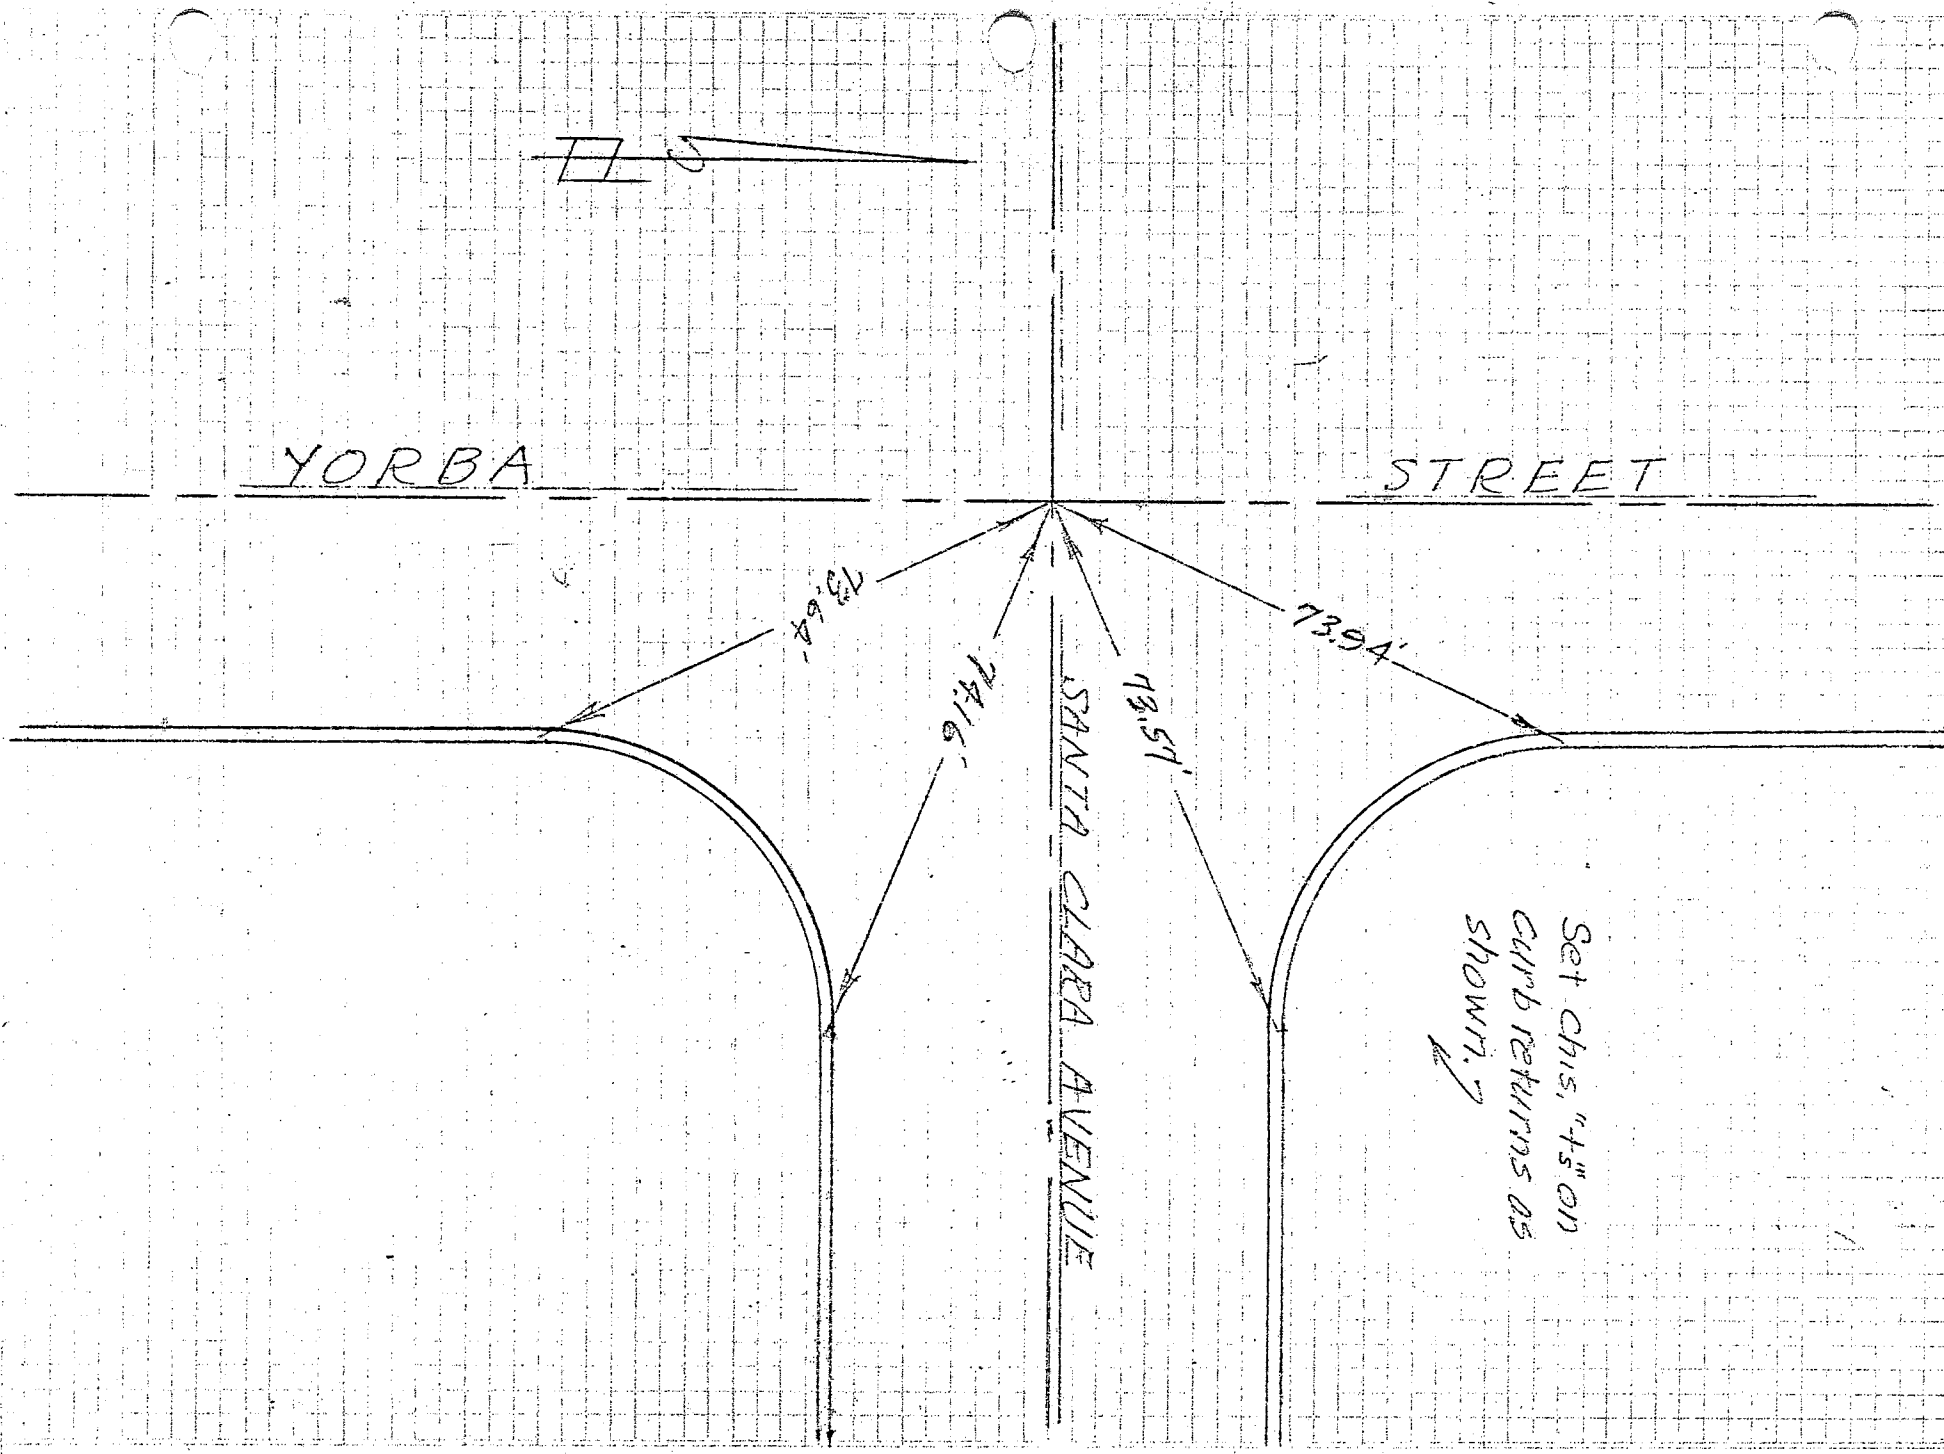

CHECKED BY LOPEZ & PTY. DATE JUNE 29, 1961

ORANGE COUNTY SURVEYOR

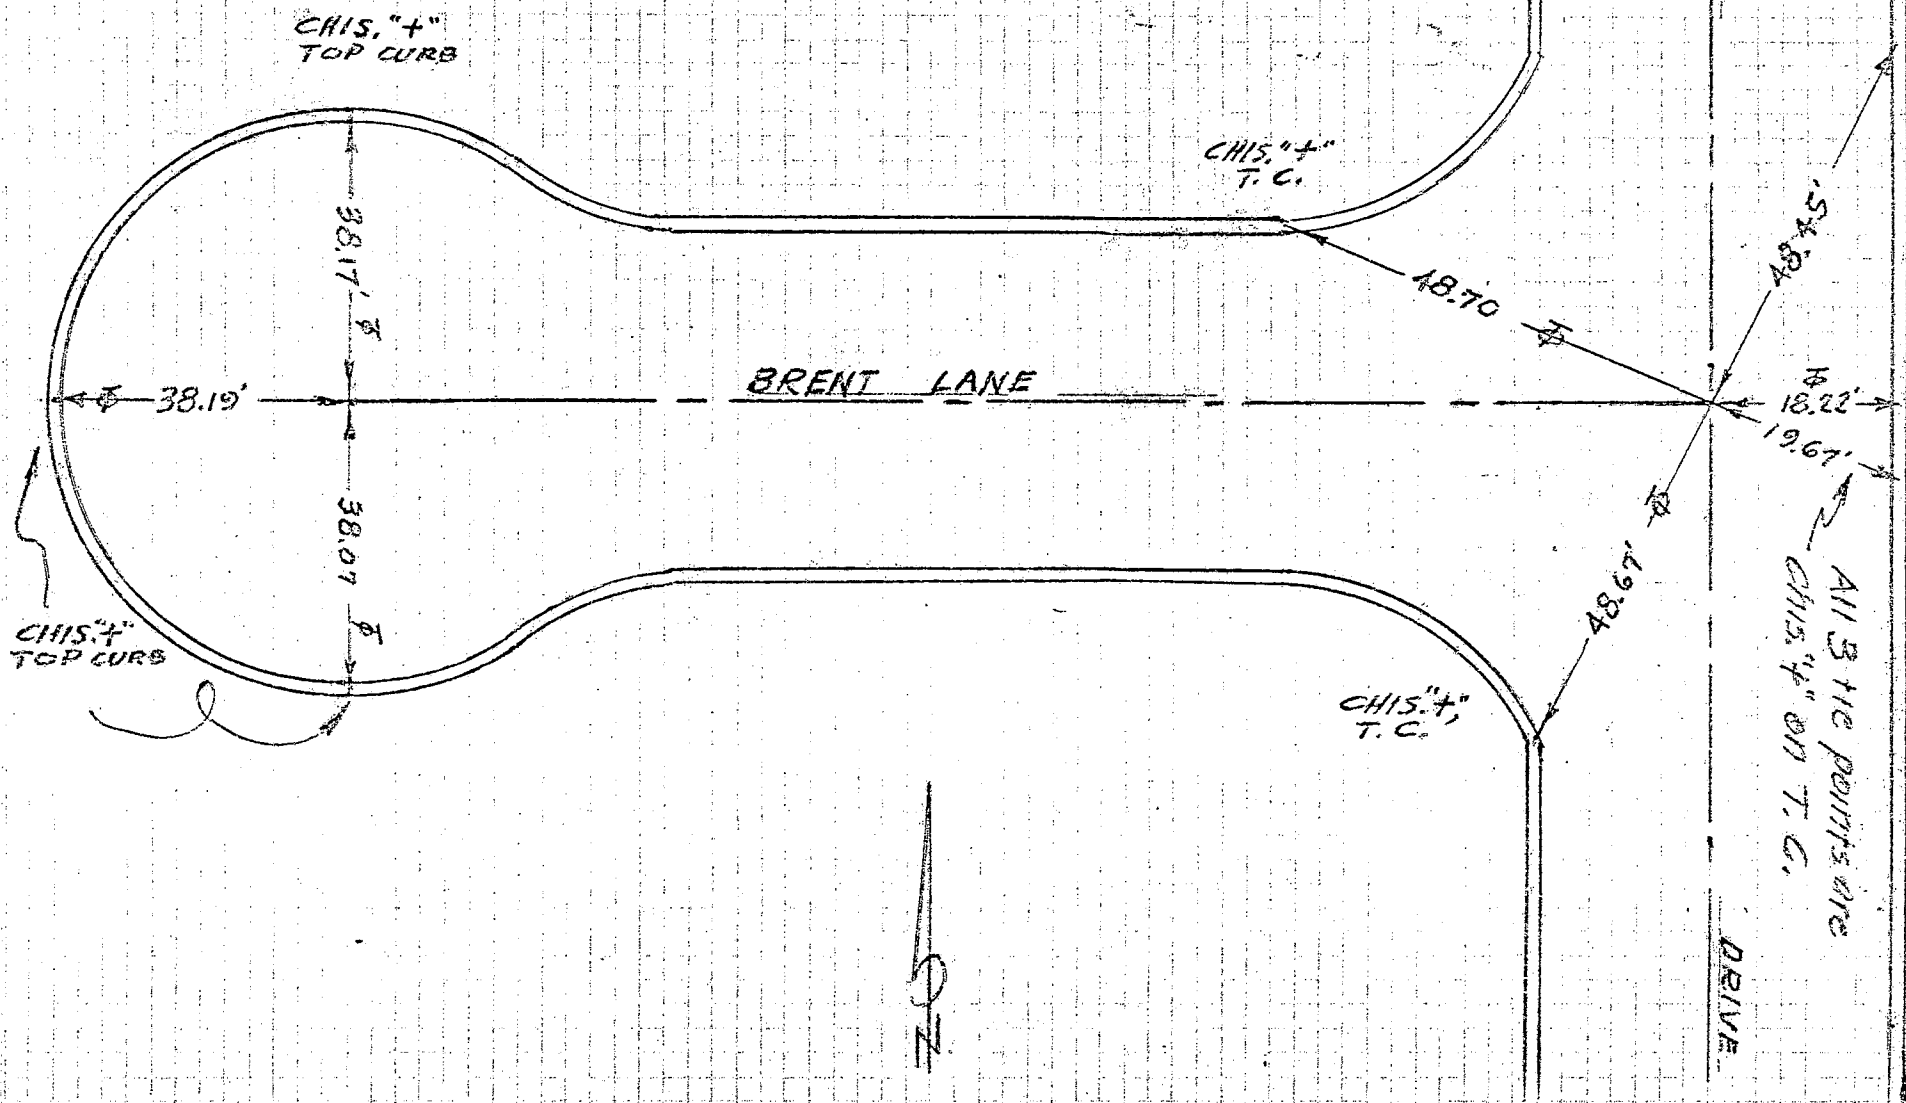

CHECKED BY LOPEZ & PTY. DATE JUNE 20, 1961

ORANGE COUNTY SURVEYOR

RECEIVED FROM NAT NEFF ENG. CO. 8/60

THESE NOTES NOT FIELD CHECKED
BY ORANGE COUNTY SURVEYOR
PAGE 2 of 3

SEE PAGE NO. 1

THESE NOTES NOT FIELD CHECKED
BY ORANGE COUNTY SURVEYOR

NORTH
NO SCALE

DATA


$\Delta = 6^{\circ}16'46''$
 $R = 1000.00'$
 $L = 109.59'$
 $T = 54.85'$

DATA

$\Delta = 6^{\circ}16'46''$
 $R = 1000.00'$
 $L = 109.59'$
 $T = 54.85'$

LEAD & TACKS ARE
SET ON CURBS AS
SHOWN
ROUND HEADED STOVE
POUNTS ARE SET
ON POINTS

SEE PAGE NO. 3

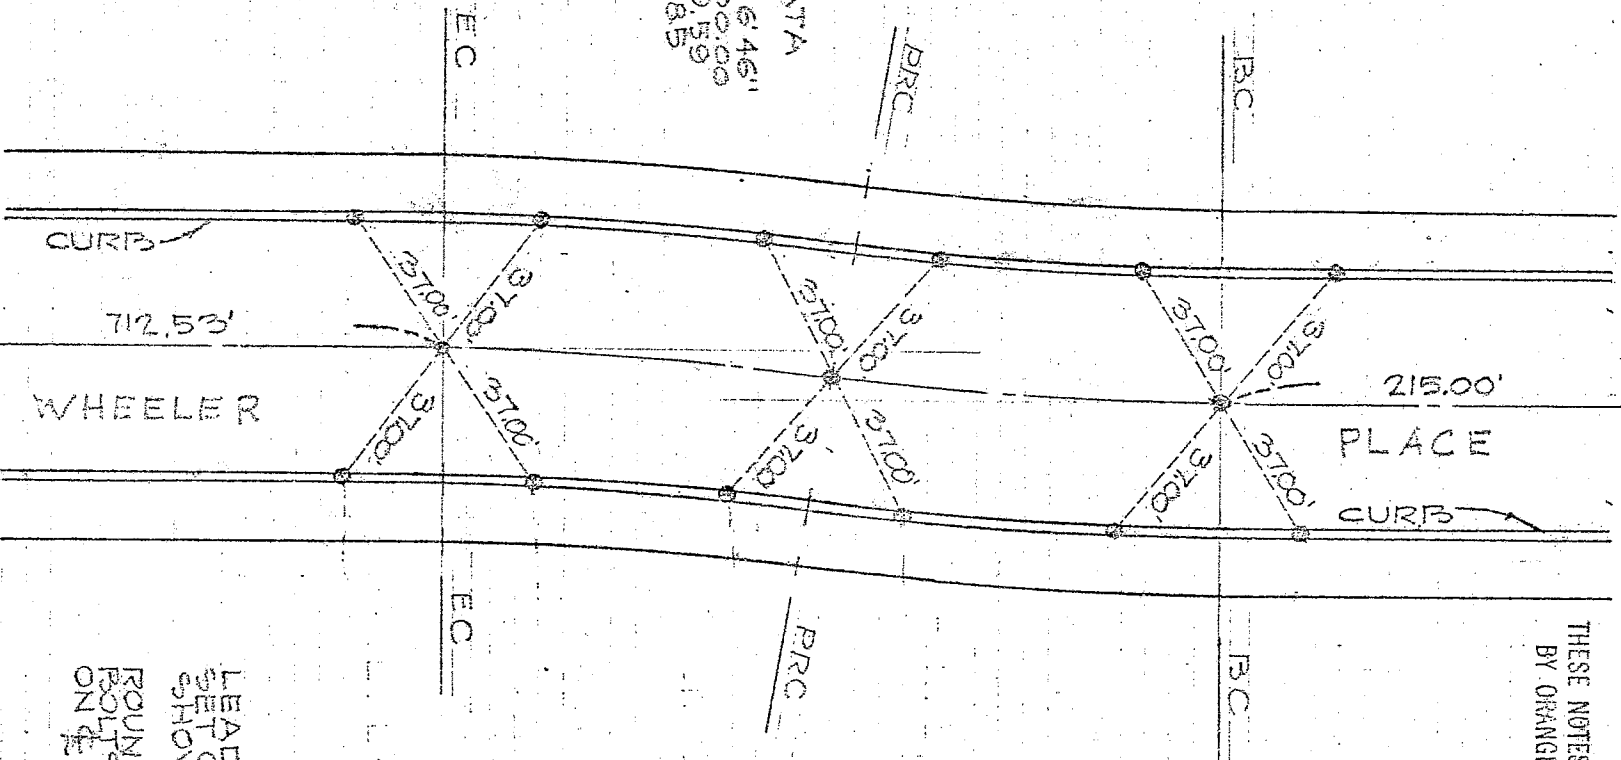

7-4-1

Sub 7997-3

NO. 1997-3 7-4-11
Tree to E. side, yard of Santa Clara Ave.

Sept 10 - 1962

15 Sept 1942

1224 57.16 feet opp. 99

DEIVE

T-256

14

Sta 137+00.00
Santa Clara

Inte. yerba & Santa Clara

POWER

PK-172-6197

50K-171612

236

SURVEYED BY

DATE

ORANGE COUNTY SURVEYOR

THE NOTES
TRACT NO. 8490
TUSTIN, CALIFORNIA
MAY, 1976


SHEET 1 OF 3

WM S. CHURCH
CONSULTING CIVIL ENGRS. INC.
2000 DOVE, NEWPORT BEACH
FEB 2, 66 & 67 L.N. 663-11

ALL & MONUMENTS ARE SPIKE AND
WASHER

ALL TIE POINTS ARE LEAD & TACK
IN TOP OF CURB

N
SCALE

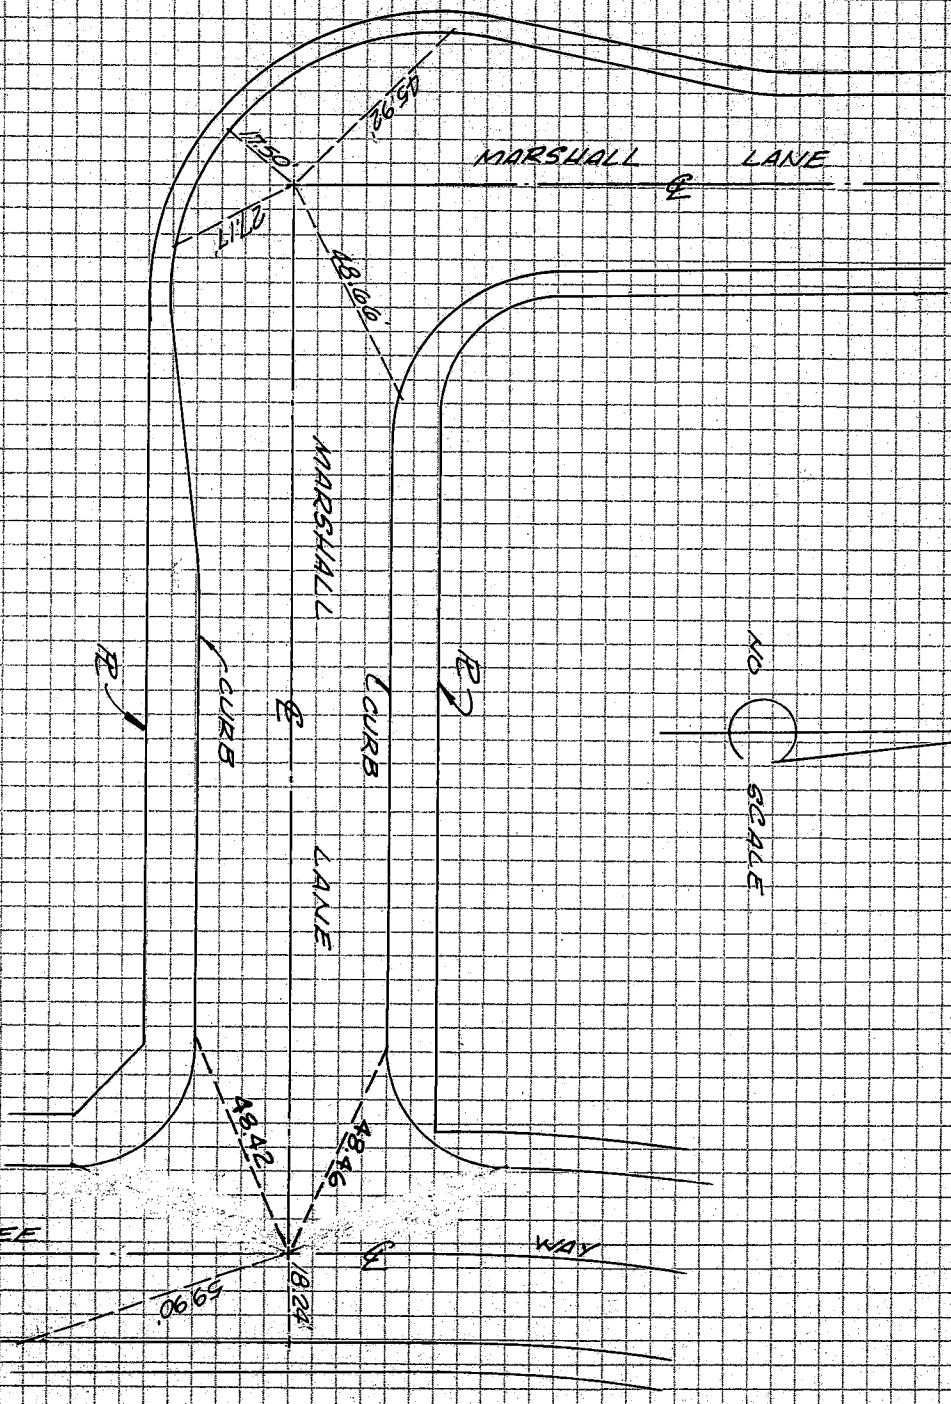

ETHEL BEE

WAY

426

BLK 5852 MOD 50

2

ORA 55
07-207-186000
SP#69-0215

Ties to Pt #52, 53 & 54
BC, PRC & EC Carroll Way
See Pg #20 for align.

1-14-70
J. PETERSON & PT
L. HULS-

74

Pt #52 = P.O.T. &

Set "C" & Bn CDH Tag

Legend


+ = Fd Ch "T" in T.G. per &
Ties notes to Tract #5726

Index

- ① 4.21 M
- ② 4.89 M

Pt #54A = EC Carroll Way

Fd Rd Hd Spk & Tin No rec'd
Tract Map #5726 calls for
Spk & Washer

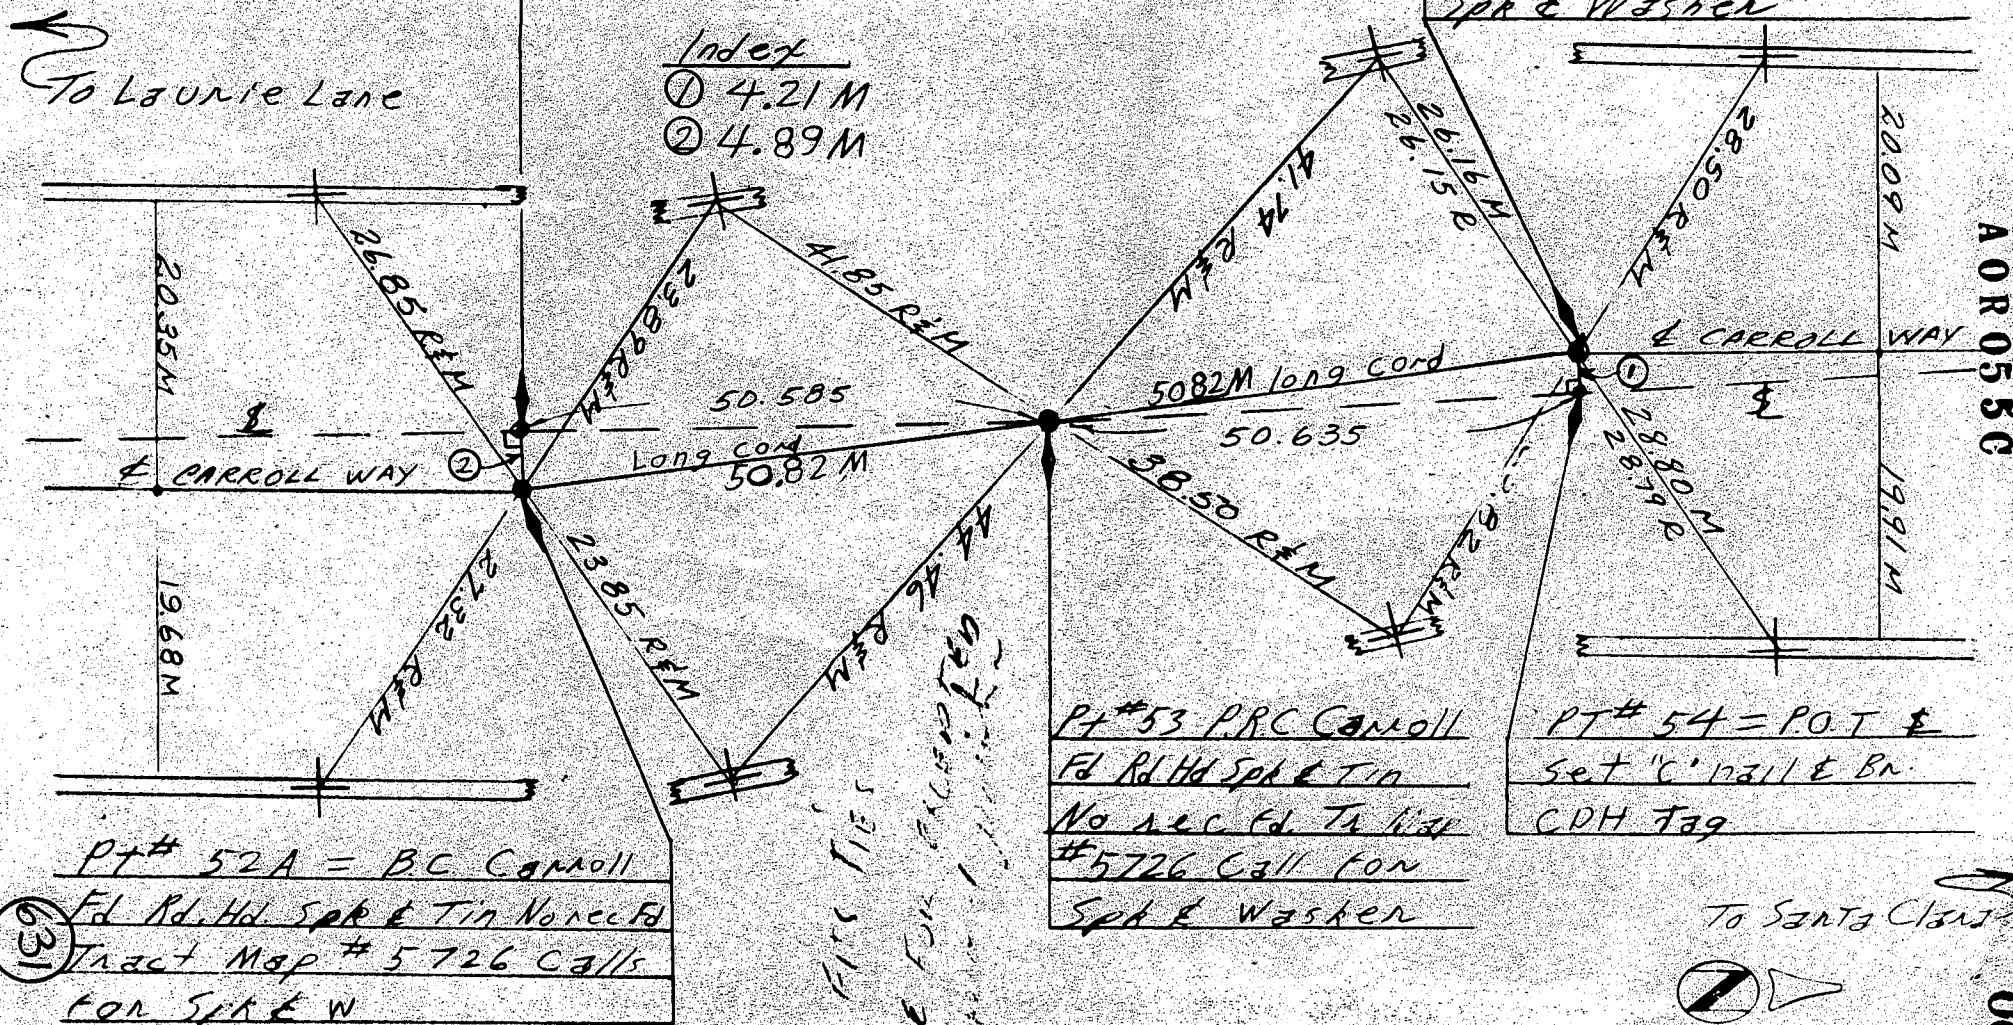

URA 55

07-207186000
SR #610215


INTERSECTION TIES.
SEE PAGE #20 FOR ALIGN.

BLK 5852 MD 50

(2)

J. PETERSON & PTY. Pg # 75 of

Recorder B. Holloway Date Jan, 1970

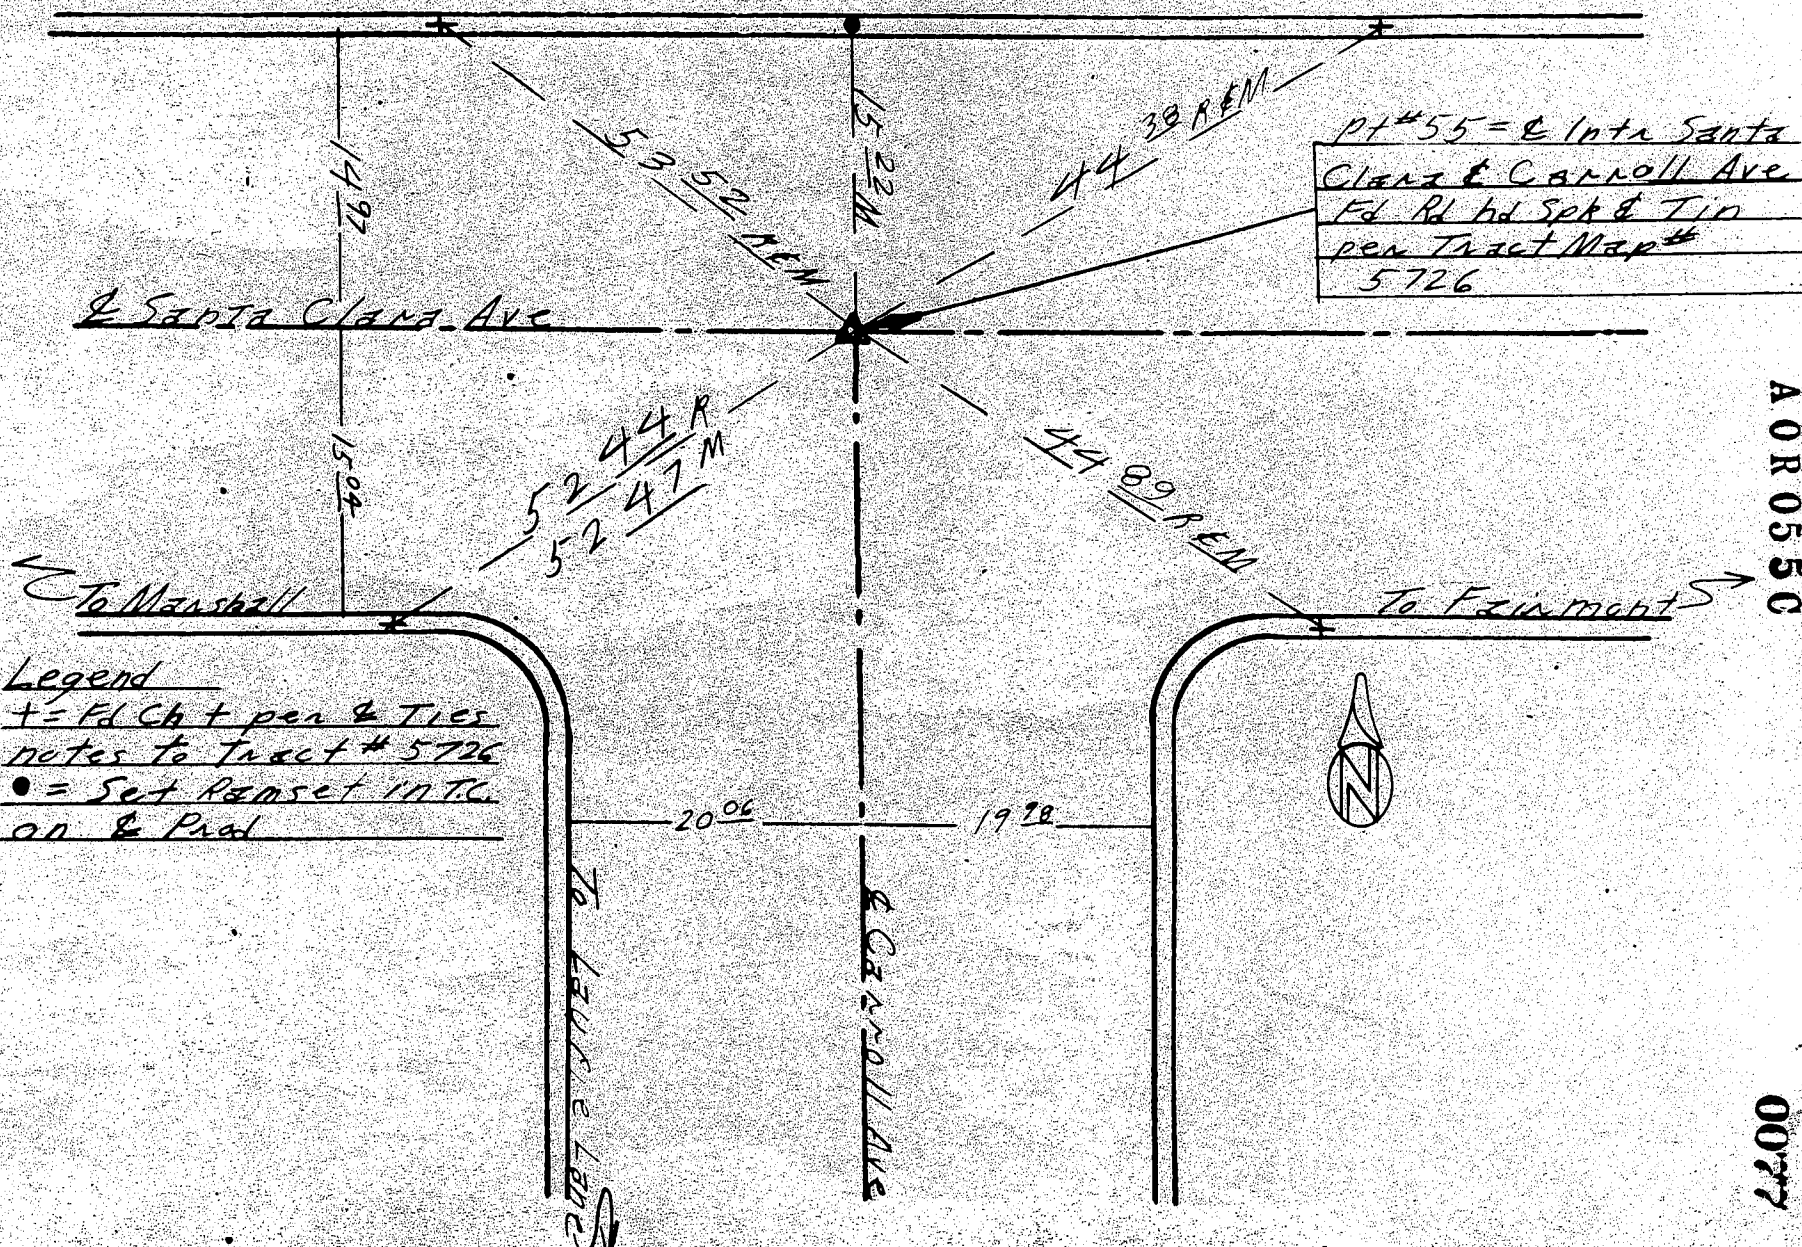

ORA 35
07-027-186000
SR 69-0215


2 Ties to Pt # 55B
4 Pt & Santa Clara Ave
See Pg # 20 for

1-14-70
J. E. ...
L. Hulse

Legend
+ = Fd CH "+" in T.C. per
& Tie Note to Tract # 5726



Pt # 55A = P.O.T. &
Set "C" nail & B. CDH Tag

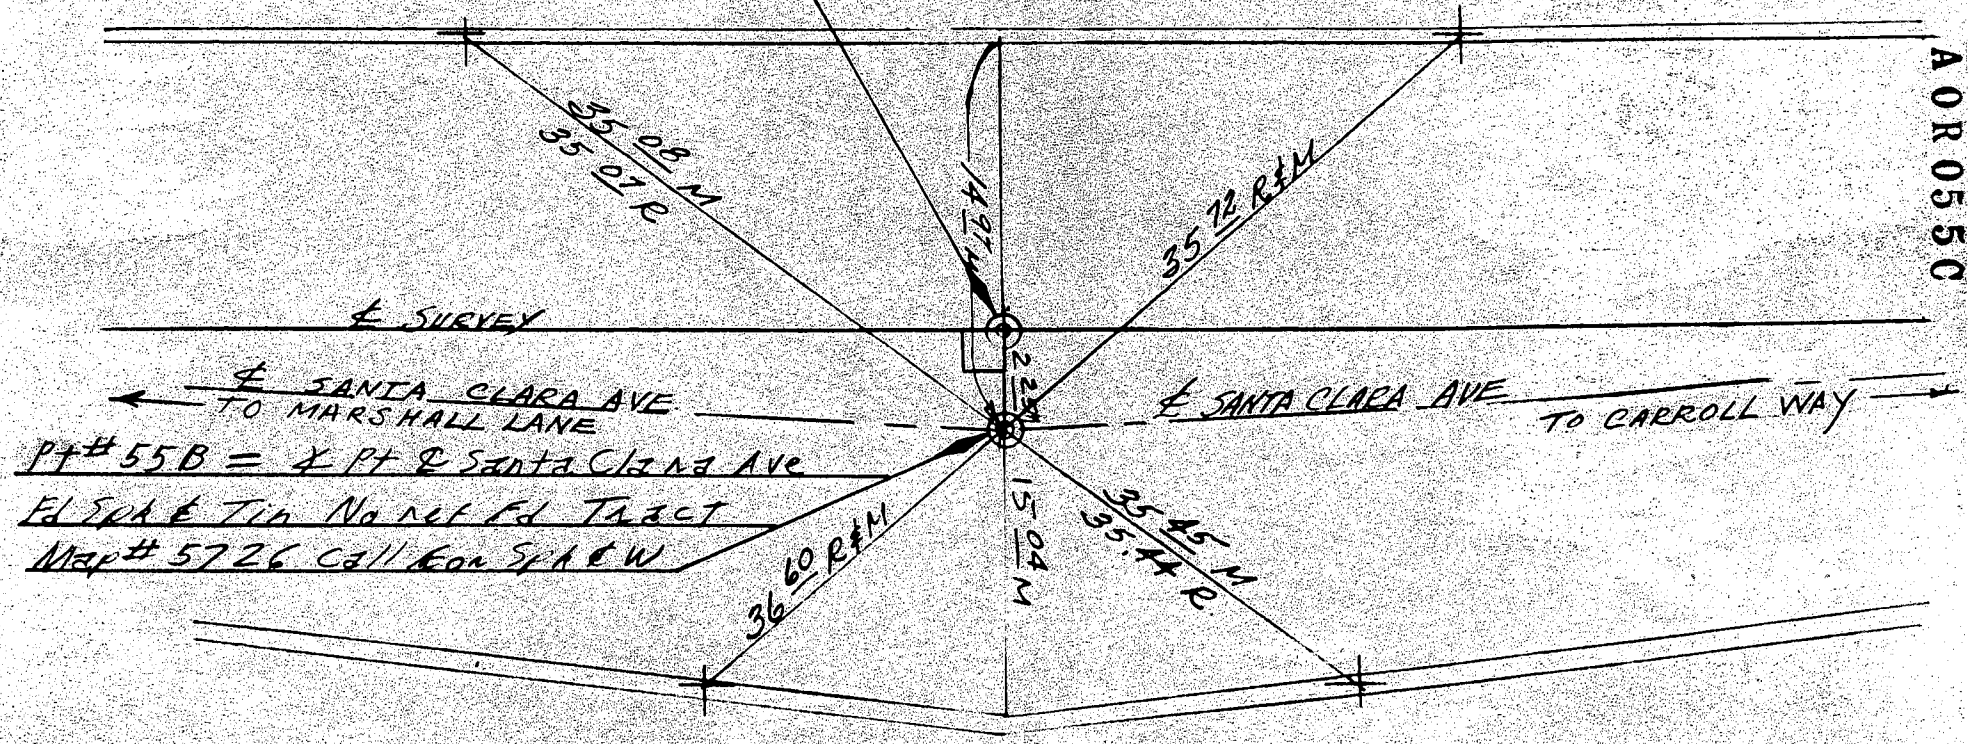

633
2

②

**INTERSECTION TIES
SEE PAGE # 20 FOR ALIGN.**

Pg. # 27 of

L. H. L.

Date 1-14, 1970

07-207; 186-000
SR# 69 0215-

Pt #56 = 2 Intra Marshall Loop
 & Santa Clara Ave Fd bent
 Sph & Tin. replace with R/R
 Sph by pulling rec ties per
 & Ties Notes to Tract # 5726
 To MRP call for Sph & washen

MARSHALL LANE

TO LAURIE LANE

Legend

- = set Ramset in TC on $\&$ Prod


$$= F_d C_h + C_A T.C. \text{ per } \text{¢}$$

Tie notes to Tract # 5726

AOR 0550

COOL

(634)

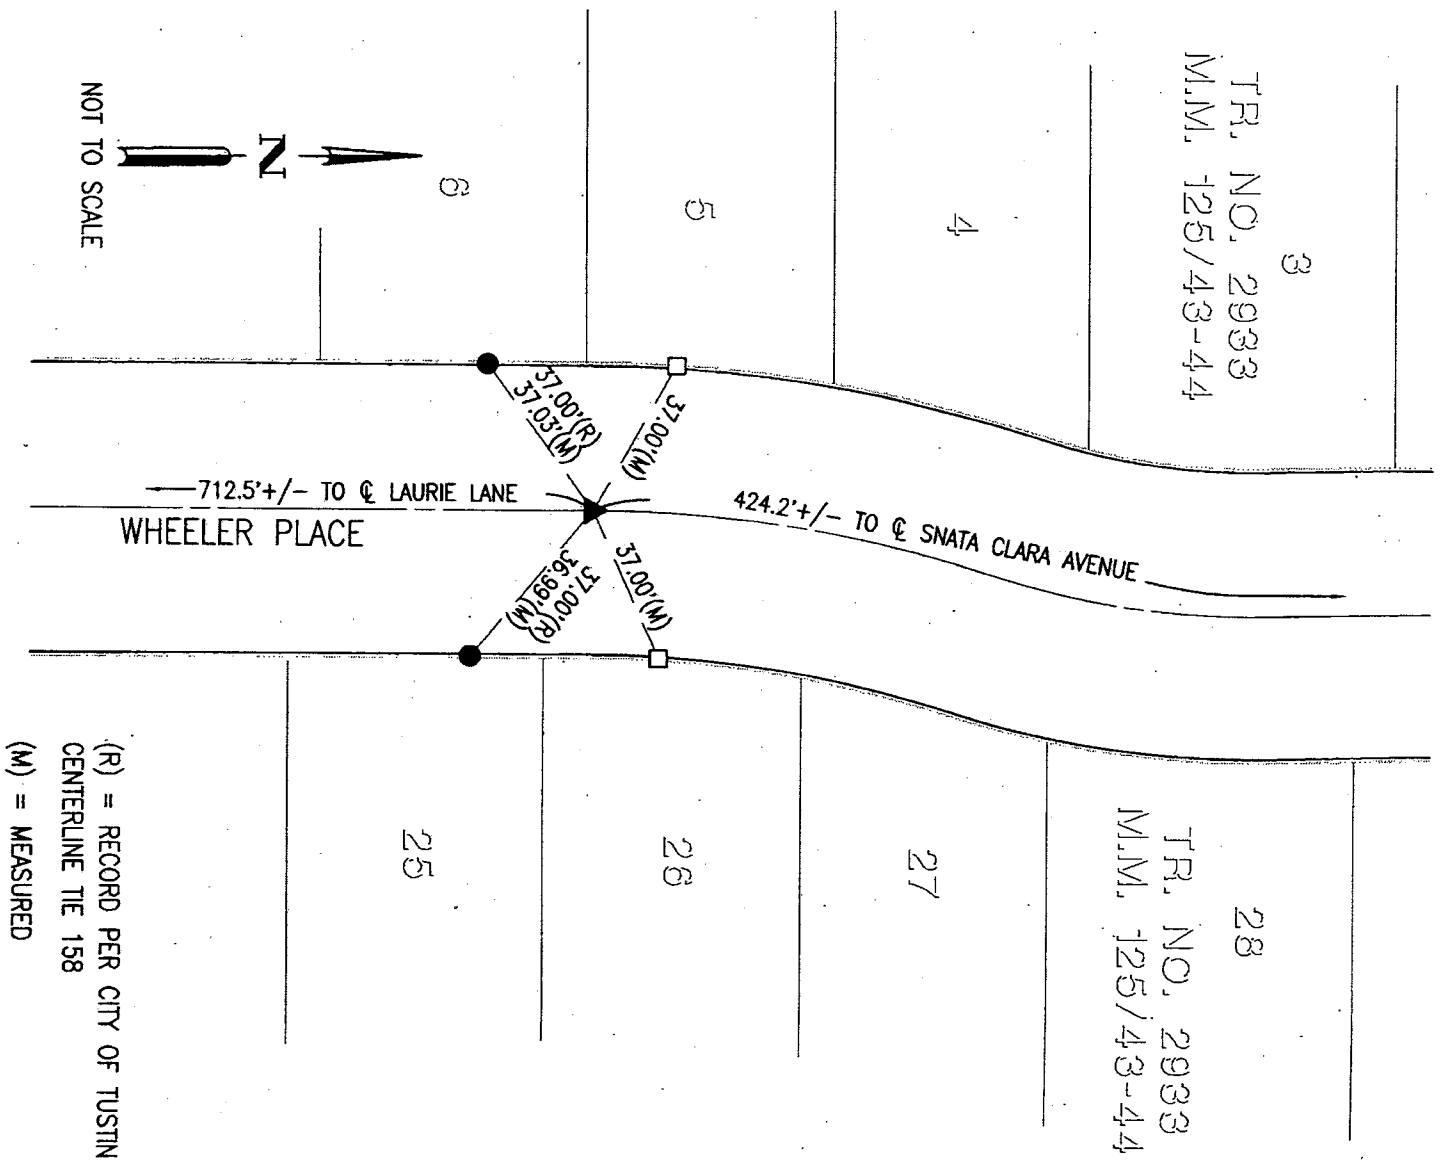

- ▲ FOUND SPIKE & TIN PER CITY CENTERLINE TIE 158, DOWN 0.16'.
- FOUND LEAD & TACK IN TOP OF CURB PER CITY TIE 158.
- SET LEAD & TAG STAMPED "LS 7914 CL TIE", FLUSH IN TOP OF CURB.


CORNER RECORD

Document Number 2014-0738

City of TUSTIN

County of ORANGE, California

Brief Legal Description CENTERLINE INTERSECTION OF LORETTA DRIVE AND BOUNDARY OF TRACT 3541.

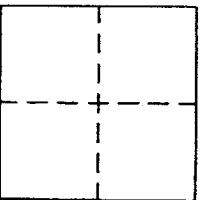

CORNER TYPE

Government Corner ☐ Control ☒
Meander ☐ Property ☐
Rancho ☐ Other ☐
Date of Survey 2-19-2014

COORDINATES (Optional)

N. _____ E. _____
Zone _____ NAD27 ☐ NAD83 ☐
NAD83 Epoch _____
Elev. _____
Vert. Datum: NGVD29 ☐ NAVD88 ☐
Meas. Units: Metric ☐ Imperial ☐

Corner - Left as found ☐ Found and tagged ☐ Established ☐ Reestablished ☒ Rebuilt ☐

Identification and type of corner found. Evidence used to identify or procedure used to establish or reestablish the corner.
SEE SHEET 2

A description of the physical conditions of the monument as found and as set or reset: _____


NOTE: THESE TIES ARE FOR THE PURPOSE OF PERPETUATING THE FOUND MONUMENTATION.

NO CLAIM IS MADE TO THE RELATIONSHIP OF THE POINTS OR LINES SHOWN HEREON TO THE TRUE BOUNDARY LOCATIONS.

SURVEYOR'S STATEMENT

This Corner Record was prepared by me or under my direction in conformance with the Land Surveyors' Act on _____ DATE 2-26-2014

Signed [Signature] P.L.S. or R.C.E. No. 7914

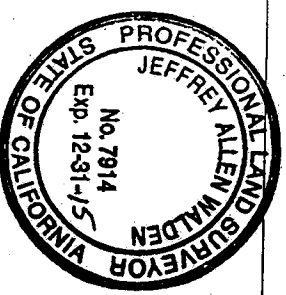


COUNTY SURVEYOR'S STATEMENT

This Corner Record was received _____ MAY 13 2014


and examined and filed _____ MAY 21 2014

Signed [Signature] P.L.S. or R.C.E. No. [Signature]

Title Chief Deputy Surveyor

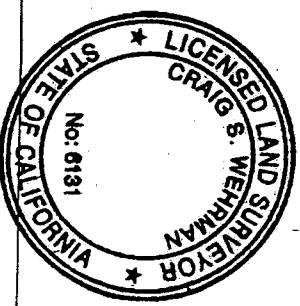


County Surveyor's Comment _____

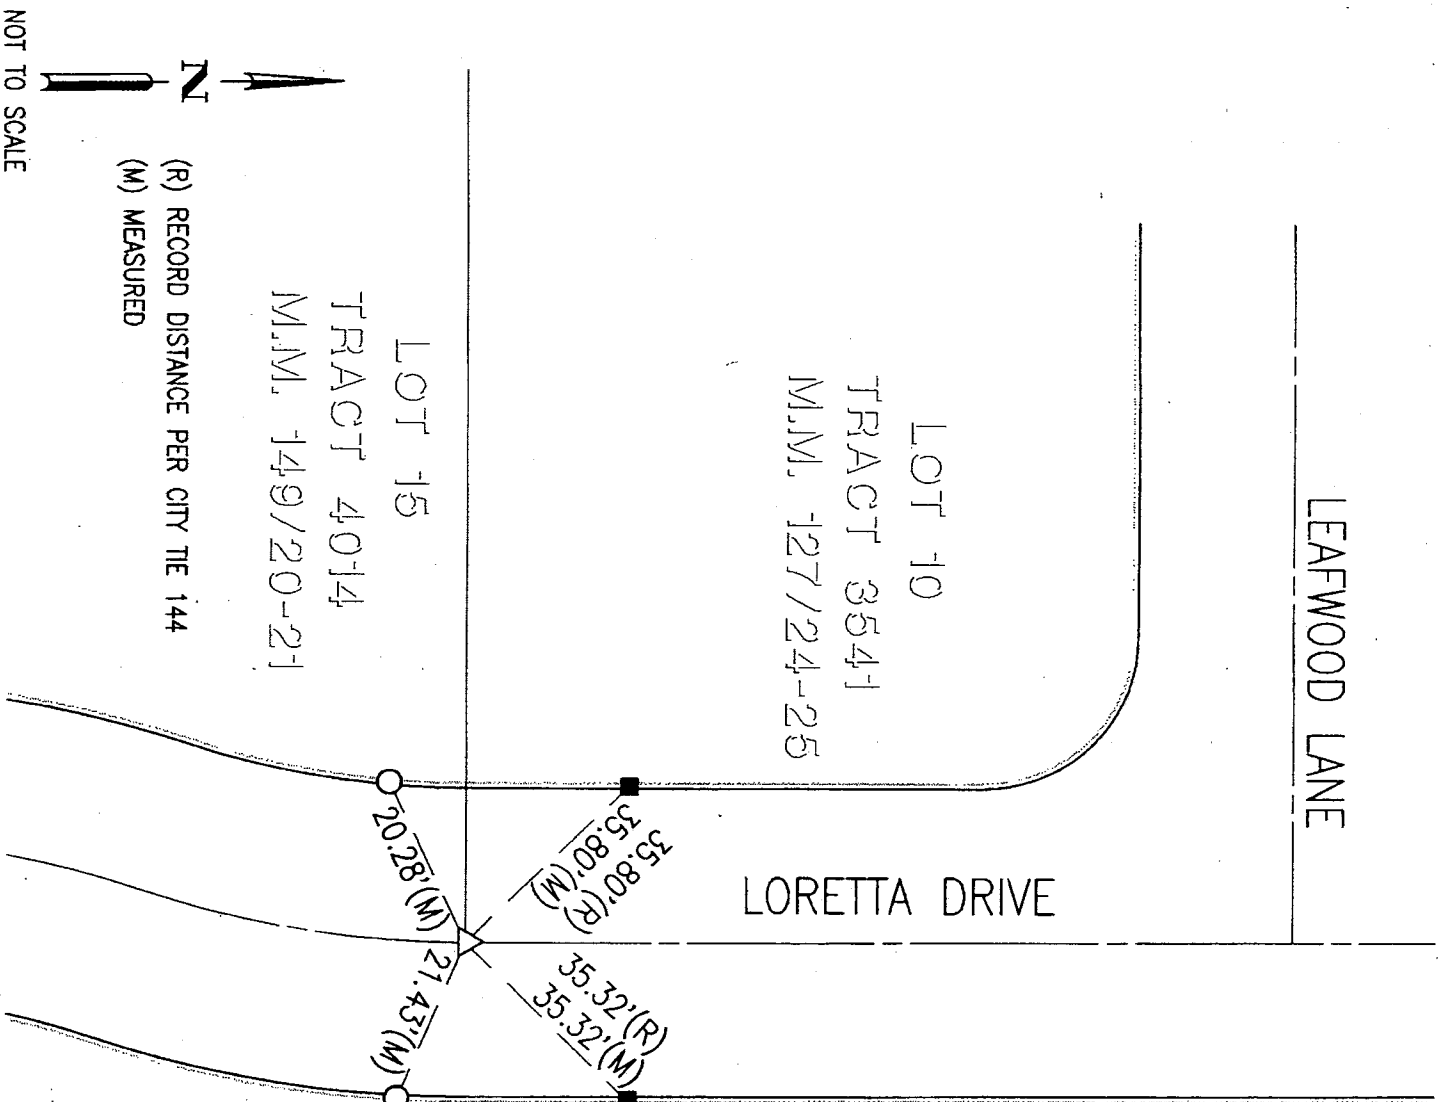

- ▲ SET SPIKE & WASHER STAMPED "LS 7914" PER CITY OF TUSTIN CENTERLINE TIES 144, FLUSH.
- FOUND CHISELED X IN TOP OF CURB PER CITY OF TUSTIN CENTERLINE TIE 144.
- SET LEAD & TAG STAMPED "LS 7914 CL TIE", FLUSH IN TOP OF CURB.

CORNER RECORD

Document Number _____
City of TUSTIN County of ORANGE, California
Brief Legal Description SANTA CLARA AVE. & CARROLL WAY

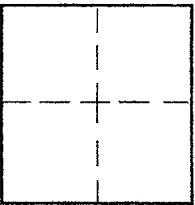

CORNER TYPE

Govt Corner ☐ Control ☐
Meander ☐ Property ☐
Rancho ☐ Other ☒
Date of Survey 8-9-13

COORDINATES (Optional)

N. _____
E. _____
Zone _____ NAD27 ☐ NAD83 ☐
NAD83 Epoch _____
Elev. _____
Vert. Datum: NGVD29 ☐ NAVD88 ☐
Meas. Units: Metric ☐ Imperial ☐

Corner - Left as found ☒ Found and tagged ☐ Established ☐ Reestablished ☐ Rebuilt ☐

Identification and type of corner found: Evidence used to identify or procedure used to establish or reestablish the corner:

SEE PAGE 2


A description of the physical condition of the monument as found and as set or reset: _____

SEE PAGE 2

SURVEYOR'S STATEMENT

This Corner Record was prepared by me or under my direction in conformance with the Land Surveyors' Act on 11-20 2013

Signed Greg Embrey P.L.S. or R.C.E. No. 6771

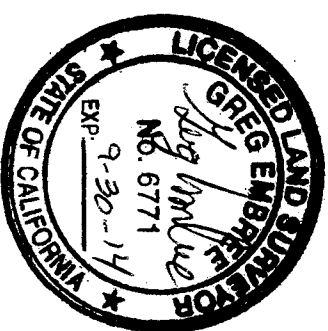

COUNTY SURVEYOR'S STATEMENT


This Corner Record was received _____
and examined and filed _____

Signed _____ P.L.S. or R.C.E. No. _____

Title: _____

County Surveyor's Comment _____

CITY OF JUSTIN
THOMAS GUIDE PG. 800
GRID A-7

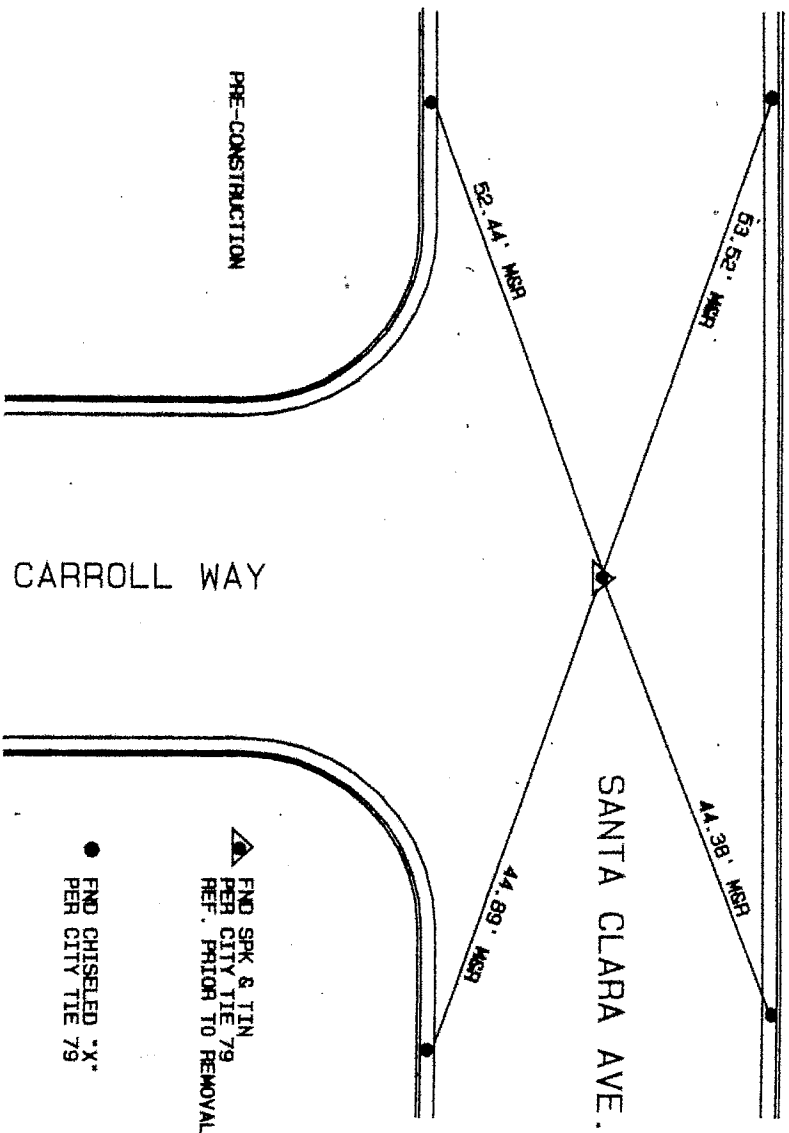

1051