

MANHOLE DETAIL:

JOB NO: EQ19810S

DATE: 5/24/2021

CREW: Russo/Cummins

STREET: Yorba



TIME: _____ AM / PM

MANHOLE TYPE: SD

LID POINT NO: 23104

PHOTO NO: _____

PIPE MATERIAL: RCP

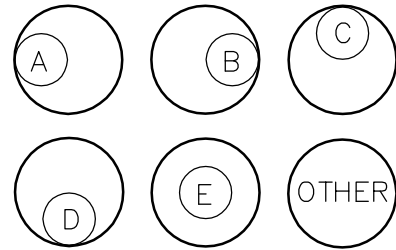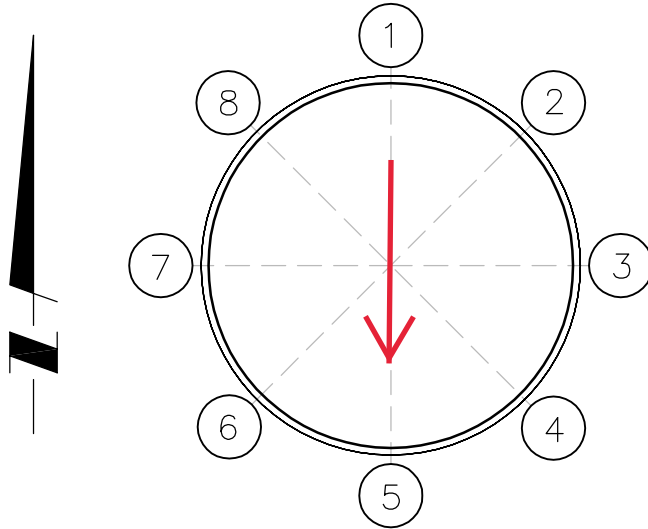

RIM OFFSET TYPE: B

POINT:	RIM ELEV:	INVERT:	F.L. ELEV:	PIPE DIA:	
1	_____	_____	_____	_____	WET / DRY
2	_____	_____	_____	_____	WET / DRY
3	_____	_____	_____	_____	WET / DRY
4	_____	_____	_____	_____	WET / DRY
5	_____	_____	_____	_____	WET / DRY
6	_____	_____	_____	_____	WET / DRY
7	_____	_____	_____	_____	WET / DRY
8	_____	_____	_____	_____	WET / DRY
CNTR:	<u>194.43</u>	<u>-8.42</u>	<u>186.01</u>	<u>48"</u>	WET / DRY