

# MANHOLE DETAIL:

JOB NO: EQ19810S

DATE: 5/26/2021

CREW: Russo/Cummins

STREET: Prospect Ave.



TIME: \_\_\_\_\_ AM / PM

MANHOLE TYPE: SD

LID POINT NO: 26166

PHOTO NO: \_\_\_\_\_

PIPE MATERIAL: RCP

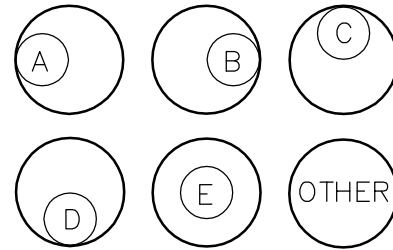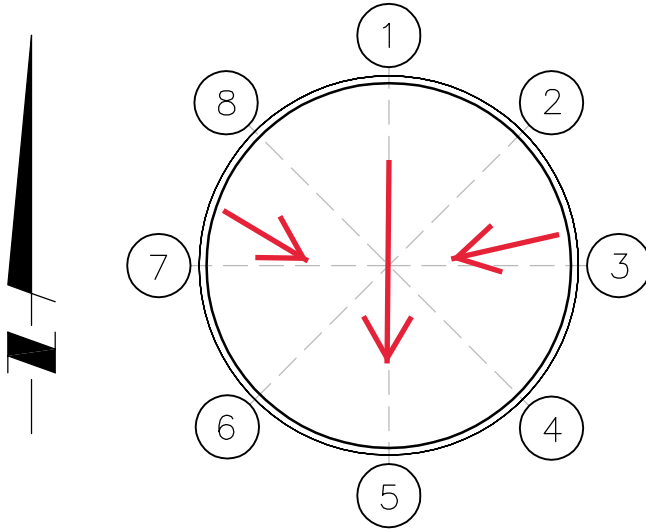

RIM OFFSET TYPE: B

| POINT: | RIM ELEV: | INVERT: | F.L. ELEV: | PIPE DIA: |                      |
|--------|-----------|---------|------------|-----------|----------------------|
| 1      | _____     | _____   | _____      | _____     | WET / DRY            |
| 2      | _____     | _____   | _____      | _____     | WET / DRY            |
| 3      | _____     | -11.34  | 189.86     | 18"       | WET / <del>DRY</del> |
| 4      | _____     | _____   | _____      | _____     | WET / DRY            |
| 5      | _____     | _____   | _____      | _____     | WET / DRY            |
| 6      | _____     | _____   | _____      | _____     | WET / DRY            |
| 7      | _____     | -13.04  | 188.16     | 36"       | WET / <del>DRY</del> |
| 8      | _____     | _____   | _____      | _____     | WET / DRY            |
| CNTR:  | 201.20    | -14.07  | 187.13     | 72"       | WET / <del>DRY</del> |