

MANHOLE DETAIL:

JOB NO: EQ19810S

DATE: 5/26/2021

CREW: Russo/Cummins

STREET: Prospect Ave.



TIME: _____ AM / PM

MANHOLE TYPE: SD

LID POINT NO: 26167

PHOTO NO: _____

PIPE MATERIAL: RCP

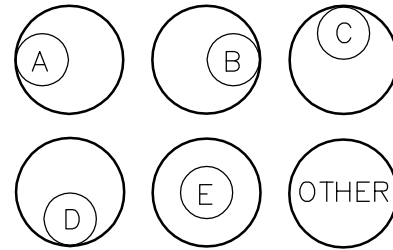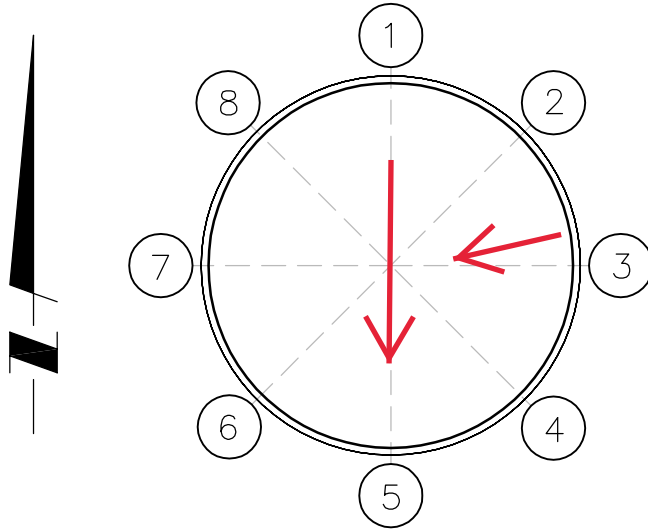

RIM OFFSET TYPE: A

POINT:	RIM ELEV:	INVERT:	F.L. ELEV:	PIPE DIA:	
1					WET / DRY
2					WET / DRY
3		-10.32	190.2	30"	WET / DRY
4					WET / DRY
5					WET / DRY
6					WET / DRY
7					WET / DRY
8					WET / DRY
CNTR:	200.52	-13.94	186.58	72"	WET / DRY