

MANHOLE DETAIL:

JOB NO: EQ19810S

DATE: 5/26/2021

CREW: Russo/Cummins

STREET: Prospect Ave.



TIME: _____ AM / PM

MANHOLE TYPE: SD

LID POINT NO: 26948

PHOTO NO: _____

PIPE MATERIAL: RCP

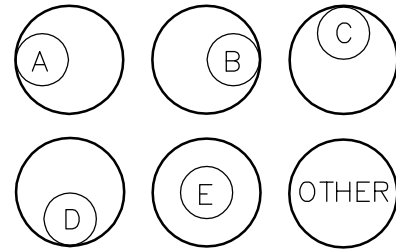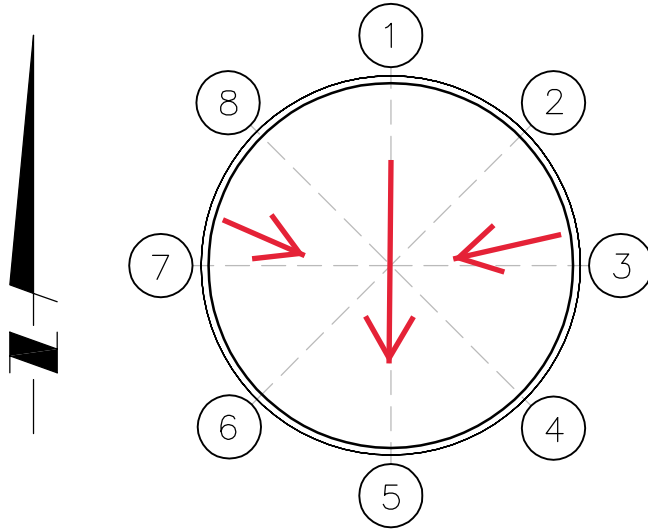

RIM OFFSET TYPE: A

POINT:	RIM ELEV:	INVERT:	F.L. ELEV:	PIPE DIA:	
1					WET / DRY
2					WET / DRY
3		-10.44	184.58	18"	WET / DRY
4					WET / DRY
5					WET / DRY
6					WET / DRY
7		-10.50	184.52	18"	WET / DRY
8					WET / DRY
CNTR:	195.02	-13.25	181.77	72"	WET / DRY