

MANHOLE DETAIL:

JOB NO: EQ19810S

DATE: 6/02/2021

CREW: Russo/Cummins

STREET: Leafwood Ln.



TIME: _____ AM / PM

MANHOLE TYPE: SS

LID POINT NO: 10331

PHOTO NO: _____

PIPE MATERIAL: VCP

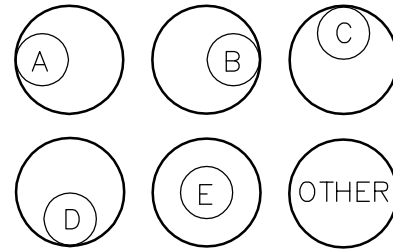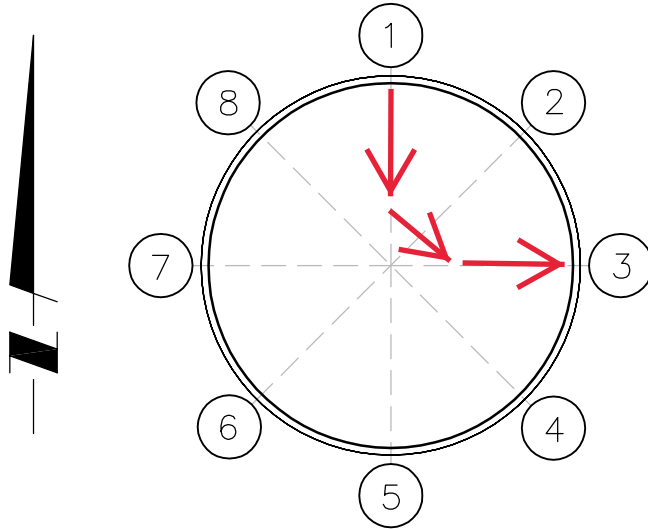

RIM OFFSET TYPE: D

POINT:	RIM ELEV:	INVERT:	F.L. ELEV:	PIPE DIA:	
1		-6.76	177.44	8"	WET / DRY
2					WET / DRY
3		-6.84	177.36	8"	WET / DRY
4					WET / DRY
5					WET / DRY
6					WET / DRY
7					WET / DRY
8					WET / DRY
CNTR:	184.20				WET / DRY