

MANHOLE DETAIL:

JOB NO: EQ19810S

DATE: 5/24/2021

CREW: Russo/Cummins

STREET: Yorba



TIME: _____ AM / PM

MANHOLE TYPE: SS

LID POINT NO: 20185

PHOTO NO: _____

PIPE MATERIAL: VCP

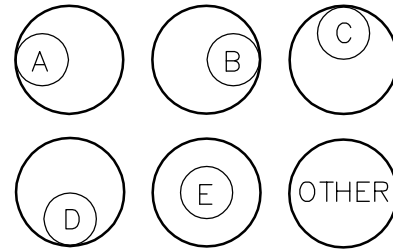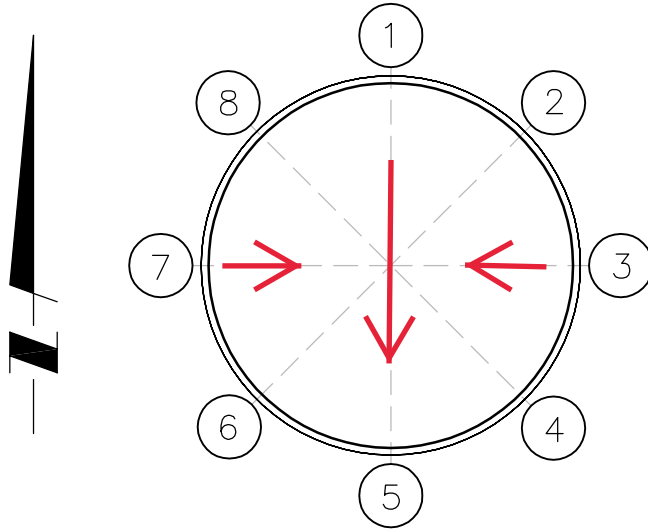

RIM OFFSET TYPE: E

POINT:	RIM ELEV:	INVERT:	F.L. ELEV:	PIPE DIA:	
1		-10.46	199.03	15"	WET / DRY
2					WET / DRY
3		-10.03	199.46	8"	WET / DRY
4					WET / DRY
5		-10.53	198.96	15"	WET / DRY
6					WET / DRY
7		-10.00	199.49	8"	WET / DRY
8					WET / DRY
CNTR:	209.49				WET / DRY