

MANHOLE DETAIL:

JOB NO: EQ19810S

DATE: 5/24/2021

CREW: Russo/Cummins

STREET: Yorba



TIME: _____ AM / PM

MANHOLE TYPE: SS

LID POINT NO: 21575

PHOTO NO: _____

PIPE MATERIAL: VCP

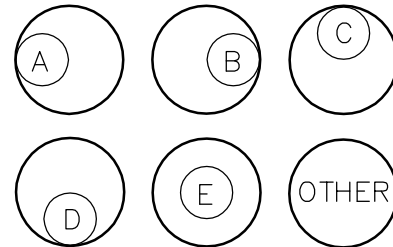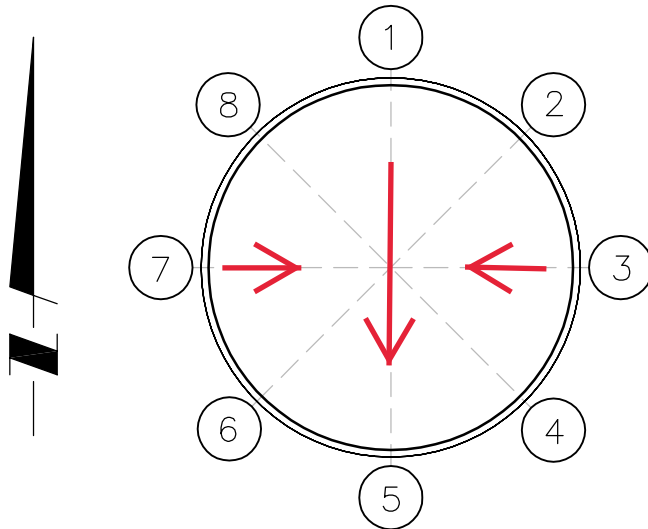

RIM OFFSET TYPE: E

POINT:	RIM ELEV:	INVERT:	F.L. ELEV:	PIPE DIA:	
1		-12.97	190.94	15"	WET / DRY
2					WET / DRY
3		-12.30	191.61	8"	WET / DRY
4					WET / DRY
5		-12.95	190.96	15"	WET / DRY
6					WET / DRY
7		-12.35	191.56	8"	WET / DRY
8					WET / DRY
CNTR:	203.91				WET / DRY