

MANHOLE DETAIL:

JOB NO: EQ19810S

DATE: 5/26/2021

CREW: Russo/Cummins

STREET: Prospect Ave.



TIME: _____ AM / PM

MANHOLE TYPE: SS

LID POINT NO: 25371

PHOTO NO: _____

PIPE MATERIAL: VCP

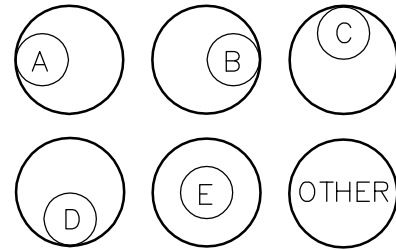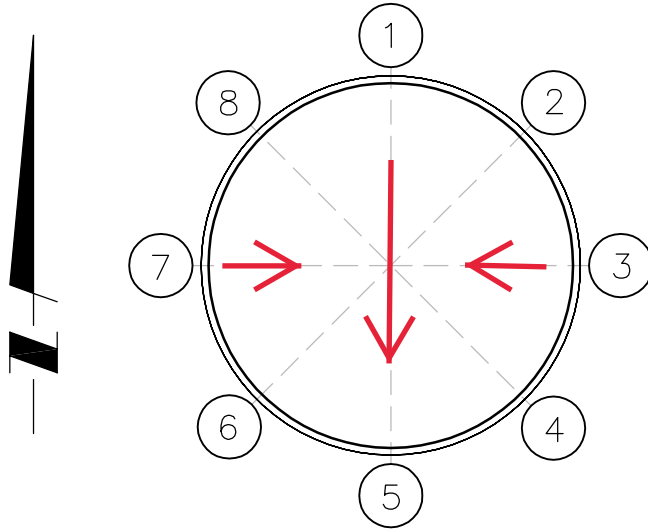

RIM OFFSET TYPE: D

POINT:	RIM ELEV:	INVERT:	F.L. ELEV:	PIPE DIA:	
1		-11.40	195.63	21"	WET / DRY
2					WET / DRY
3		-10.08	196.95	8"	WET / DRY
4					WET / DRY
5		-11.44	195.59	21"	WET / DRY
6					WET / DRY
7		-10.10	196.93	8"	WET / DRY
8					WET / DRY
CNTR:	207.03				WET / DRY