

MANHOLE DETAIL:

JOB NO: EQ19810S

DATE: 6/02/2021

CREW: Russo/Cummins

STREET: E. Santa Clara Ave.



TIME: _____ AM / PM

MANHOLE TYPE: SS

LID POINT NO: 61000

PHOTO NO: _____

PIPE MATERIAL: VCP

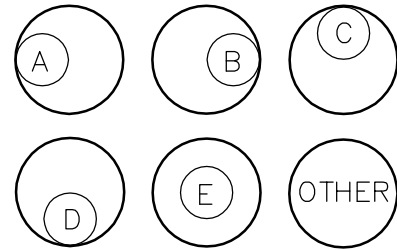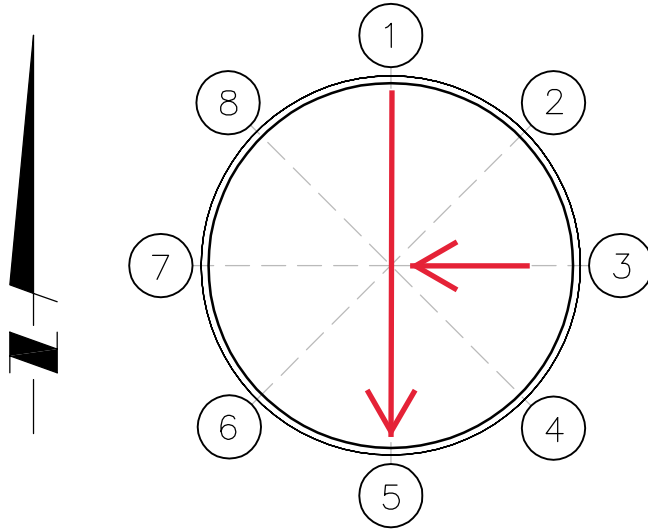

RIM OFFSET TYPE: D

POINT:	RIM ELEV:	INVERT:	F.L. ELEV:	PIPE DIA:	
1		-6.68	177.00	8"	WET / DRY
2					WET / DRY
3		-6.70	176.98	8"	WET / DRY
4					WET / DRY
5		-6.82	176.86	8"	WET / DRY
6					WET / DRY
7					WET / DRY
8					WET / DRY
CNTR:	183.68				WET / DRY