

MANHOLE DETAIL:

JOB NO: EQ19810S

DATE: 6/02/2021

CREW: Russo/Cummins

STREET: E. Santa Clara Ave.



TIME: _____ AM / PM

MANHOLE TYPE: SS

LID POINT NO: 62862

PHOTO NO: _____

PIPE MATERIAL: VCP

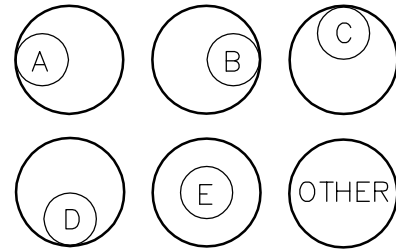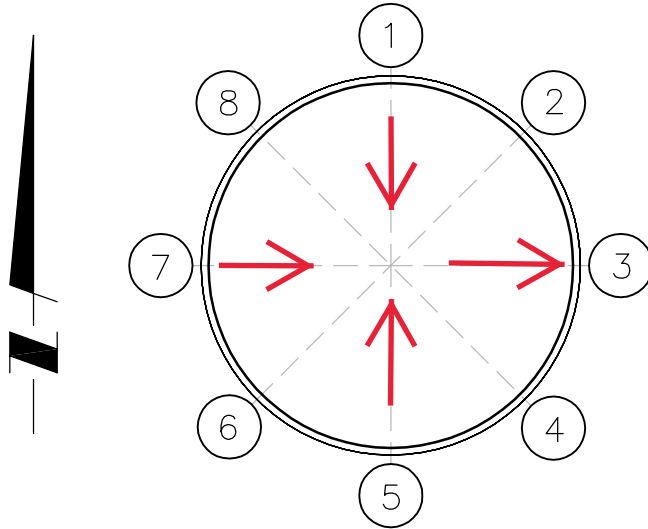

RIM OFFSET TYPE: E

POINT:	RIM ELEV:	INVERT:	F.L. ELEV:	PIPE DIA:	
1		-10.05	181.75	8"	WET / DRY
2					WET / DRY
3		-10.20	181.60	8"	WET / DRY
4					WET / DRY
5		-10.01	181.79	8"	WET / DRY
6					WET / DRY
7		10.17	181.63	8"	WET / DRY
8					WET / DRY
CNTR:	191.80				WET / DRY