

Orange County Surveyor

MANHOLE DETAIL:

JOB NO: EQ19810S

DATE: 08/30/23

CREW: RUSO/ PAYAN

STREET: ALLEGHENY DR @ LAURINDA WAY



TIME: 10:00 ☒ AM ☐ PM

MANHOLE TYPE: SEWER

LID POINT NO: 221431

PHOTO NO: 4

PIPE MATERIAL: VCP

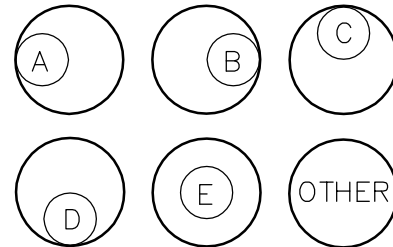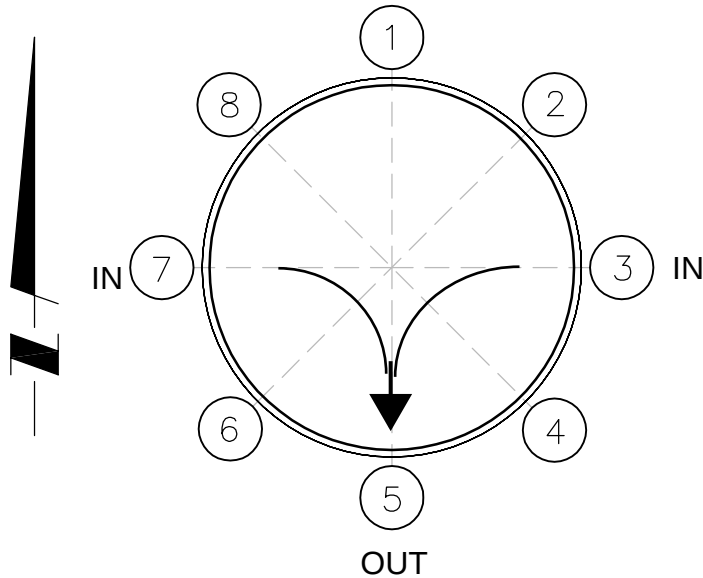

RIM OFFSET TYPE: D

POINT:	RIM ELEV:	INVERT:	F.L. ELEV:	PIPE DIA:	
1					WET / DRY
2					WET / DRY
3	196.99	-8.27	188.72	10"	☒ WET / DRY
4					WET / DRY
5	196.99	-8.30	188.69	10"	☒ WET / DRY
6					WET / DRY
7	196.99	-8.24	188.75	10"	☒ WET / DRY
8					WET / DRY
CNTR:					WET / DRY