

Orange County Surveyor

MANHOLE DETAIL:

JOB NO: EQ19810S

DATE: 08/30/23

CREW: RUSSO/ PAYAN

STREET: LAURINDA WAY



TIME: 10:00 AM / PM

MANHOLE TYPE: SEWER

LID POINT NO: 222080

PHOTO NO: 6

PIPE MATERIAL: VCP

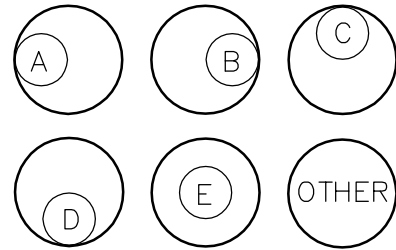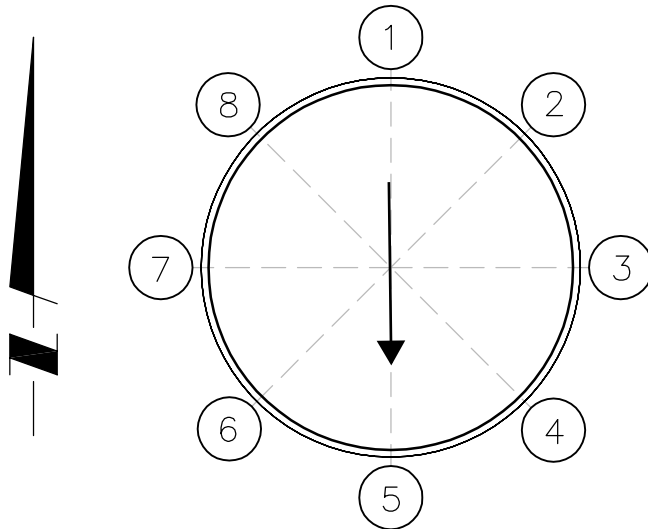

RIM OFFSET TYPE: D

POINT:	RIM ELEV:	INVERT:	F.L. ELEV:	PIPE DIA:	
1	192.30	-7.50	184.80	10"	<u>WET</u> / DRY
2					WET / DRY
3					WET / DRY
4					WET / DRY
5	192.30	-7.53	184.77	10"	<u>WET</u> / DRY
6					WET / DRY
7					WET / DRY
8					WET / DRY
CNTR:					WET / DRY