

Orange County Surveyor

MANHOLE DETAIL:

JOB NO: EQ19810S

DATE: 08/30/23

CREW: RUSO/ PAYAN

STREET: MALENA DR



TIME: 10:00 AM / PM

MANHOLE TYPE: SEWER

LID POINT NO: 250588

PHOTO NO: 9

PIPE MATERIAL: VCP

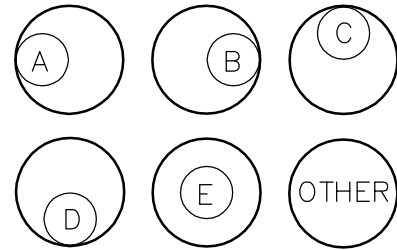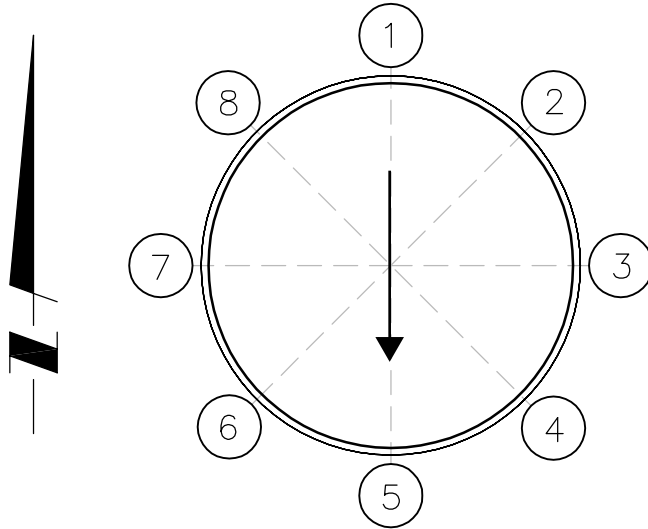

RIM OFFSET TYPE: D

POINT:	RIM ELEV:	INVERT:	F.L. ELEV:	PIPE DIA:	
1	195.57	-7.62	187.95	10"	<u>WET</u> / DRY
2					WET / DRY
3					WET / DRY
4					WET / DRY
5	195.57	-7.65	187.92	10"	<u>WET</u> / DRY
6					WET / DRY
7					WET / DRY
8					WET / DRY
CNTR:					WET / DRY