

MANHOLE DETAIL:

JOB NO: EQ19810S

DATE: 5/26/2021

CREW: Russo/Cummins

STREET: Prospect Ave.



TIME: _____ AM / PM

MANHOLE TYPE: SS

LID POINT NO: 12613

PHOTO NO: _____

PIPE MATERIAL: VCP

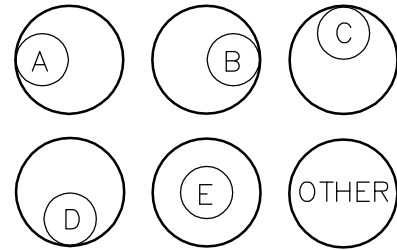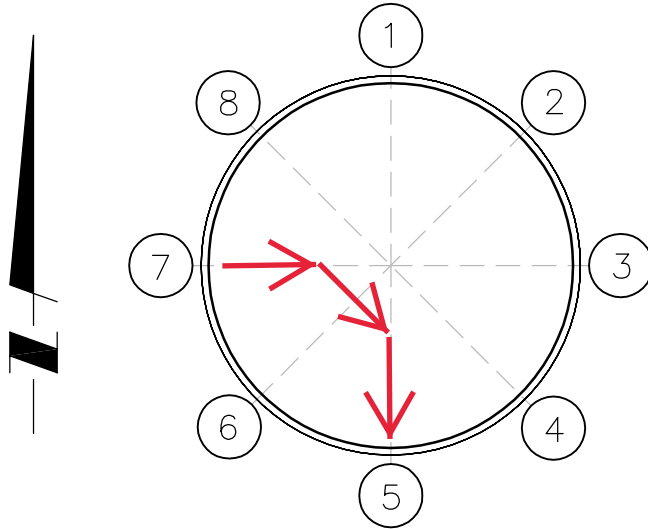

RIM OFFSET TYPE: D

POINT:	RIM ELEV:	INVERT:	F.L. ELEV:	PIPE DIA:	
1	_____	_____	_____	_____	WET / DRY
2	_____	_____	_____	_____	WET / DRY
3	_____	_____	_____	_____	WET / DRY
4	_____	_____	_____	_____	WET / DRY
5	_____	-10.96	179.62	8"	WET / DRY
6	_____	_____	_____	_____	WET / DRY
7	_____	-10.94	179.64	8"	WET / DRY
8	_____	_____	_____	_____	WET / DRY
CNTR:	190.58	_____	_____	_____	WET / DRY