

MANHOLE DETAIL:

JOB NO: EQ19810S

DATE: 5/26/2021

CREW: Russo/Cummins

STREET: Prospect Ave.



TIME: _____ AM / PM

MANHOLE TYPE: SS

LID POINT NO: 24688

PHOTO NO: _____

PIPE MATERIAL: VCP

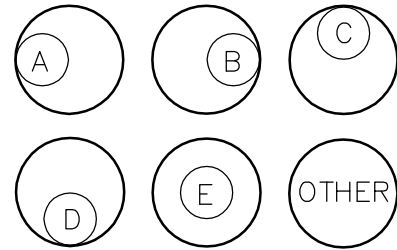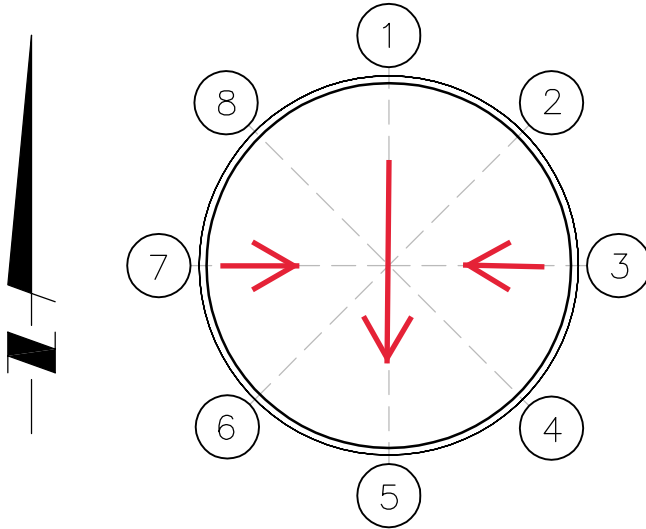

RIM OFFSET TYPE: D

POINT:	RIM ELEV:	INVERT:	F.L. ELEV:	PIPE DIA:	
1		-11.45	199.97	21"	WET / DRY
2					WET / DRY
3		-10.54	200.88	8"	WET / DRY
4					WET / DRY
5		-11.54	199.88	21"	WET / DRY
6					WET / DRY
7		-10.54	200.88	8"	WET / DRY
8					WET / DRY
CNTR:	211.42				WET / DRY