

MANHOLE DETAIL:

JOB NO: EQ19810S

DATE: 6/02/2021

CREW: Russo/Cummins

STREET: E. Santa Clara Ave.



TIME: _____ AM / PM

MANHOLE TYPE: SS

LID POINT NO: 61490

PHOTO NO: _____

PIPE MATERIAL: VCP

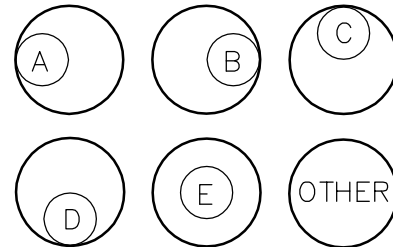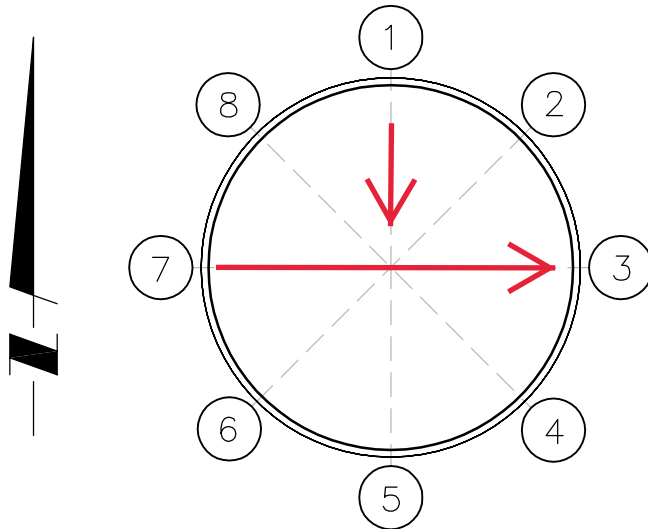

RIM OFFSET TYPE: E

POINT:	RIM ELEV:	INVERT:	F.L. ELEV:	PIPE DIA:	
1		-8.29	183.66	8"	WET / DRY
2					WET / DRY
3		-8.36	183.59	8"	WET / DRY
4					WET / DRY
5					WET / DRY
6					WET / DRY
7		-8.34	183.61	8"	WET / DRY
8					WET / DRY
CNTR:	191.95				WET / DRY