

SURVEY NOTES, 1/10" GRID

FILE

S.R. 92-028

PARTY CHIEF

J. AMSLER

RECORDER

J. HIMBARGER

INSTRUMENT MAN

J. HIMBARGER

WEATHER

70°

DATE OF SURVEY

4-09-1992

PAGE

3

OF

4

SURVEY DESCRIPTION

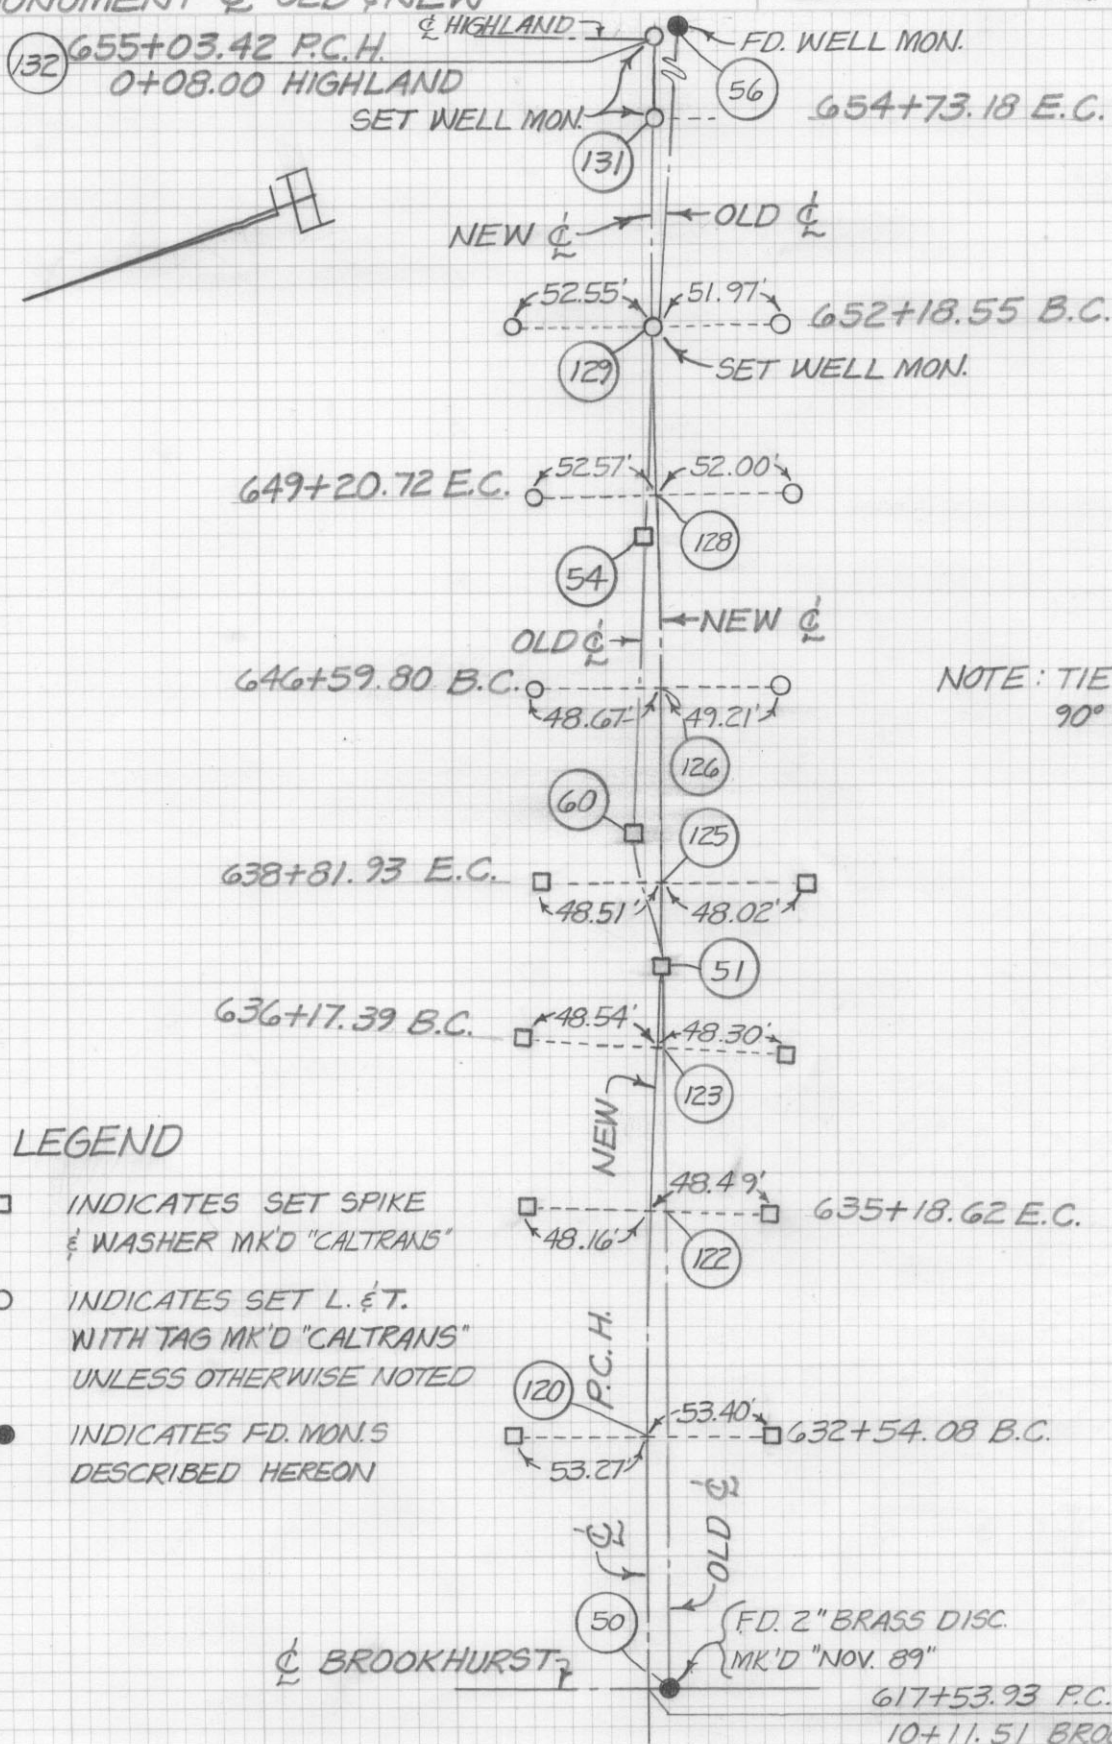
MONUMENT & OLD & NEW

CHARGE-EXPEND

023773

CO. - RTE. - PM

ORA-001-21.38/22.09

DEPARTMENT OF TRANSPORTATION
STATE OF CALIFORNIA

LEGEND

- INDICATES SET SPIKE & WASHER MK'D "CALTRANS"
- INDICATES SET L. & T. WITH TAG MK'D "CALTRANS" UNLESS OTHERWISE NOTED
- INDICATES FD. MON.S DESCRIBED HEREON