

R.S.T. 2367

RECORD OF SURVEY

BEING A SURVEY OF THE LAND ALLOTTED TO F.W. KOLL IN THE EAST ONE-HALF OF THE EAST ONE-HALF OF SECTION 19, TOWNSHIP 5 SOUTH, RANGE 9 WEST, S.B.B.M., AS PER MAP OF PARTITION OF THE RANCHO SANTIAGO DE SANTA ANA, RECORDED IN BOOK "B" OF JUDGMENTS OF THE 17TH JUDICIAL DISTRICT COURT, LOS ANGELES COUNTY, CALIFORNIA, IN THE CITY OF SANTA ANA, COUNTY OF ORANGE, CALIFORNIA.

SCALE: 1" = 200'

WINSTON I. KEERL
L. S. 2383

FEBRUARY 1964


This map correctly represents a survey made by me or under my direction in conformance with the requirements of the Land Surveyor's Act at the request of Dale H. Heinly, et al.

This map has been examined for conformance with the requirements of the Land Surveyor's Act this 18th day of June, 1964.

Winston I. Keerl
Winston I. Keerl L. S. 2383

Robert V. Wise
Deputy County Surveyor

1993 2 JUN 19 1964
FILED FOR RECORD THIS DAY OF
AT 2:25 P.M. IN BOOK T.S. PAGE 26
OF RECORDS OF SURVEYS COUNTY OF ORANGE,
CALIFORNIA
AT REQUEST OF COUNTY SURVEYOR
RUBY McFARLAND, County Recorder
\$5.00

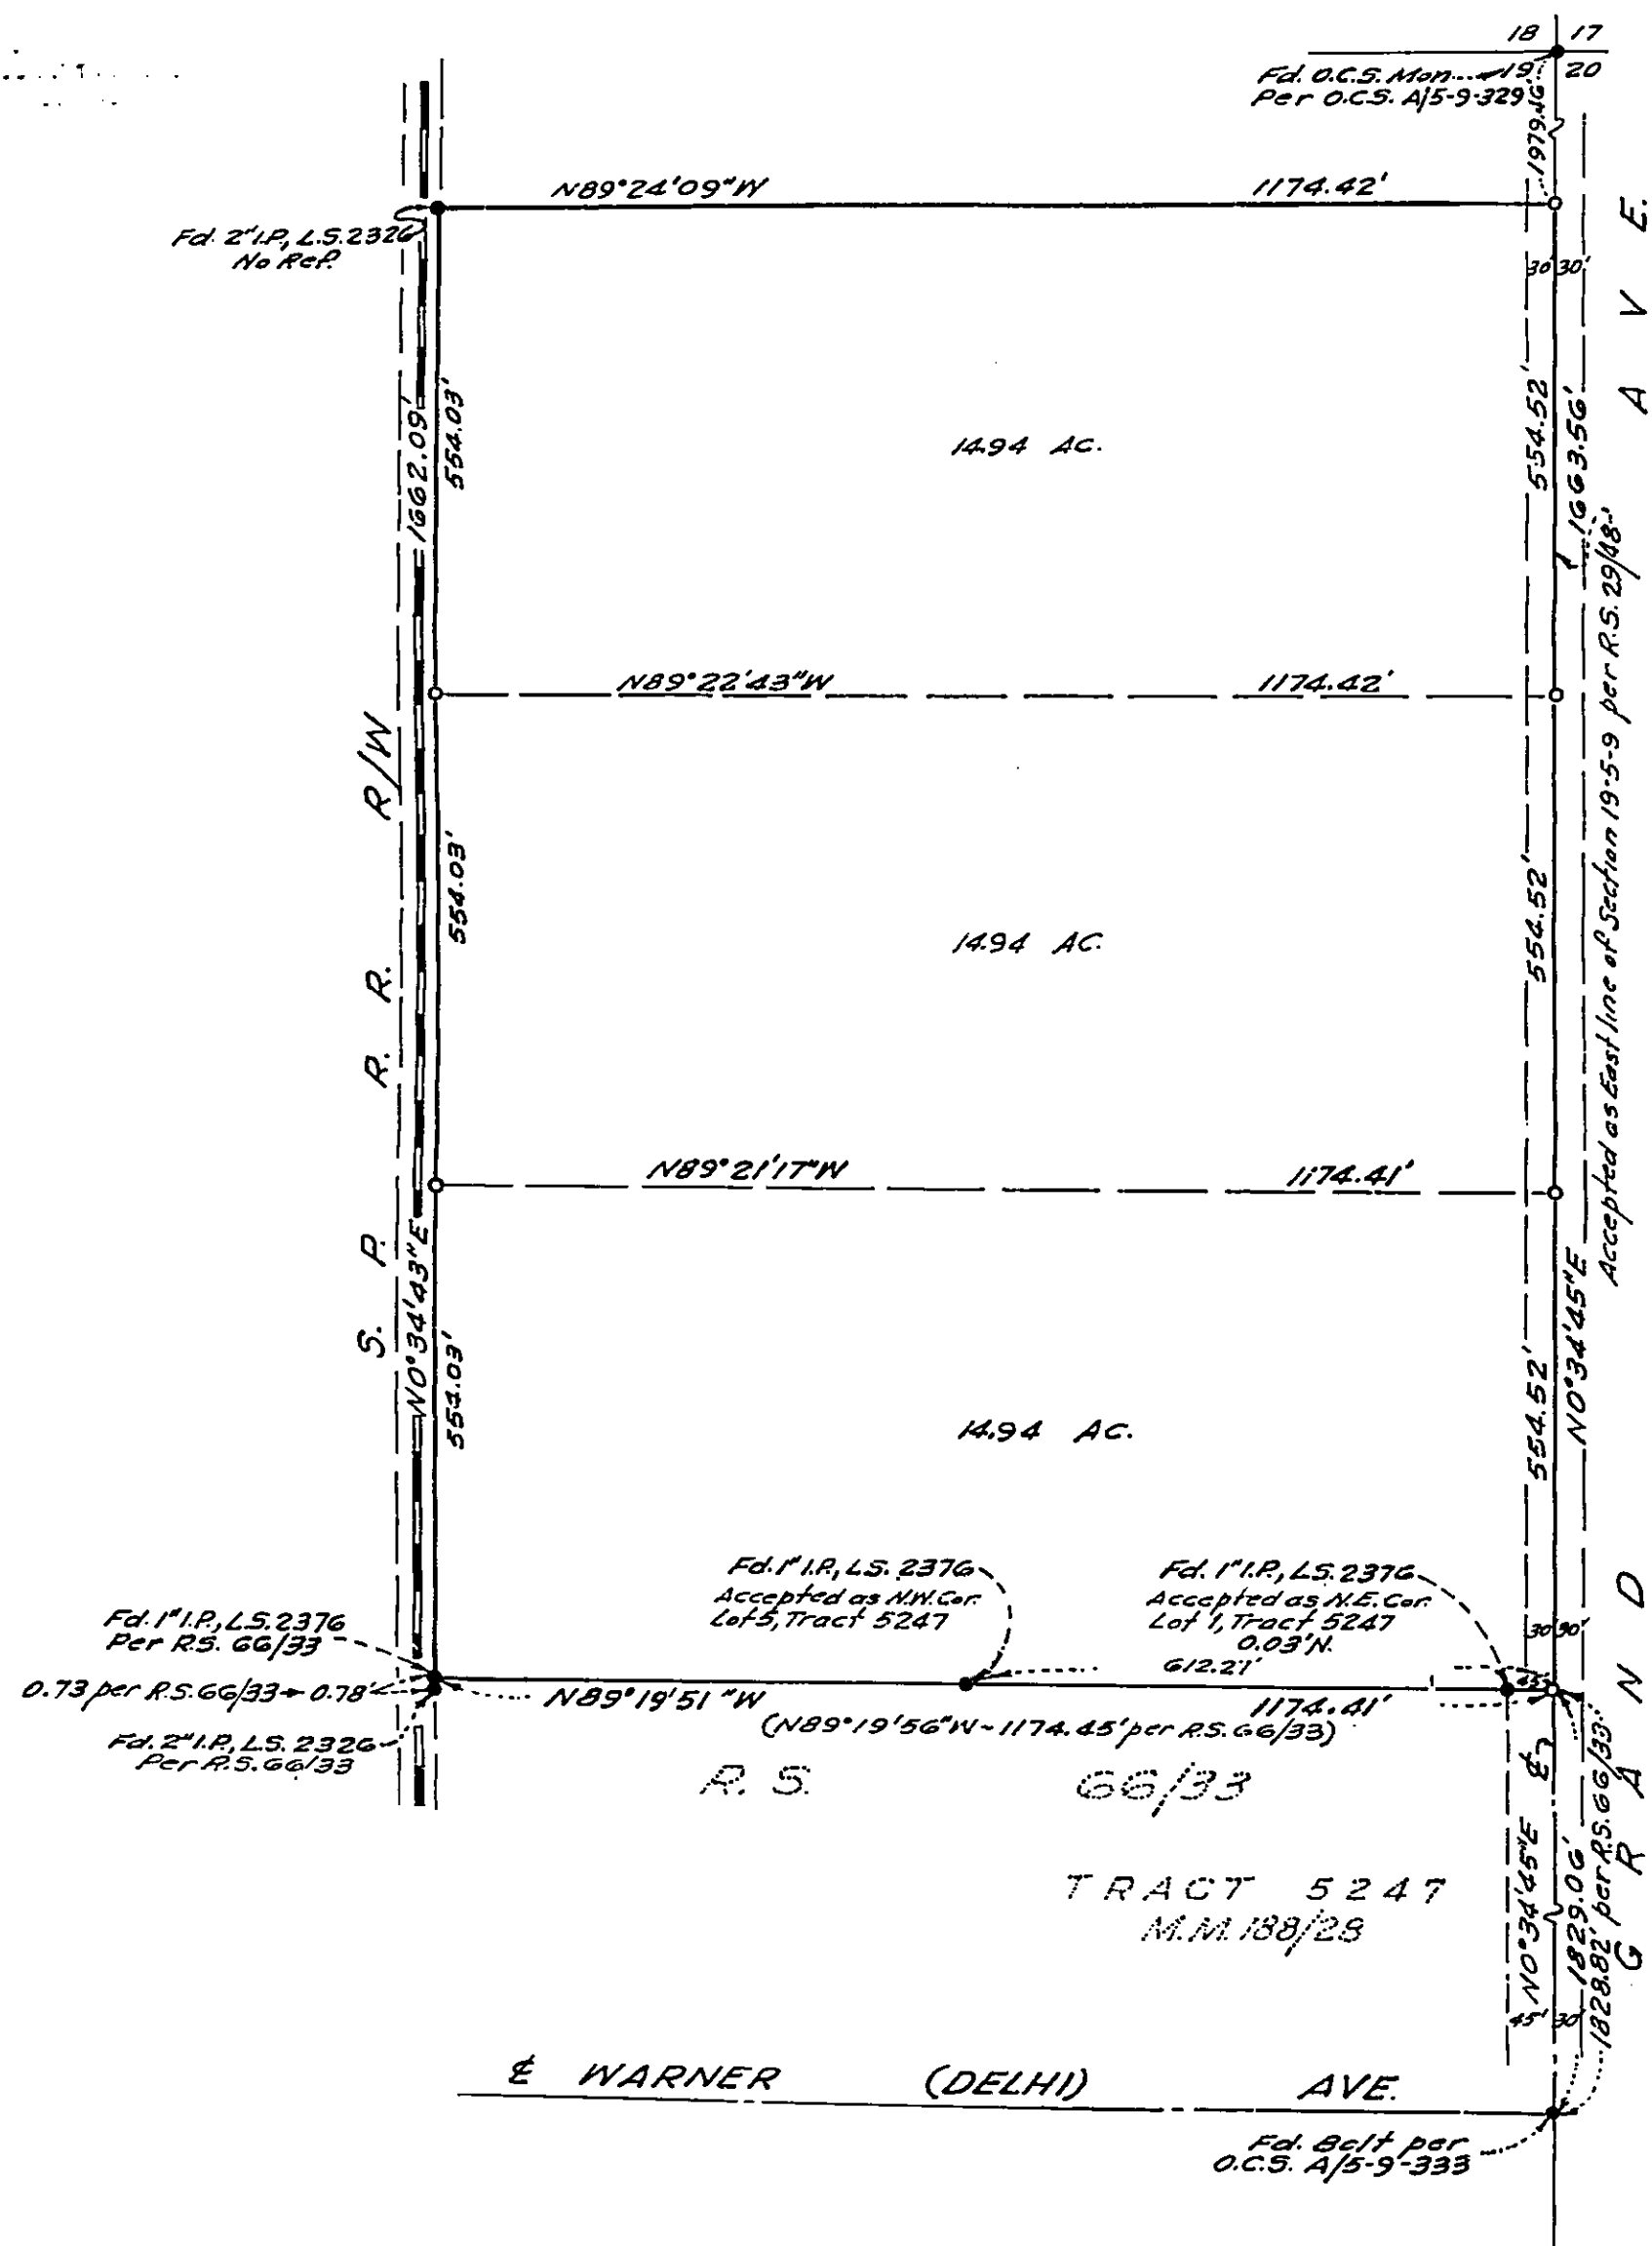

BASIS OF BEARINGS:

The centerline of Grand Avenue as North 0° 34' 49" East per Record of Survey 66/33.

MONUMENT NOTES:

- Indicates 1" I. P. Tagged L.S. 2383 set.
- Indicates found points as noted.

J.N.B.600

73 26