

I  
R  
V  
I  
N  
E  
S  
  
M.R.M. 1-88  
  
S

116  
146  
115  
147  
Found 6"x6" marked "H-51"  
S49°41'30"E 445.49'

N56°28'30"E 534.06'  
365.87'  
168.19'  
Course 82, O.R. 507-343  
R=150'  
Δ=97°00'00"  
T=169.54'  
L=253.95'

Point of beginning of course 1 is the NE'y end of course 81 of right of way conveyed by deed recorded in book 507, page 343, Official Records of Orange County, Calif.

Bearings used on this map are based on those shown in said deed.

Found 6"x6" marked "H-52"

| FIELD NOTES |               |            |
|-------------|---------------|------------|
| 1           | N 56°28'30" E | 16.52'     |
| 2           | R= 300'       | T= 153.02' |
|             | Δ= 54°03'     | L= 283.01' |
| 3           | S 69°28'30" E | 289.35'    |
| 4           | R= 500'       | T= 138.82' |
|             | Δ= 31°02'     | L= 270.82' |
| 5           | S 38°26'30" E | 134.37'    |
| 6           | R= 400'       | T= 92.01'  |
|             | Δ= 25°54'30"  | L= 180.87' |

M.R.M. 1-88


SUBDIVISION

N 49° 41' 15" W

146  
147  
148  
149

Found 6"x6" marked "H-53"

S 9° 29' 30" W

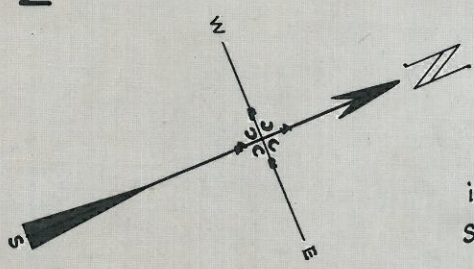

Found stone with "+" on top  
in stone mound at foot of hill;  
S.W. corner of Fractional  
Section 7, T.5 S., R.7 W., S.B.M.

E'y line of Irvine's Subdivision N 17° 51' 00" W (Record N 19° 00' W)

Found 6"x6" at top of hill

| FIELD NOTES |                 |            |
|-------------|-----------------|------------|
| 1           | N 56° 28' 30" E | 16.52'     |
| 2           | R= 300'         | T= 153.02' |
|             | Δ= 54° 03'      | L= 283.01' |
| 3           | S 69° 28' 30" E | 289.35'    |
| 4           | R= 500'         | T= 138.82' |
|             | Δ= 31° 02'      | L= 270.82' |
| 5           | S 38° 26' 30" E | 134.37'    |
| 6           | R= 400'         | T= 92.01'  |
|             | Δ= 25° 54' 30"  | L= 180.87' |
| 7           | S 64° 21' 00" E | 254.02'    |
| 8           | R= 1000'        | T= 123.82' |
|             | Δ= 14° 07'      | L= 246.38' |
| 9           | S 50° 14' 00" E | 93.17'     |
| 10          | R= 1000'        | T= 86.61'  |
|             | Δ= 9° 54'       | L= 172.79' |
| 11          | S 60° 08' 00" E | 37.90'     |
| 12          | R= 1000'        | T= 108.60' |
|             | Δ= 12° 23' 45"  | L= 216.35' |
| 13          | S 47° 44' 15" E | 274.61'    |
| 14          | R= 500'         | T= 120.58' |
|             | Δ= 27° 07'      | L= 236.64' |
| 15          | S 74° 51' 15" E | 57.90'     |
| 16          | R= 500'         | T= 129.46' |
|             | Δ= 29° 02'      | L= 253.36' |
| 17          | S 45° 49' 15" E | 66.82'     |
| 18          | R= 500'         | T= 124.28' |
|             | Δ= 27° 55'      | L= 243.62' |
| 19          | S 73° 44' 15" E | 284.21'    |
| 20          | R= 500'         | T= 73.31'  |
|             | Δ= 16° 41'      | L= 145.59' |
| 21          | S 57° 03' 15" E | 320.03'    |
| 22          | R= 500'         | T= 103.79' |
|             | Δ= 23° 27' 15"  | L= 204.68' |
| 23          | S 80° 30' 30" E | 592.41'    |
| 24          | R= 500'         | T= 213.01' |
|             | Δ= 46° 09'      | L= 402.73' |
| 25          | N 53° 20' 30" E | 482.90'    |
| 26          | R= 400'         | T= 109.27' |
|             | Δ= 30° 33' 30"  | L= 213.34' |
| 27          | N 83° 54' 00" E | 6.82'      |

Fd. 6"x6" mkd. "SHF" & "H"

Fd. 6"x6" mkd. "SHF S2"  
41.00'  
E'y end of course 27  
is S.W. corner of 5 acs.  
conveyed by deed  
recorded in book 89,  
p. 411, Official Records.

S'y line of 5 aces, O. R. 88, 411 (E)  
N 83° 54' 00" E (Record N 83° 54' 00" E)  
539.95'  
Found iron  
Traveled Road

RIGHT OF WAY  
MAP  
SILVERADO CANYON ROAD  
ORANGE COUNTY, CALIFORNIA  
APRIL, 1932  
SCALE: 1" = 400'