


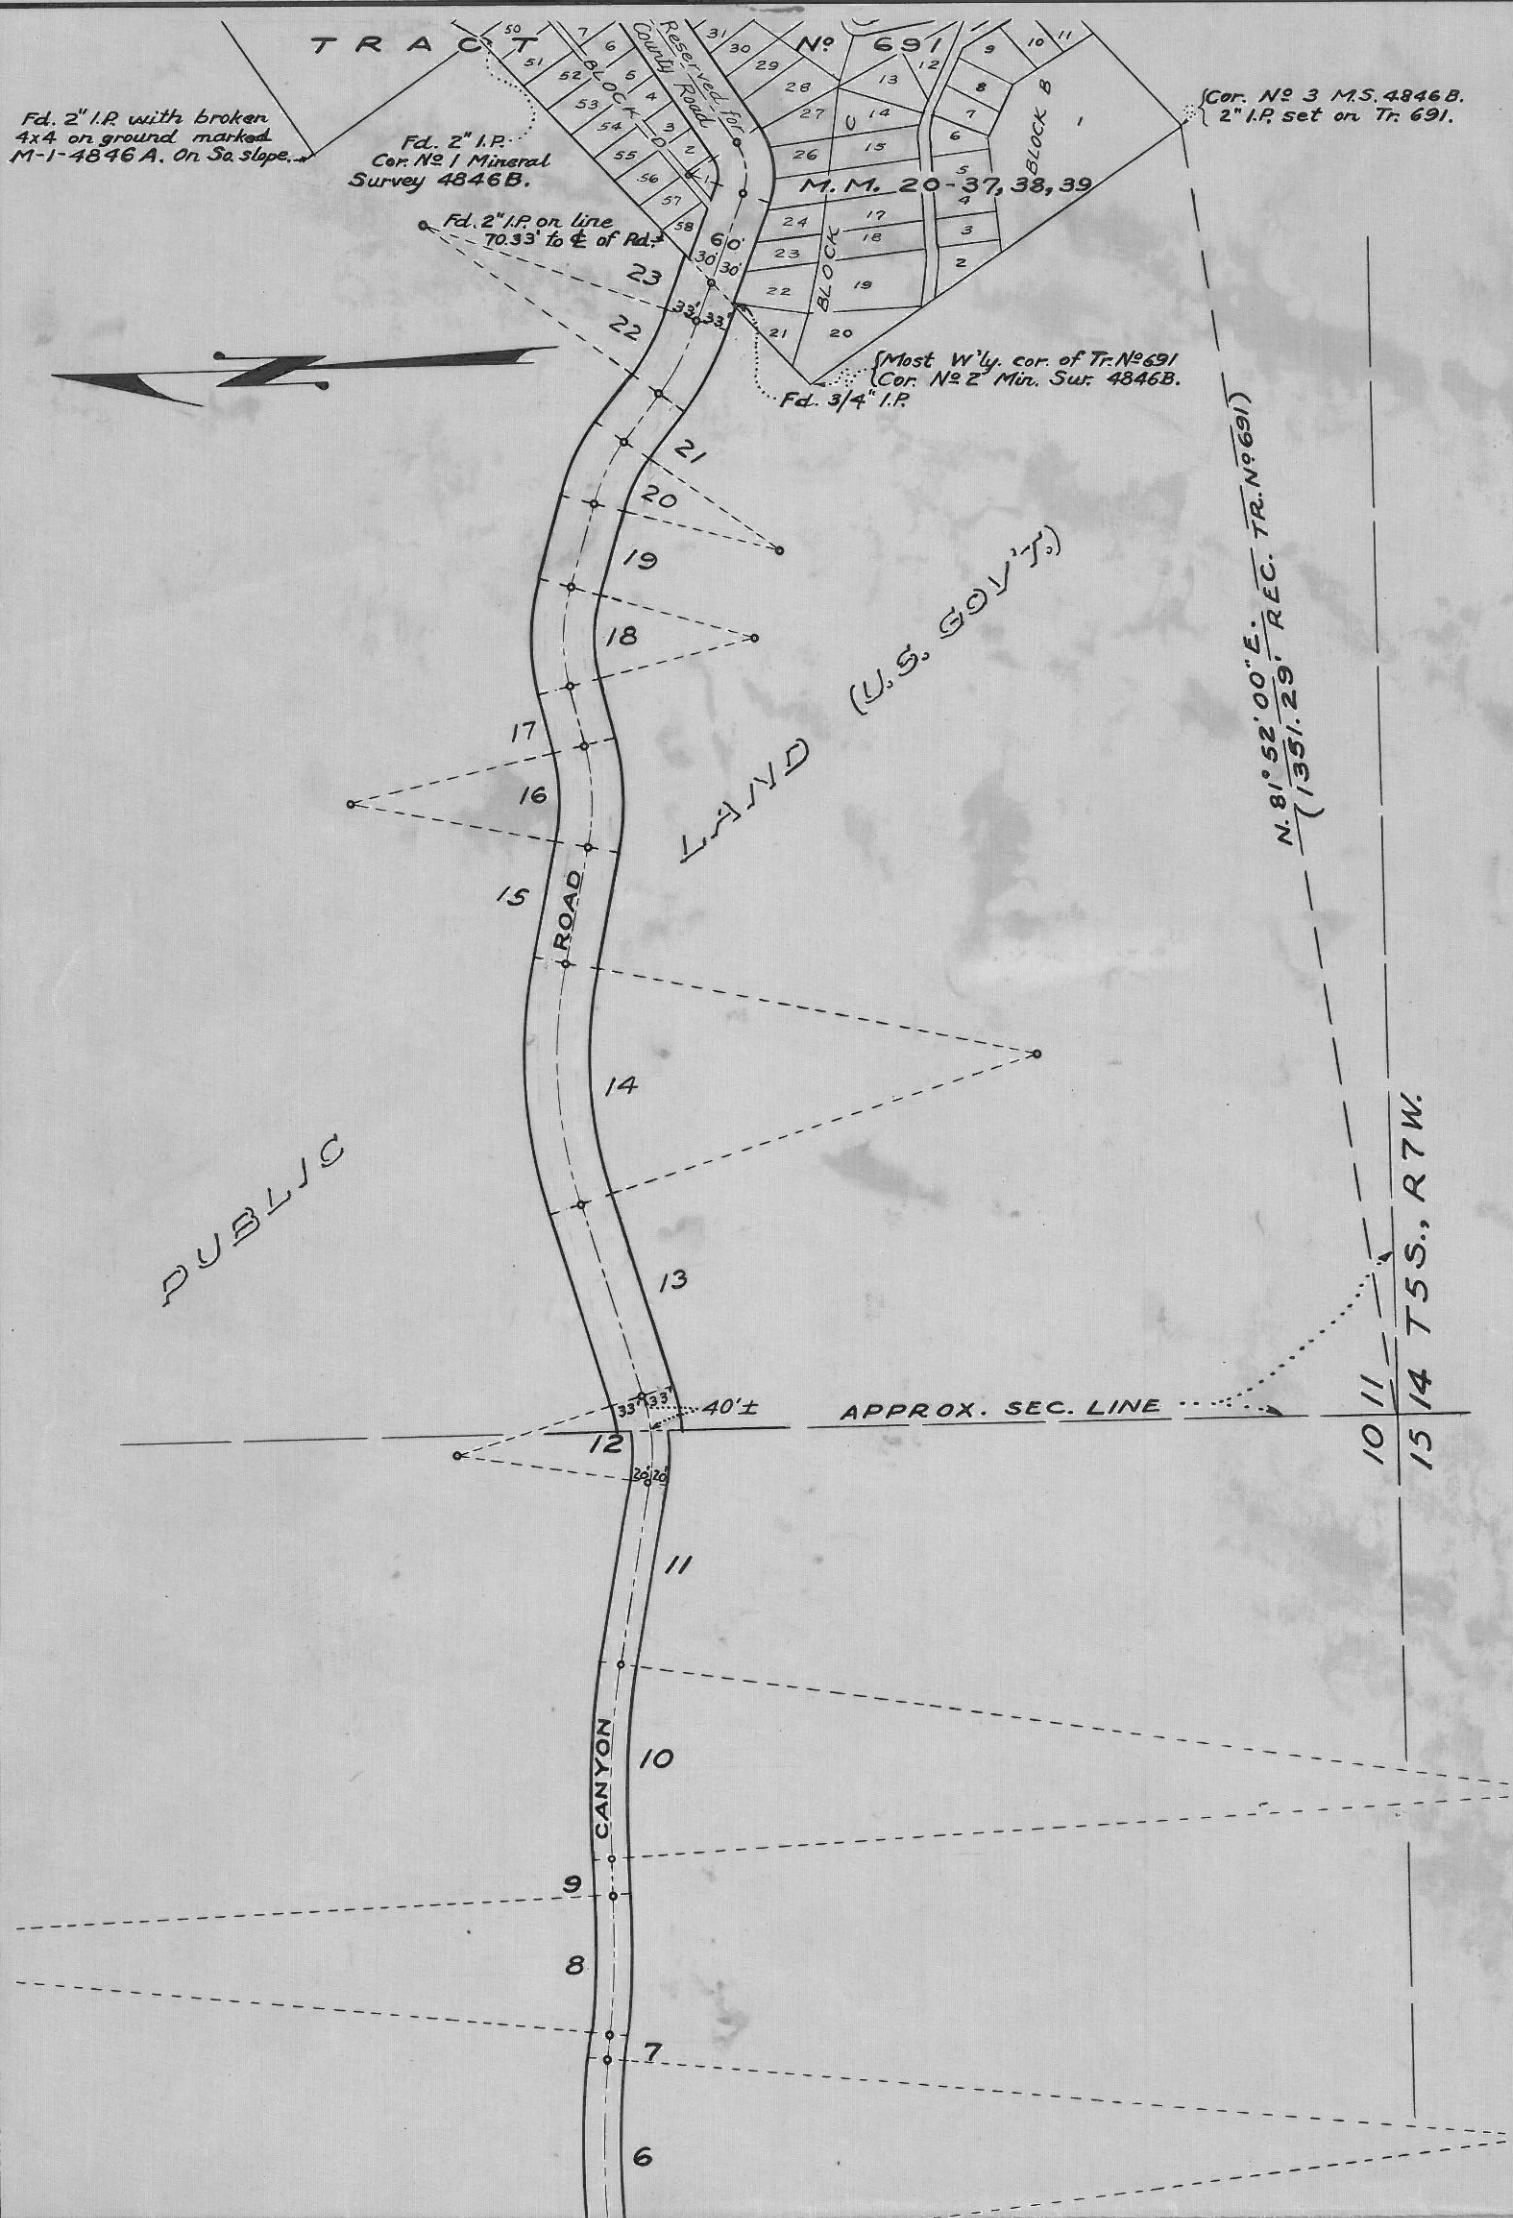

Fd. 2" I.P. with broken 4x4 on ground marked M-1-4846 A. On S. slope.

Fd. 2" I.P. Cor. No 1 Mineral Survey 4846 B.

Fd. 2" I.P. on line 70.33' to E of Rd.

Cor. No 3 M.S. 4846 B. 2" I.P. set on Tr. 691.

Most W'y. cor. of Tr. No 691 Cor. No 2 Min. Sur. 4846 B. Fd. 3/4" I.P.

LAND (U.S. GOV'T)

PUBLIC

CANYON ROAD

APPROX. SEC. LINE

N. 81° 52' 00" E. 1351.29' REC. TR. No 691

10 11 15 14 T5S., R7W.



PUBLIC

15

ROAD

14

13

12

11

10

9

8

7

6

5

4

3

2

1

CANYON

SILVERADO

TRACT N^o 1167

M.M. 36-41, 42

APPROX. SEC. LINE

10 11 14 T5S., R7W.

Fd. 3/4" pipe bearing copper tag marked L.S. 2210.
Most E'ly line }
Tr. N^o 1167

{ N. 76° 10' 50" E. (This map)
N. 75° 18' 40" E. (Tr. N^o 1167)

FIELD NOTES

1	N. 76° 10' 50" E.	194.50'
2	Δ: 25° 14' 00" R: 500'	
	T: 111.92' L: 220.20'	
3	S. 78° 35' 10" E.	85.79'
4	Δ: 17° 17' 00" R: 500'	
	T: 75.99' L: 150.83'	
5	N. 84° 07' 50" E.	49.72'
6	Δ: 12° 05' 30" R: 1000'	
	T: 105.89' L: 211.04'	
7	S. 83° 46' 40" E.	28.08'
8	Δ: 8° 14' 00" R: 1000'	
	T: 71.97' L: 143.70'	
9	N. 87° 59' 20" E.	37.83'
10	Δ: 11° 45' 00" R: 1000'	
	T: 102.90' L: 205.08'	
11	S. 80° 15' 40" E.	187.27'
12	Δ: 27° 06' 30" R: 200'	
	T: 48.22' L: 94.63'	
13	N. 72° 37' 50" E.	202.61'
14	Δ: 29° 07' 30" R: 500'	
	T: 129.89' L: 257.95'	
15	S. 78° 14' 40" E.	129.31'
16	Δ: 24° 31' 00" R: 250'	
	T: 54.32' L: 104.97'	
17	N. 77° 14' 20" E.	64.61'
18	Δ: 28° 52' 30" R: 200'	
	T: 51.51' L: 100.79'	
19	S. 73° 53' 10" E.	91.99'
20	Δ: 20° 45' 00" R: 200'	
	T: 36.62' L: 72.43'	
21	S. 53° 08' 10" E.	63.18'
22	Δ: 15° 50' 00" R: 300'	
	T: 41.72' L: 82.90'	
23	S. 68° 58' 10" E.	46.54'

RIGHT OF WAY MAP

SILVERADO CANYON ROAD

ORANGE COUNTY, CALIFORNIA

SCALE: 1"=200' September 1946

T.B. 148

Checked-

NOTE:

Bearings on this map are based on an observation of Polaris, August 29, 1946. See Transit Book 148, page 32.