

Orange County Surveyor

MANHOLE DETAIL:

JOB NO: EC29962

DATE: 04/19/2024

CREW: J. Russo/ A. Payan

STREET: Animal Shelter Facility



TIME: 9:00 AM / PM

MANHOLE TYPE: Sewer

LID POINT NO: 20538

PHOTO NO: 20

PIPE MATERIAL: RCP

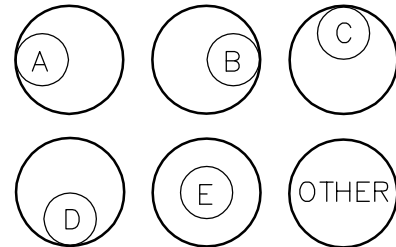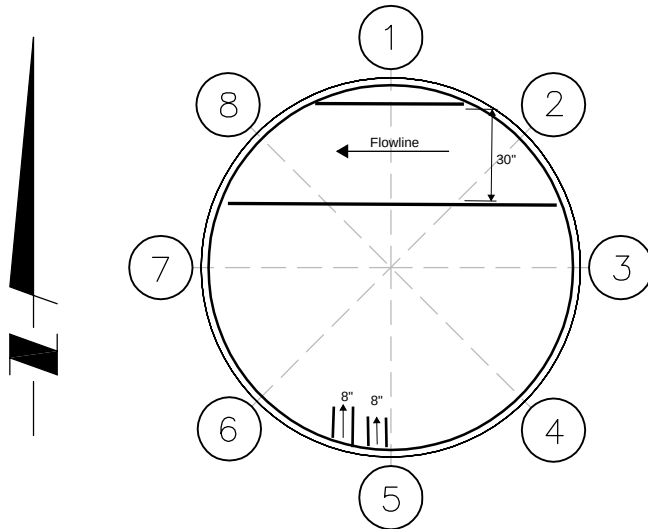

RIM OFFSET TYPE: D

POINT:	RIM ELEV:	INVERT:	F.L. ELEV:	PIPE DIA:	
1					WET / DRY
2	8 125.07	-16.20 +/-	108.87	30"	WET / DRY
3					WET / DRY
4					WET / DRY
5	125.07	-14.85'	110.22	8"	WET / DRY
(5a)	125.07	-6.15'	118.92	8"	WET / DRY
7					WET / DRY
8					WET / DRY
CNTR:					WET / DRY