

Block: 5458
Module: 91


W.M. 34W

CORNER RECORD

Document Number CR 835

City of UNINCORPORATED County of ORANGE, California

Brief Legal Description RANCHO TRABUCO CORNER NO 12

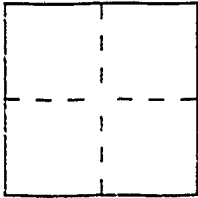

CORNER TYPE

Government Corner ☐ Control ☐
Meander ☐ Property ☐
Rancho ☒ Other ☐
Date of Survey FEB 1994

COORDINATES

(Optional)

N 2190251 784
E 6142940.039
Zone VI Datum NAD 83
Elev _____

Corner — Left as found ☐ Found and tagged ☐ Established ☐ Reestablished ☒ Rebuilt ☐


Identification and type of corner found Evidence used to identify or procedure used to establish or reestablish the corner
DESTROYED BY BRIDGE CONSTRUCTION. RESET PER
NOTES A/6-7 3031.

A description of the physical condition of the monument as found and as set or reset SET 2" ID. IP
WITH 2 1/2" OCS BRASS DISC IN OCS WELL MON. DN 12
STAMPED "RANCHO TRABUCO NO 12 RESET 2-94"

SURVEYOR'S STATEMENT

This Corner Record was prepared by me or under my direction in conformance with
the Land Surveyors' Act on MARCH 17 1994

Signed Daniel S. Cook LS or RCE Number L.S. 4964
EXPIRATION DATE 12-31-97

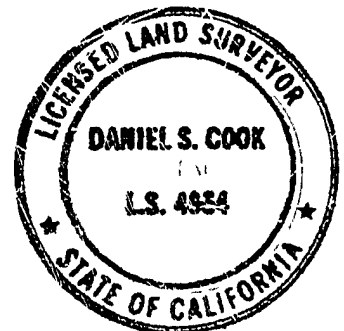

COUNTY SURVEYOR'S STATEMENT

This Corner Record was received MAY 13th 1994 and examined

and filed MAY 13th 1994
Signed John Canas Title COUNTY SURVEYOR



County Surveyor's Comment _____

