

CENTERLINE SURVEY

LIVE OAK CANYON ROAD
TRABUCO OAKS DRIVE
TRABUCO CANYON ROAD
PLANO TRABUCO ROAD

APRIL, 1976

EQUIPMENT

E.D.M. HP 3800 #5449
E.D.M. HP 3800 #3252
WILD T-2 #170522
WILD T-2 #160817

FIELD PARTY


G BEAIRD PTY. CH.
W. HARRIS T
H. LAZENBY CO
P. CHRISTENSEN CO

COUNTY SURVEY NO. 7030

DATE: 7/27/76

SEE PAGE 23


VICINITY MAP

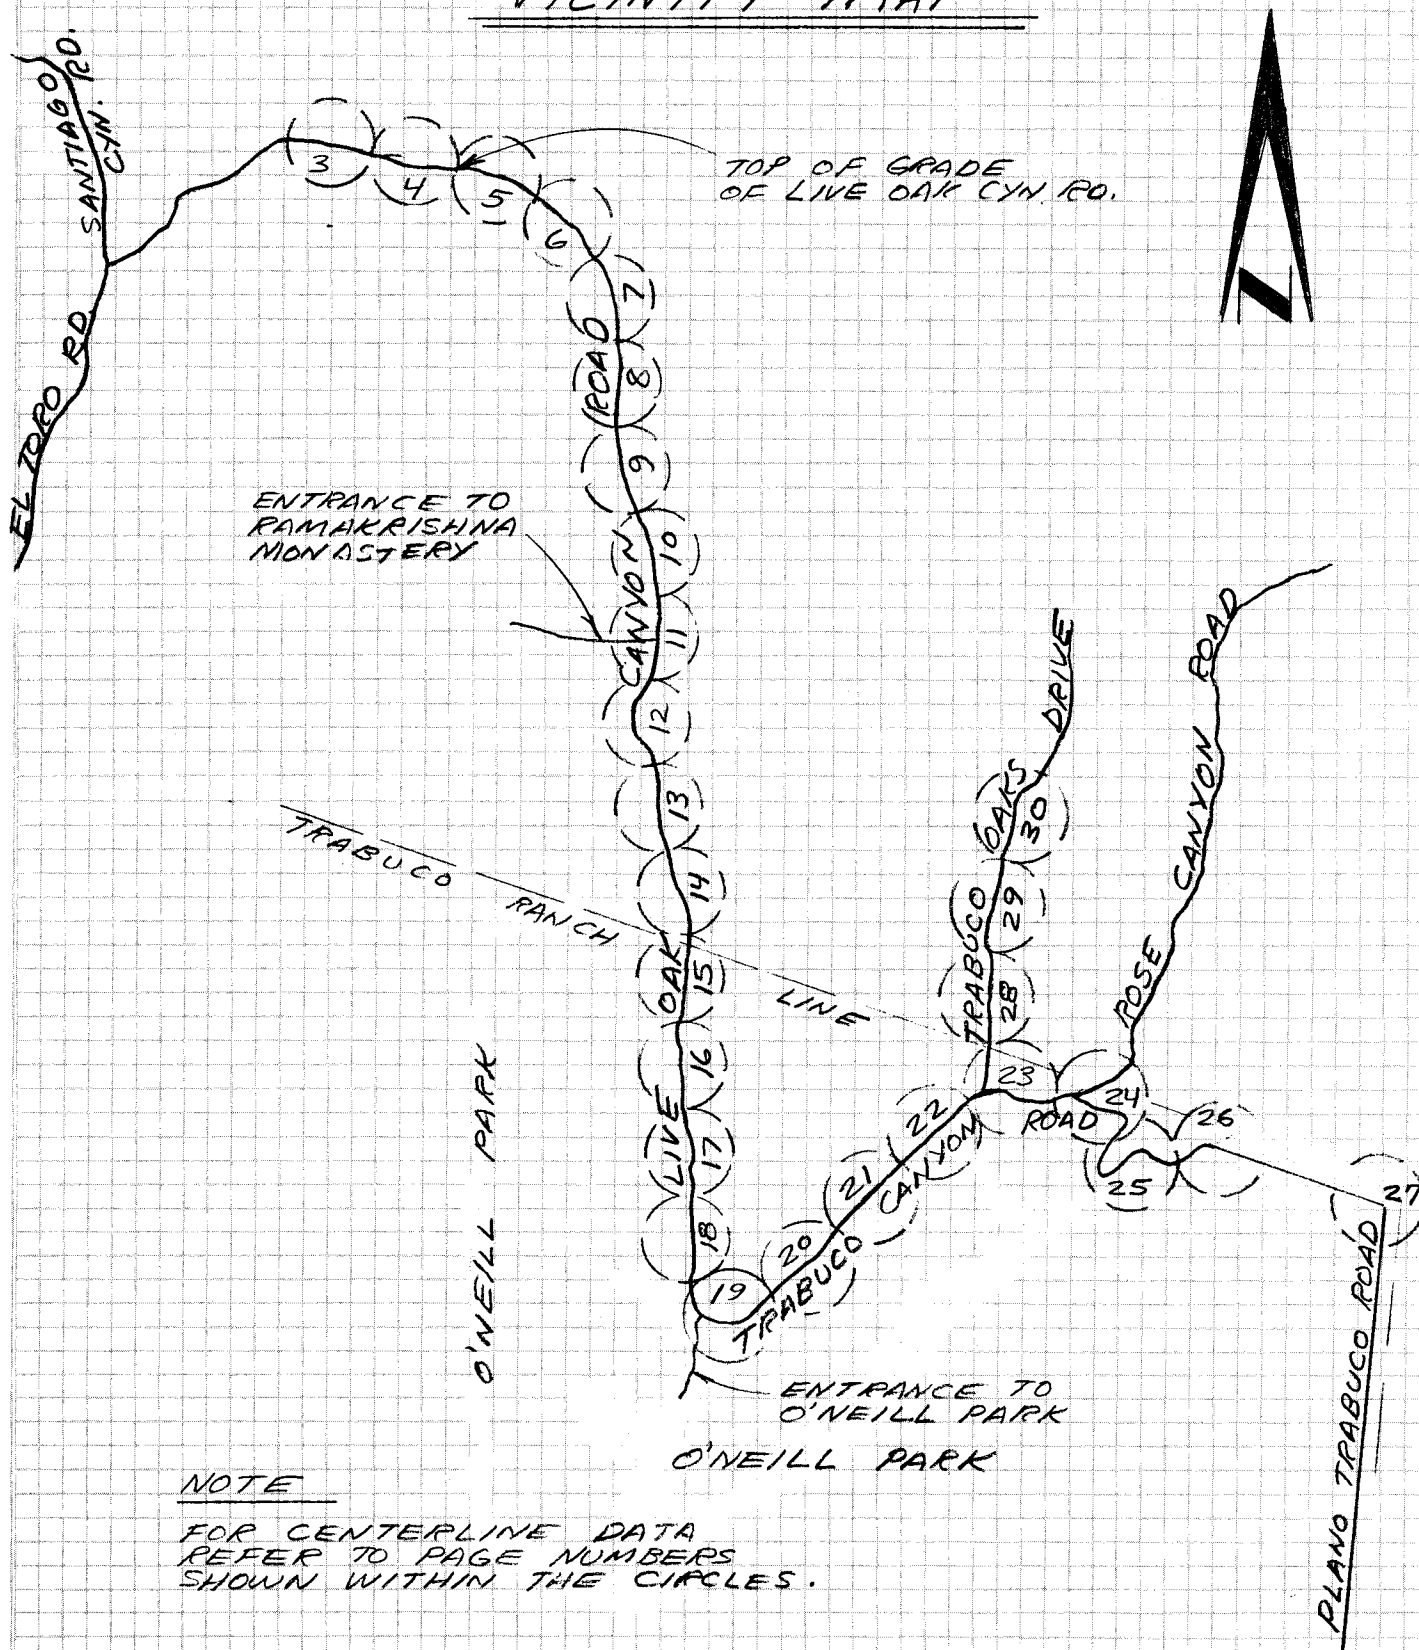

SURVEYED BY BEARD

DATE APRIL 1976

3 OF 30

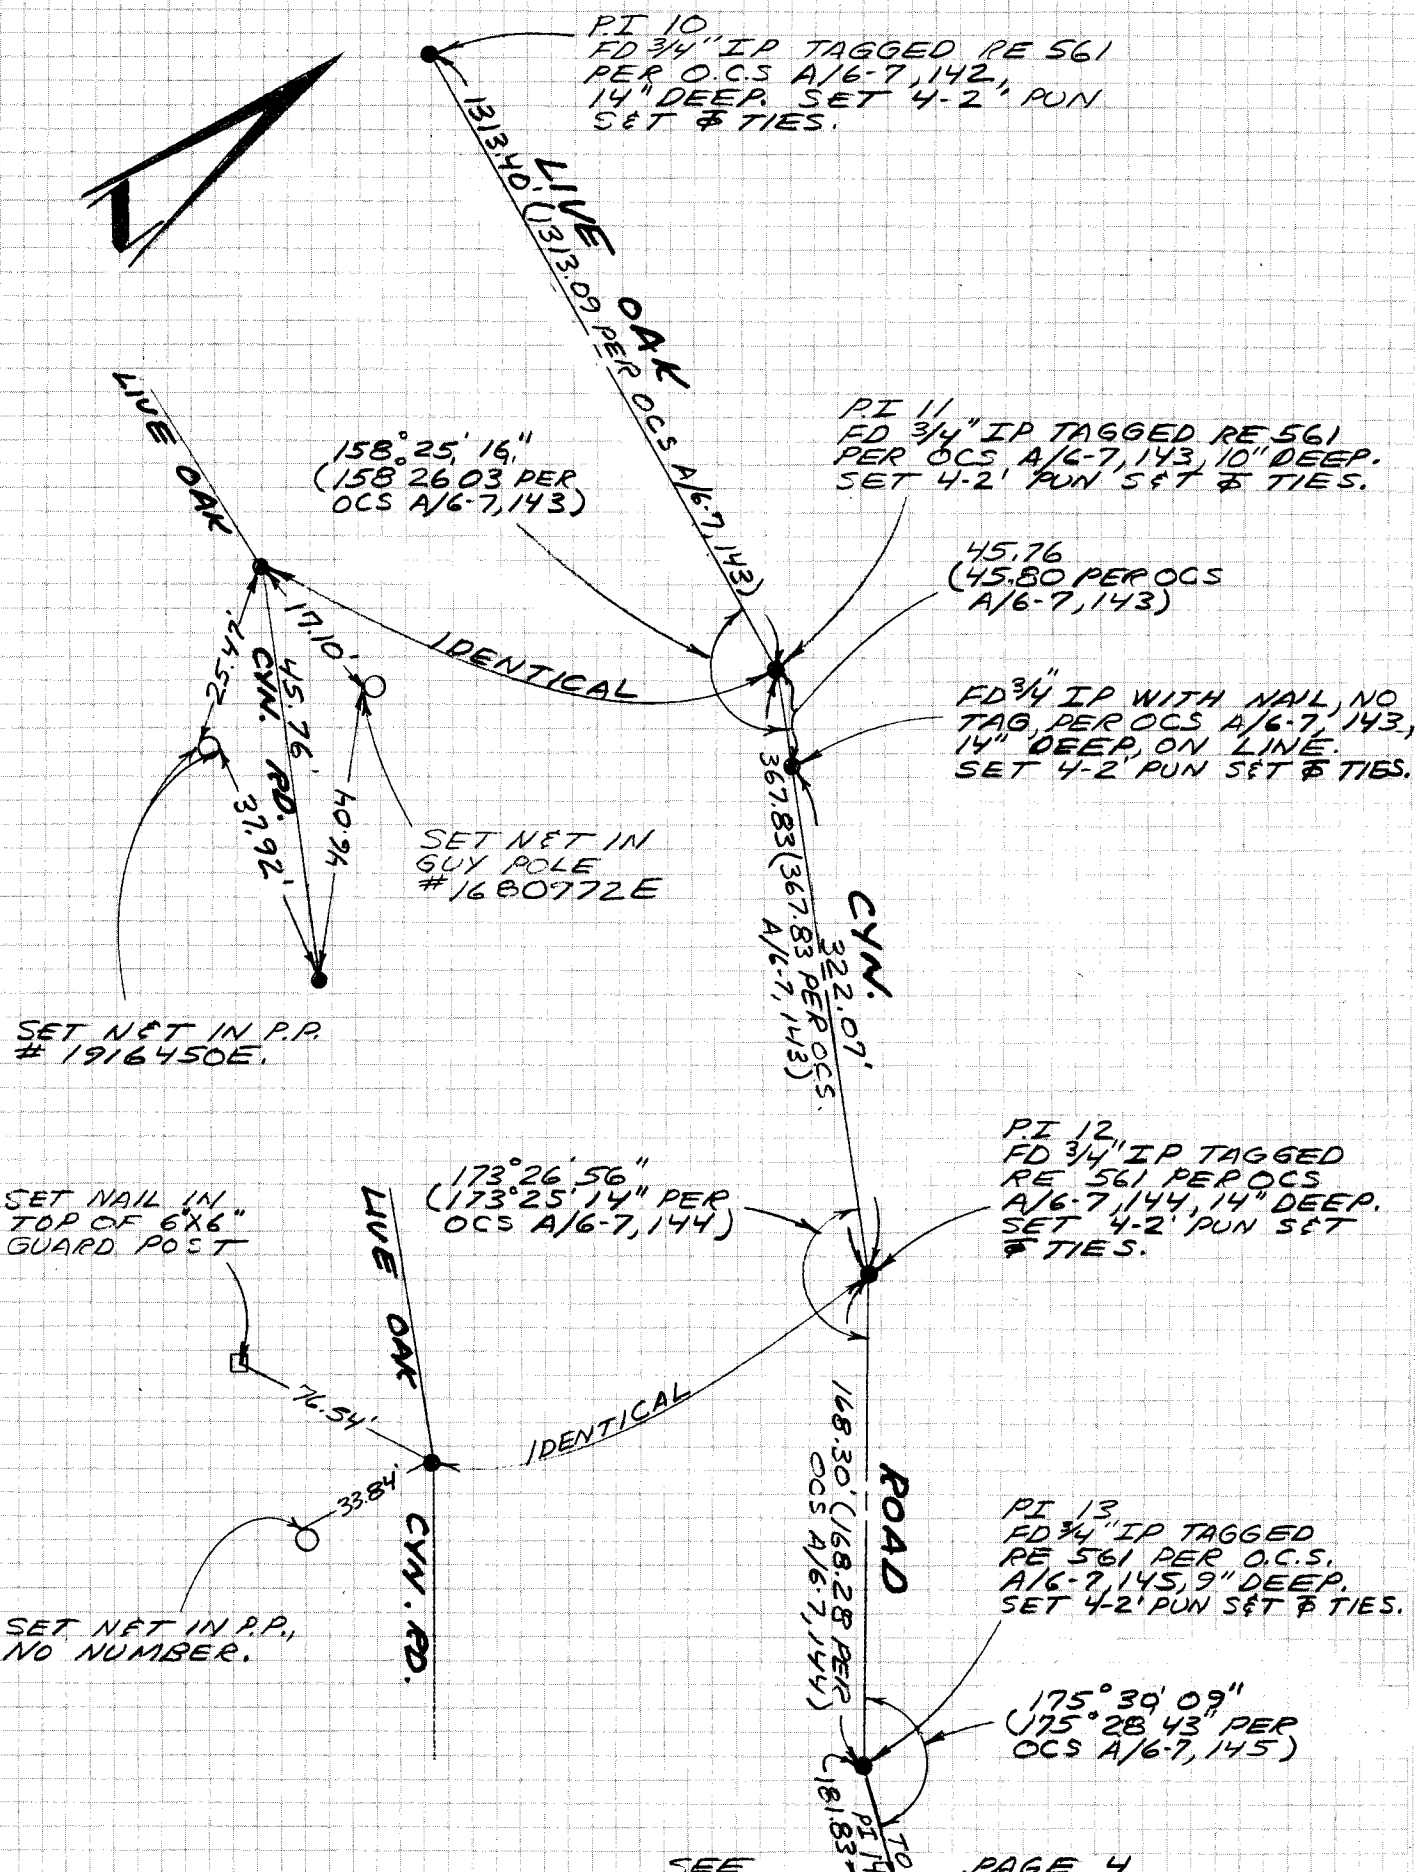


BEAIRD

APRIL, 1976

4 OF 30

SEE PAGE 3

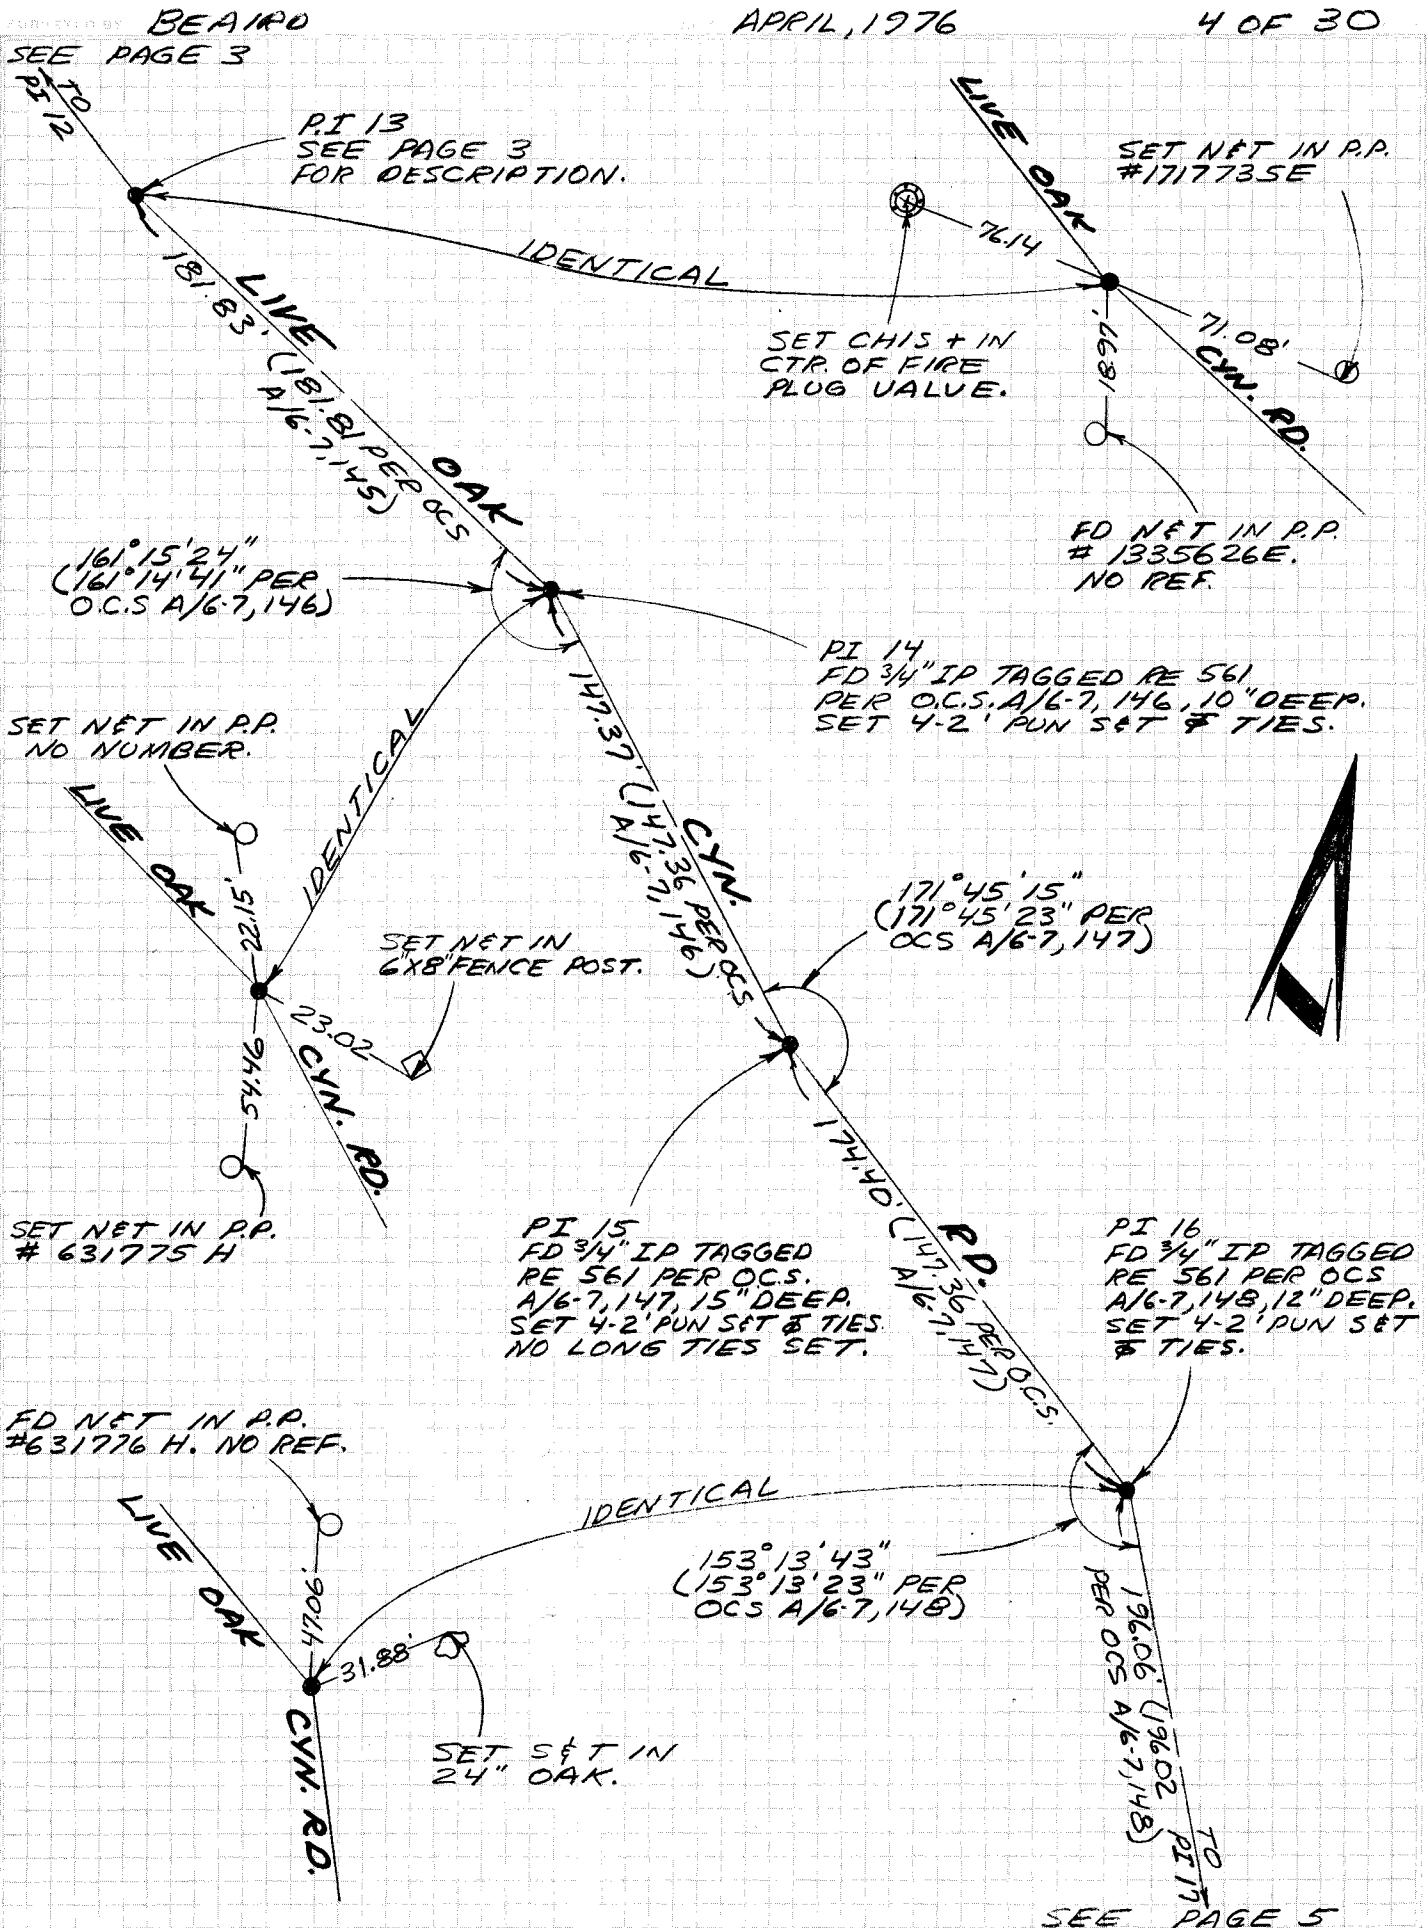


BEARD

APRIL, 1976

5 OF 30

SEE PAGE 4

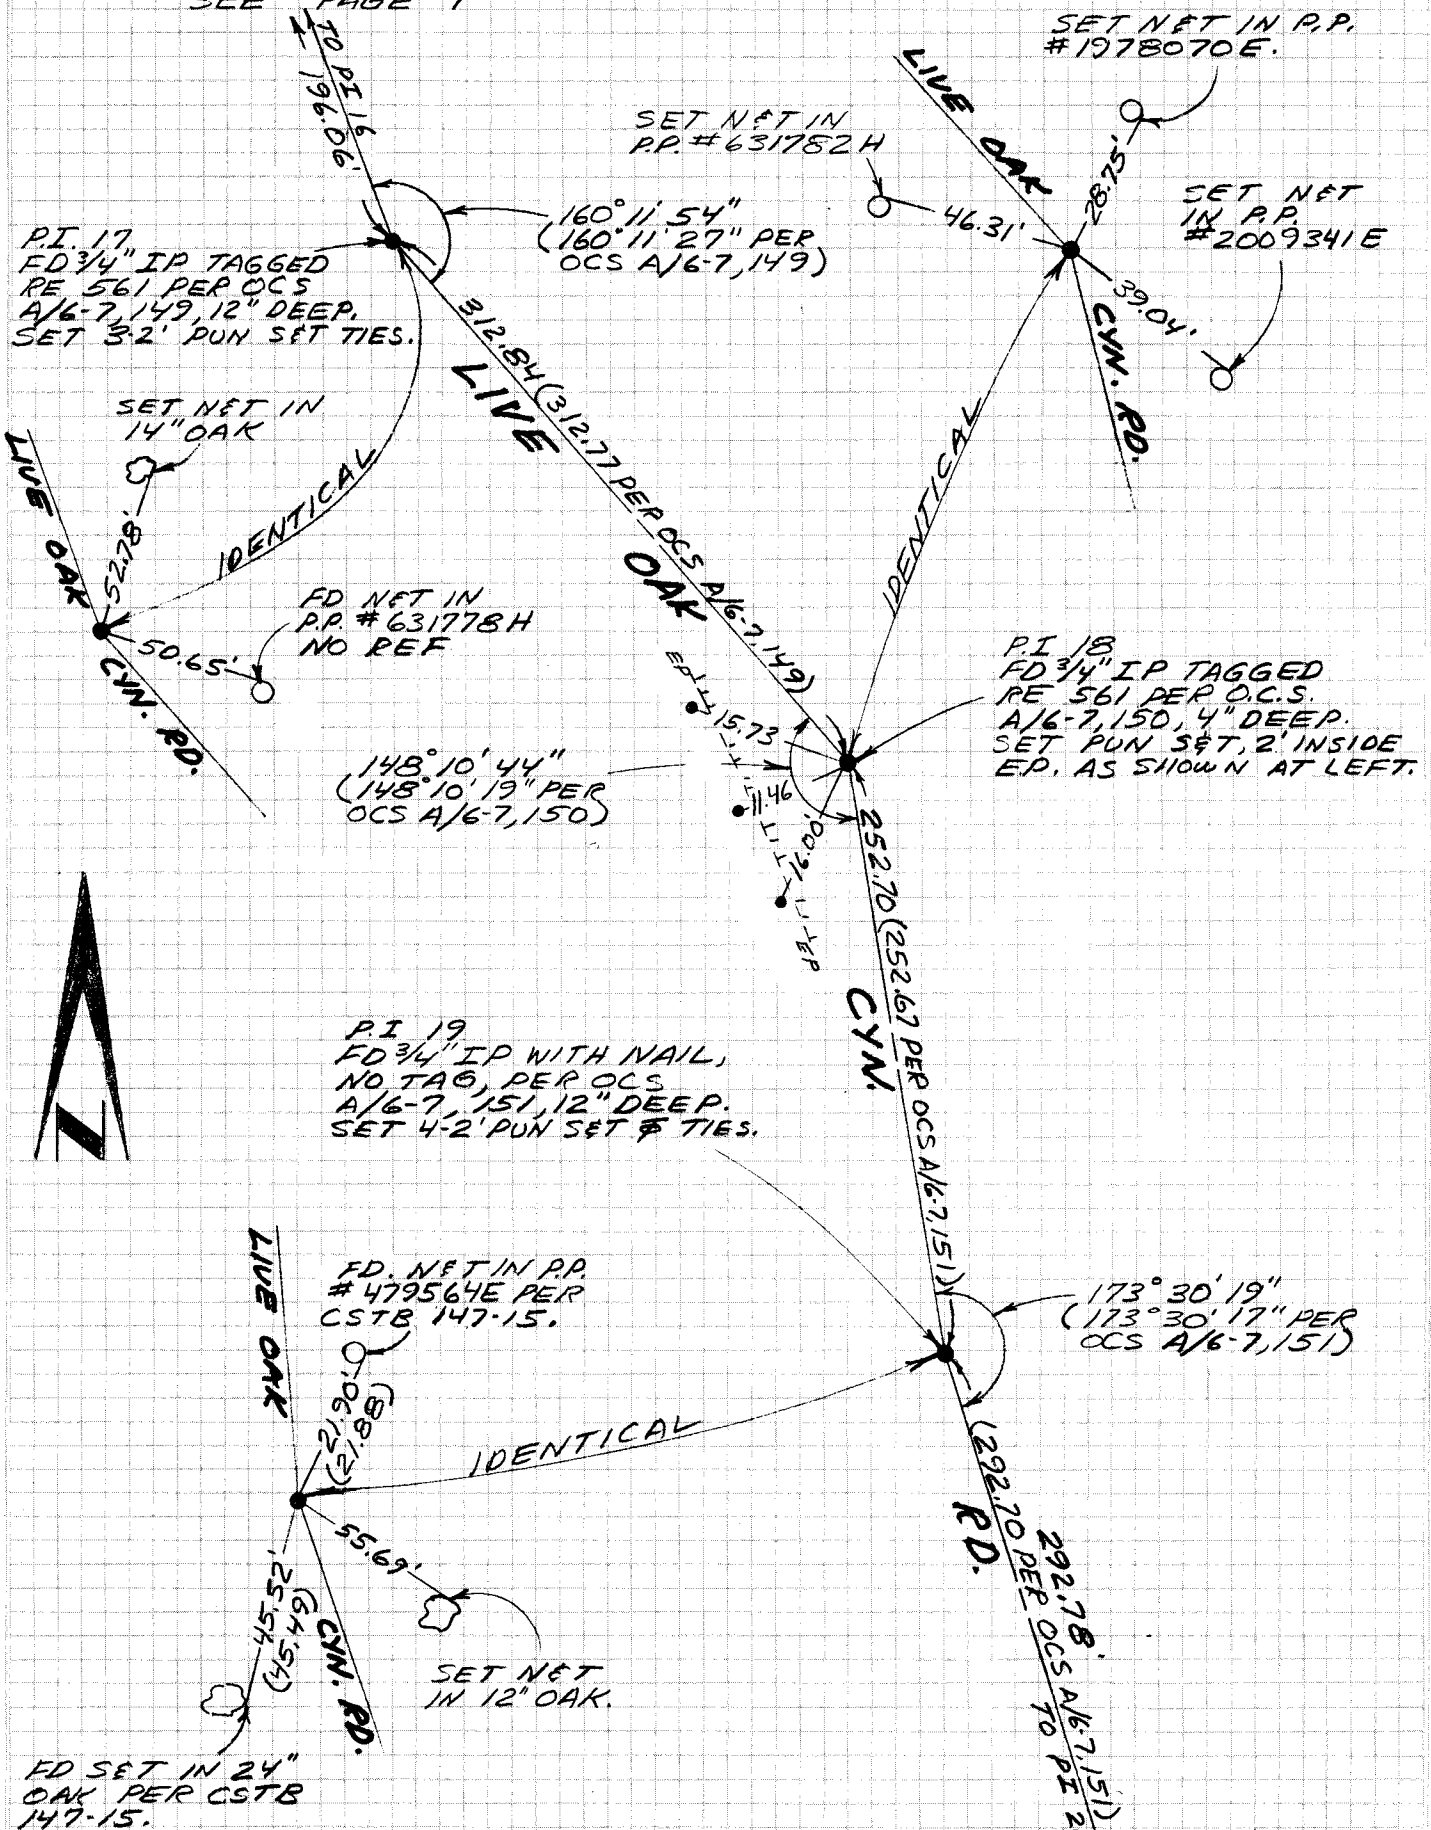

PAGE 5



REAR RD

DATE: APRIL, 1976

7 OF 30

SEE PAGE 6

PI 23
 FD NOTHING. ESTB
 AT INT. OF 3-10' NET
 TIES. SET 1" IP TAGGED
 ORANGE COUNTY SURVEYOR
 12" DEEP.

FD SPK IN 18" OAK
 PER CSTB 147-18.

150° 32' 30"
 (150° 31' 49" PER
 OCS A/6-7, 155)

FD SET IN 14" OAK
 PER CSTB 147-19

SET SET
 IN 12" OAK

SET SET
 IN 30" OAK

FD SET IN 30" OAK
 PER CSTB 147-18.

PI 24
 FD 3/4" IP WITH COPPER
 NAIL, NO TAG, PER O.C.S.
 A/6-7, 156, 12" DEEP.
 SET 4-2' PUN SET & TIES.

SET SET IN
 18" TWIN OAK

FD SPK IN 36"
 FORKED OAK
 PER CSTB 147-19


170° 54' 44"
 (170° 55' 07" PER
 OCS A/6-7, 157)

PI 25
 FD 3/4" IP WITH COPPER NAIL,
 NO TAG, PER OCS A/6-7, 157,
 12" DEEP. SET 4-2' PUN
 SET & TIES.

FD SET IN
 12" OAK PER
 CSTB 147-19

FD SET IN
 12" OAK
 PER CSTB
 147-19.

SEE PAGE 8



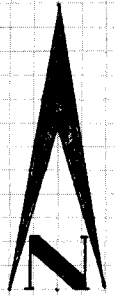


BEAIRD

APRIL, 1976

8 OF 30

SEE PAGE 7

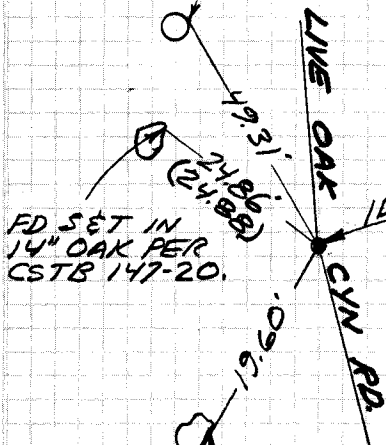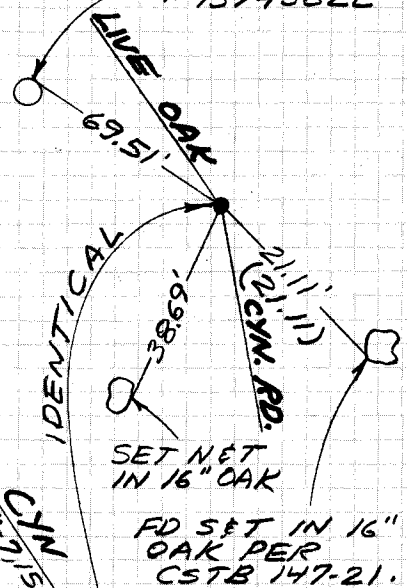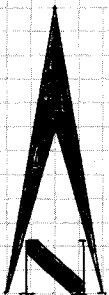SET NET IN
P.P. #1374375ESET NET IN
18" OAK.FD SET IN P.P.
#1374381E
NO REF.SET NET
IN 16" OAKFD 3/4" IP
TAGGED LS
3934, 6" DEEP.
NO REF.FD SET IN
16" OAK PER
CSTB 147-20.PI 26
FD 3/4" IP WITH COPPER NAIL,
NO TAG, PER OCS A/6-7, 158,
12" DEEP, SET 4-2' PUN SET
8 TIES.172° 48' 09"
(172° 48' 14" PER
OCS A/6-7, 158)PI 27
FD 3/4" IP WITH COPPER NAIL,
NO TAG, PER OCS A/6-7, 159,
14" DEEP, SET 3-2' PUN
SET TIES.158° 24' 28"
(158° 24' 47" PER
OCS A/6-7, 159)SET NET IN P.P.
#1374382ESET NET
IN 16" OAKFD SET IN 16"
OAK PER
CSTB 147-21.155° 01' 19"
(155° 02' 07" PER
OCS A/6-7, 160)PI 28
FD 3/4" IP WITH COPPER NAIL,
NO TAG, PER OCS A/6-7, 160,
12" DEEP, SET 3-2' PUN
SET TIES.

SEE PAGE 9

BEARD

APRIL, 1976

9 OF 30

SEE PAGE 8

FD SET IN
24" OAK. NO REF.CYN. RD.
12.12'LIVE OAK
41.55'
(41.59')

IDENTICAL

LIVE OAK
44.03'FD SPK IN
48" OAK PER
CSTB 147-22SET NET IN
RP #1374384EPI 30
FD 3/4" IP WITH COPPER
NAIL, NO TAG, PER O.C.S.
A/6-7, 162, 12" DEEP.
SET 4-2' PUN SET & TIES157°00'58"
(157°00'40" PER
OCS A/6-7, 162)SET NET IN
24" OAK.CYN. RD.
12.18'

1462

FD NET IN
RP #1374387E
NO REF.SET NET IN
18" OAK

LIVE OAK

IDENTICAL

229.28' (229.32)
PER OCS A/6-7, 163
TO PI 32


LIVE OAK CYN. RD.

PI 31
FD 3/4" IP WITH COPPER
NAIL, NO TAG, PER O.C.S.
A/6-7, 163, 12" DEEP
SET 4-2' PUN SET & TIES.170°44'51"
(170°44'12" PER
OCS A/6-7, 163)PI 29
FD 3/4" IP WITH COPPER
NAIL, NO TAG, PER O.C.S.
A/6-7, 161, 12" DEEP.
SET 4-2' PUN SET & TIES.176°09'01"
(176°09'23" PER
OCS A/6-7, 161)FD SET IN
14" SYC. PER
CSTB 147-23.SET NET IN RP
#1374385E

(38.49)

CYN. RD.
50.36'

IDENTICAL

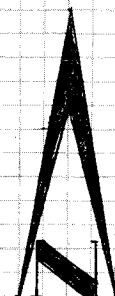FD SET IN BASE
OF 36" FORKED OAK
PER CSTB 147-23.SET SET IN
24" OAK.

SEE PAGE 10

BEAIRD

APRIL, 1976

10 OF 30

SEE

PAGE 9

PI 32
FD 3/4" IP WITH COPPER
NAIL, NO TAG, PER O.C.S.
A/6-7, 164, 12" DEEP.
SET 4-2' PUN SET & TIES.

188°55'09"
(188°52'51" PER
OCS A/6-7, 164)

SET NET IN
P.P.#1646234E

SET NET IN
P.P.#1646235E

FD SET
IN 30" SYC.
PER CSTB
147-25.

IDENTICAL

33.25
(33.28)

FD SET IN 30" OAK
PER CSTB 147-25.

PI 33
FD NOTHING. ESTB
PER 2-8" CONC NAIL TIES.
SET 2" IP TAGGED "ORANGE
COUNTY SURVEYOR", 16" DEEP
AND 3-6' PUN SET TIES ON
SURFACE.

149°07'52"
(149°09'51" PER
OCS A/6-7, 165)

SET NET IN GUY
POLE #1646242E

SET NET IN
P.P.#1646243E

SET NET IN
P.P.#1646241E.

FD SET IN 12"
OAK PER
CSTB 147-26.

FD SET IN
18" SYC PER
CSTB 147-25.

FD SET IN 12" SYC
PER CSTB 147-25.

PI 34
FD 3/4" IP WITH COPPER
NAIL, NO TAG, PER O.C.S.
A/6-7, 166, 12" DEEP.
SET 4-2' PUN SET & TIES.

166°04'25"
(166°05'38" PER
O.C.S A/6-7, 166)

TO PI 35
240.60 (240.55)
PER OCS A/6-7, 166

SEE


PAGE 11

BEAIRD

APRIL 1976

11 OF 30

SEE PAGE 10

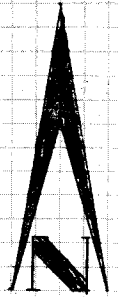SET NET IN
18" SYC.
 $157^{\circ}23'18''$
 $(157^{\circ}23'26'' \text{ PER}$
 OCS A/6-7, 167)
SET NET IN
R.P. 1646244E.

IDENTICAL

 P.I. 35
 FD $\frac{3}{4}$ " IP WITH COPPER
 NAIL, NO TAG, PER OCS
 A/6-7, 167, 12" DEEP.
 SET 3-3' PUN SET TIES.
FD SET IN 10"
FORKED OAK PER
CSTB 147-27.
 PI 36
 FD $\frac{3}{4}$ " IP WITH COPPER
 NAIL, NO TAG, PER OCS
 A/6-7, 168, 12" DEEP.
 SET 4-2' PUN SET TIES.

 PI 37
 FD $\frac{3}{4}$ " IP WITH
 COPPER NAIL, NO
 TAG, PER OCS A/6-7,
 169, 12" DEEP. SET
 4-2' PUN SET TIES.
SET NET IN
48" FORKED OAK.FD SET IN
18" OAK PER
CSTB 147-27.SET NET IN TOP OF
4X6 FENCE POST AT
ENTRANCE TO
PAMAKRISHNA MONASTERYSET NET IN
R.P. #1646246ESET NET IN
36" OAK


SEE PAGE 12

BEAIRD

APRIL 1976

12 OF 30

SEE PAGE 11

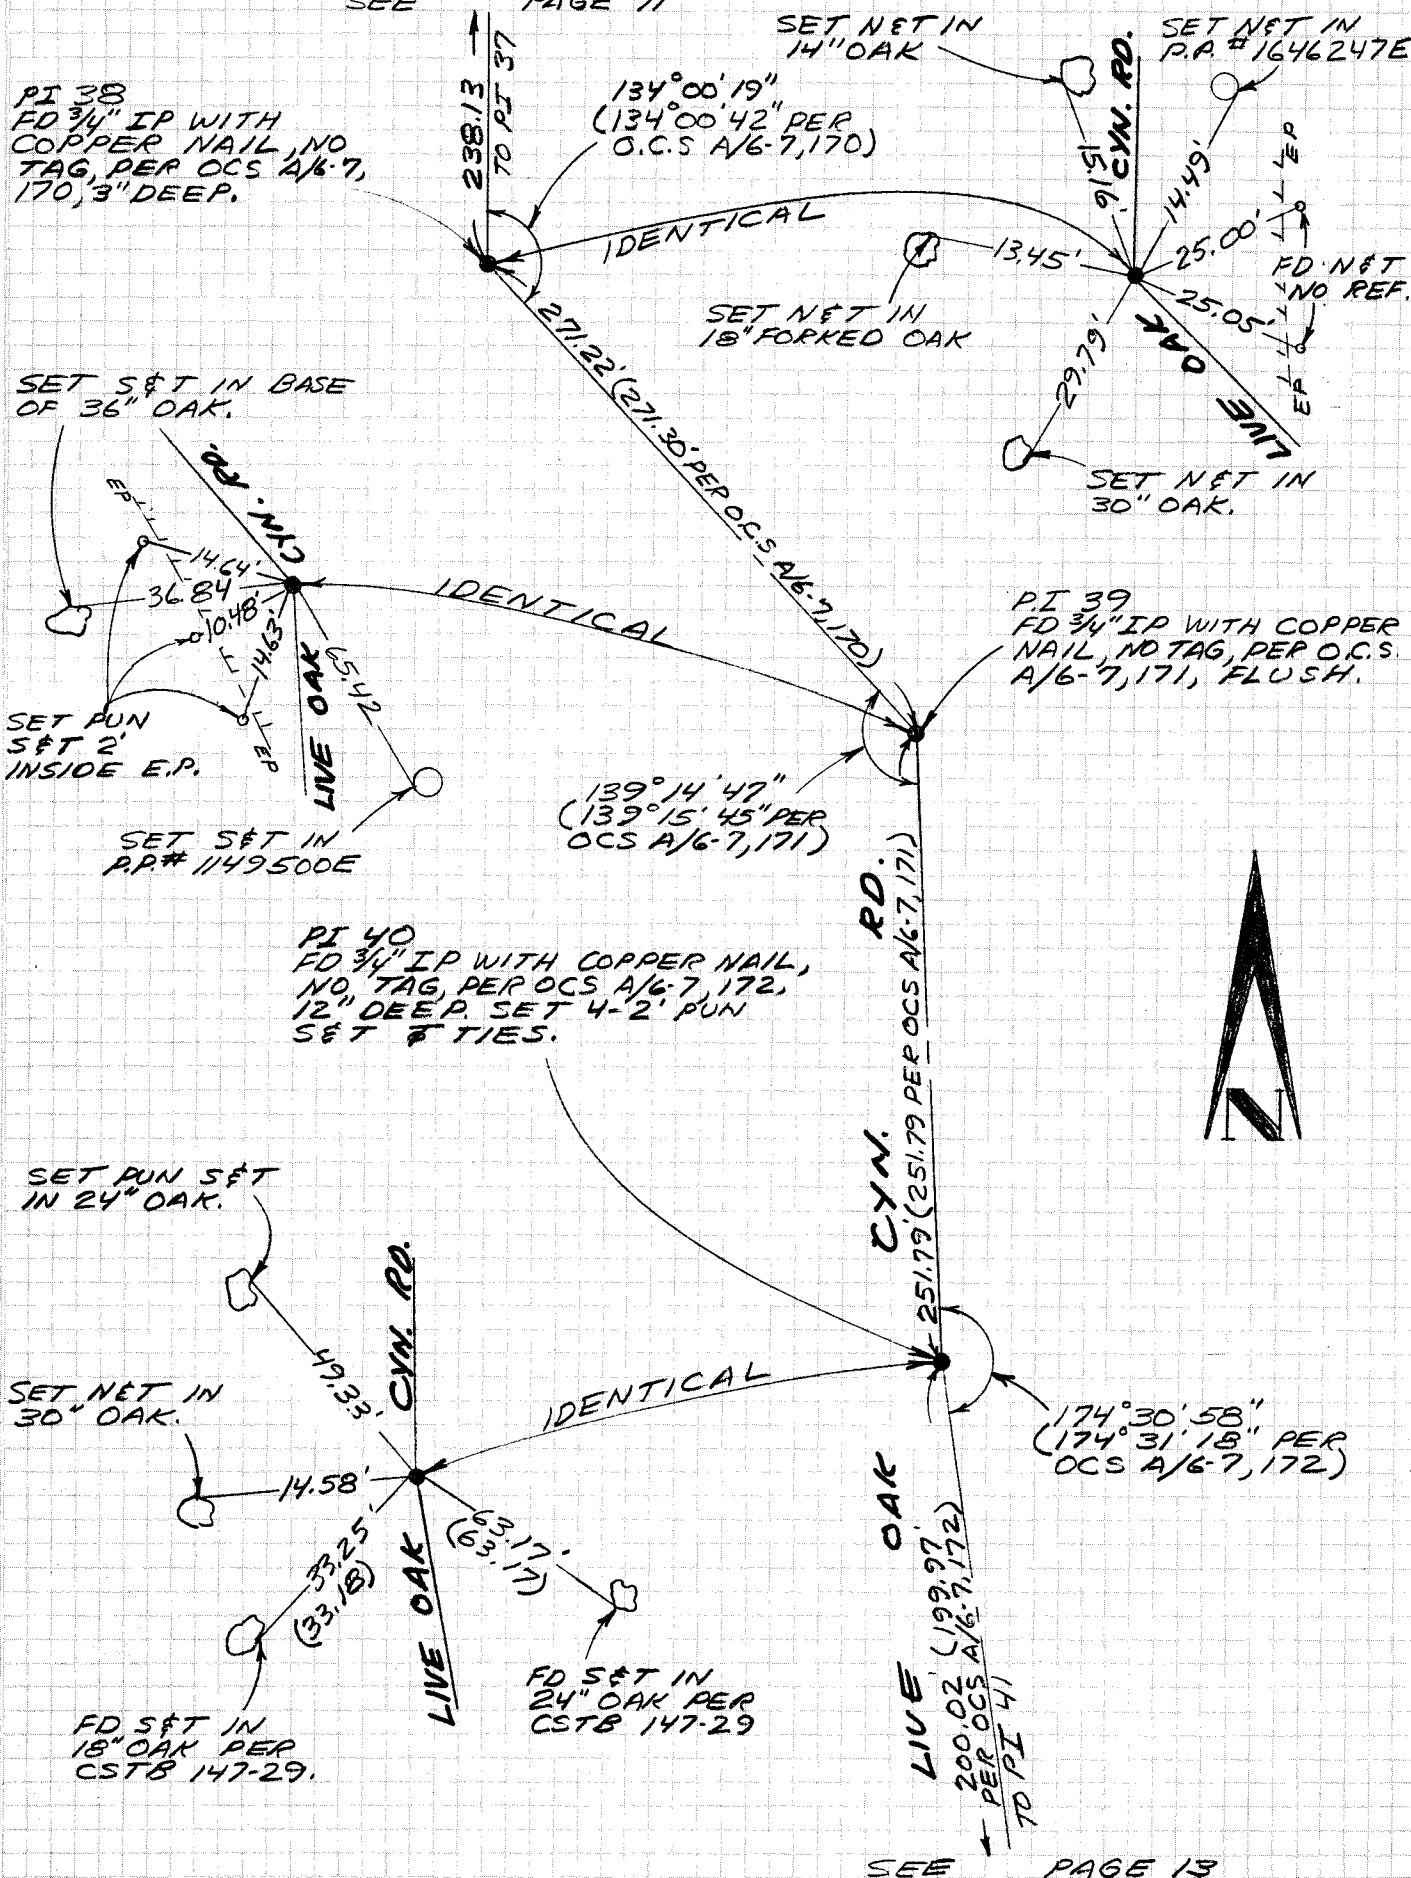


BEARD

APRIL 1976

13 OF 30

SEE PAGE 12

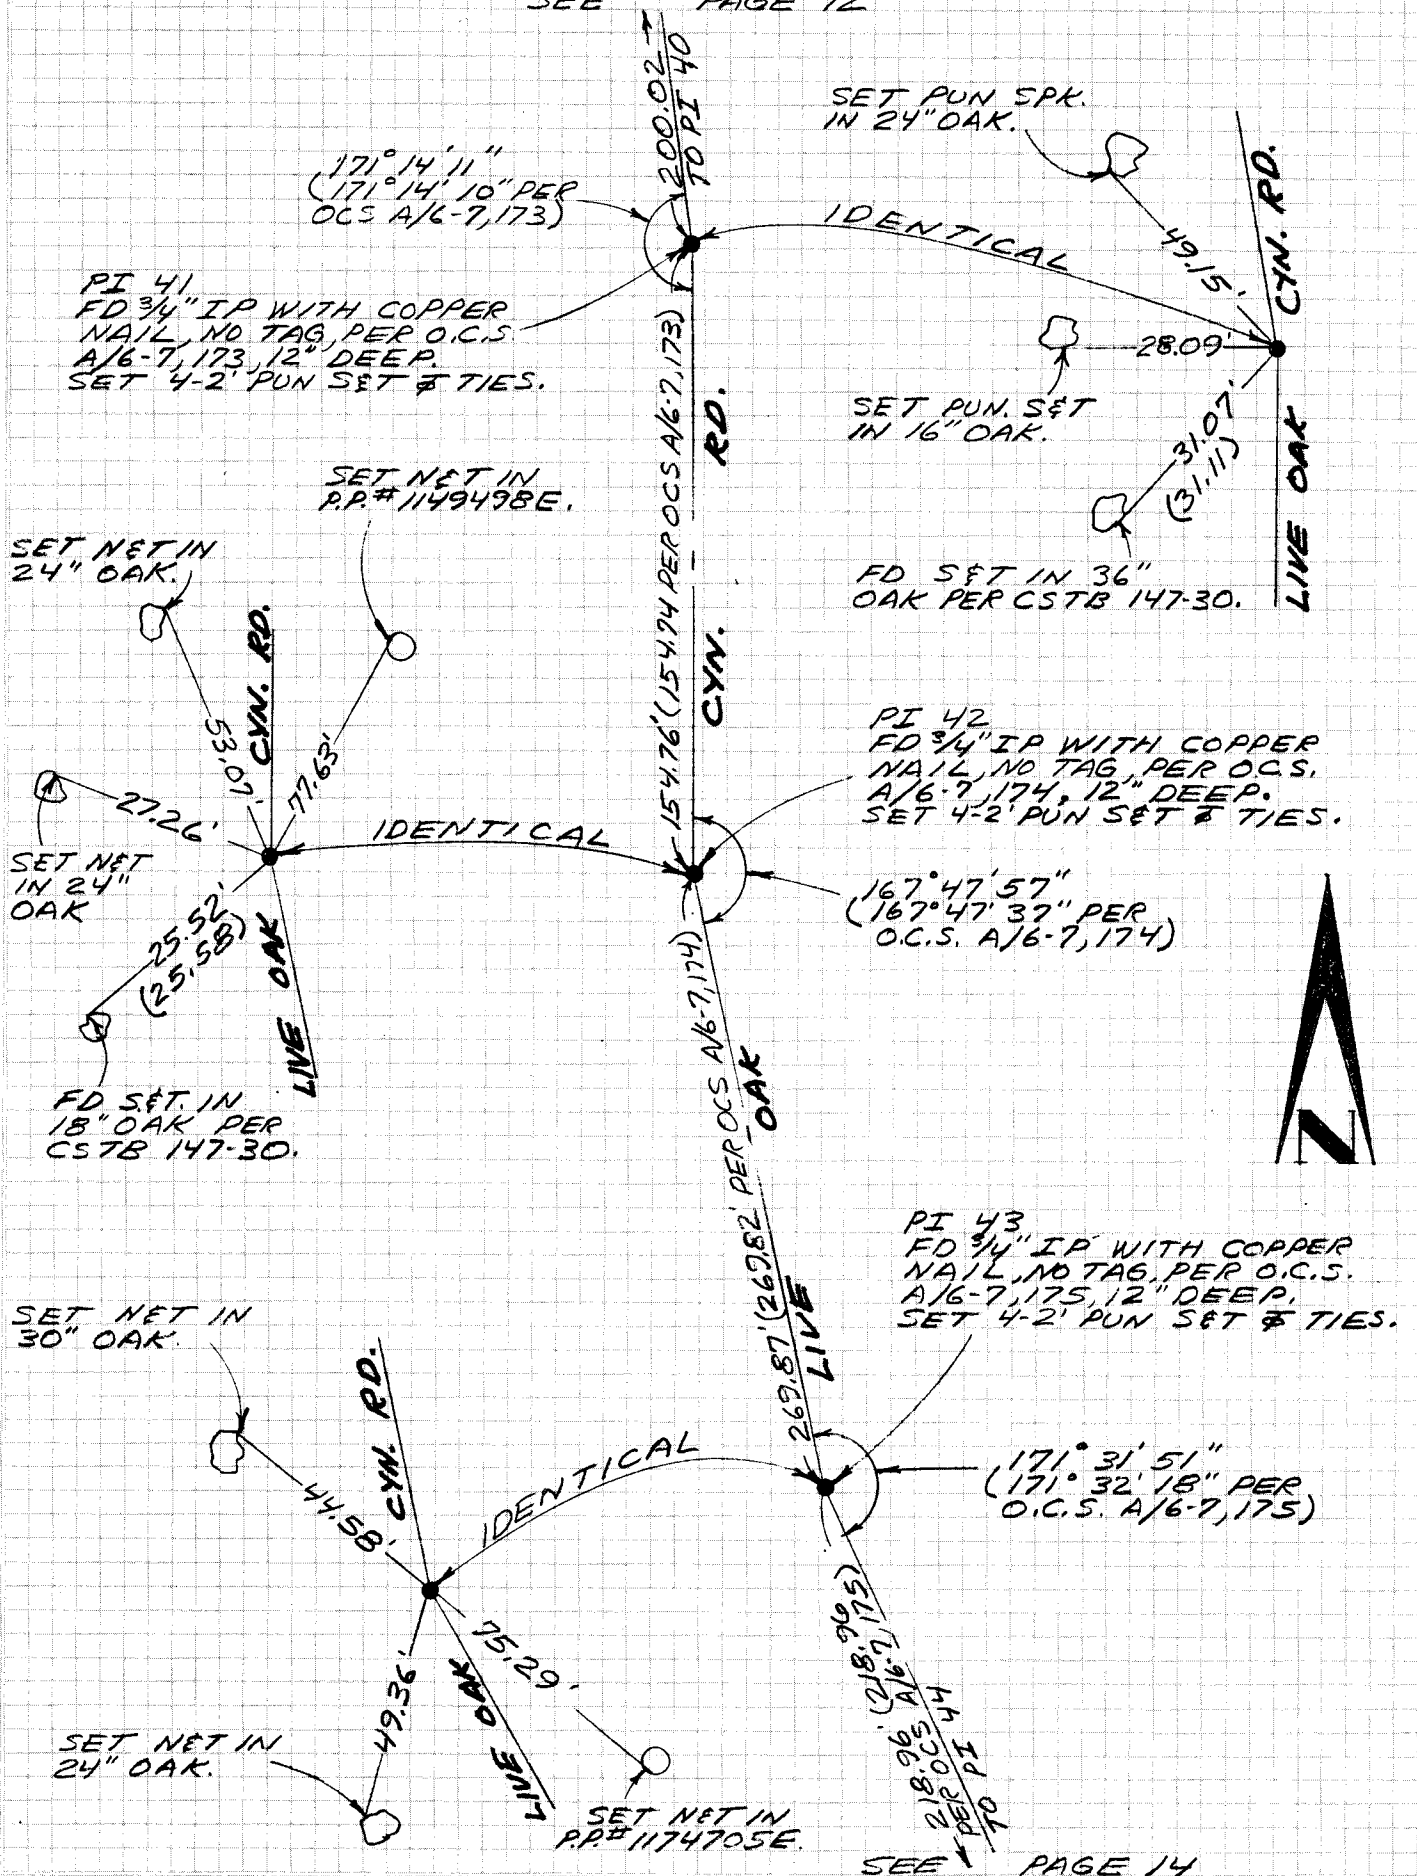

SEE PAGE 14

BEAIRD

APRIL 1976

14 OF 30

SEE PAGE 13

PI 44
FD 3/4" IP WITH
COPPER NAIL, NO
TAG, PER O.C.S.
A/6-7, 176, 12" DEEP.
SET 4-2' PUN SET
TIES.

168° 14' 17"
(168° 14' 46" PER
OCS A/6-7, 176)

IDENTICAL

FD NET IN
16" TWIN OAK
PER CSTB
147-31.

FD NET IN
24" OAK PER
CSTB 147-31

FD NET IN 24"
OAK PER CSTB 147-31.


57.70'
(57.60)

30.98'
(30.96)

21.86'
(27.85)

22.60'

FD NET IN 18"
OAK. NO REF.

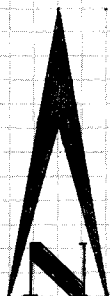

SET NET IN
12" FORKED OAK.

SET NET IN
24" OAK.

SET NET IN
48" OAK.

FD NET IN
24" OAK PER
CSTB 147-32

PI 46
FD 3/4" IP WITH COPPER NAIL,
NO TAG, PER O.C.S. A/6-7, 178,
12" DEEP. SET 4-2' PUN
SET TIES.

168° 54' 40"
(168° 53' 47" PER
O.C.S. A/6-7, 178)

PI 45
FD 3/4" IP WITH COPPER NAIL,
NO TAG, PER O.C.S. A/6-7, 177, 12"
DEEP. SET 3-3' PUN SET TIES.

162° 47' 52"
(162° 48' 04" PER
OCS A/6-7, 177)

FD BRASS NAIL IN STONE
HEADWALL PER CSTB 147-32.

SET NET IN
P.P. #1174704E

FD SET IN
36" OAK PER
CSTB 147-32.

SEE PAGE 15

REARND

APRIL 1976

15 OF 30

SEE PAGE 14

PI 47
FD 3/4" IP WITH COPPER
NAIL, NO TAG, PER O.C.S.
A/6-7, 179, 12" DEEP.
SET 4-2' PUN SET & TIES.



162° 00' 39"
(162° 01' 47" PER
O.C.S. A/6-7, 179)


PI 48
FD 3/4" IP WITH
COPPER NAIL, NO TAG,
PER OCS A/6-7, 180,
12" DEEP. SET 4-2'
PUN SET & TIES.

170° 02' 20"
(170° 02' 19" PER
O.C.S. A/6-7, 180)

FD 3/4" IP WITH COPPER
NAIL, NO TAG, PER O.C.S.
A/6-7, 180, 12" DEEP, ON
LINE. SET 4-2' PUN
SET & TIES. ~~THIS POINT
IS NOT ON THE RANCHO
TRABUCO LINE AS ESTD.
BY PARCEL MAP 55/K-18.~~

NOTE:

CORRECTED 3-84
TO AGREE WITH CANAS
SURVEY DATED 5-78 & HAYES
SURVEY DATED 2-79

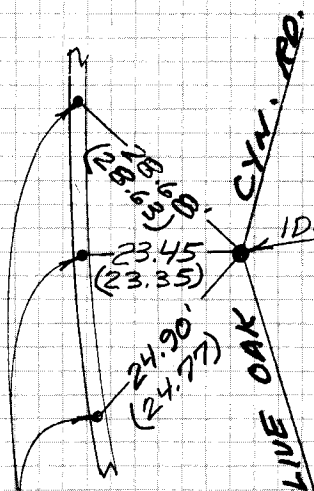

FD SET IN TOP OF
ROCK WALL PER
O.C.S. A/6-7, 181.

CYN.

OAK

LIVE

IDENTICAL

IDENTICAL

IDENTICAL

RANCHO TRABUCO

CYN. RD.

LIVE OAK

CYN. RD.

LIVE OAK

FD CHIST IN TOP
6" DIA. GUARD POST,
NO REF.

FD NET IN
R.P., NO NUMBER,
PER CSTB
147.33.

FD NET IN
18" OAK PER
CSTB 147.33.

FD NET IN R.P.
#990092E PER
CSTB 147.33

FD NET IN R.P.
#990091E PER
CSTB 147.33.

FD SPK IN 24"
SYC. PER CSTB
147.33.

FD SET IN
18" OAK PER
CSTB 147.33.

154° 09' 21"
(154° 08' 58" PER
O.C.S. A/6-7, 181)

PI 49
FD 3/4" IP WITH COPPER NAIL,
NO TAG, PER O.C.S. A/6-7, 181,
12" DEEP. SET 3-5' PUN
SET TIES.

* CHANGED BY J. CANAS
3-22-84

SEE PAGE 16

BEAIRD

APRIL 1976
SEE PAGE 15

16 OF 30



PI 50
FD NOTHING. ESTB POINT
PER TIES SHOWN ON O.C.S
A/6-7, 182. SET 2" IP
TAGGED "ORANGE COUNTY
SURVEYOR", 12" DEEP, WITH
3-5' PUN S&T TIES ON E.P.

$144^{\circ} 11' 46''$
($144^{\circ} 11' 02''$ PER
OCS A/6-7, 182)

IDENTICAL

FD LET IN TOP OF
ROCK WALL PER
OCS A/6-7, 182.

PI 51
FD $\frac{3}{4}$ " IP WITH COPPER NAIL,
NO TAG, PER OCS A/6-7, 183,
12" DEEP. SET 3-3' PUN
S&T TIES.

$159^{\circ} 06' 41''$
($159^{\circ} 06' 10''$ PER
O.C.S A/6-7, 183)

FD. LET IN TOP
OF ROCK WALL
PER O.C.S. A/6-7, 183.

PI 52
FD $\frac{3}{4}$ " IP WITH COPPER NAIL,
NO TAG, PER O.C.S A/6-7, 184,
12" DEEP. SET 4-2' PUN
S&T TIES.

$163^{\circ} 09' 28''$
($163^{\circ} 09' 48''$ PER
O.C.S A/6-7, 184)

FD. LET IN TOP
OF ROCK WALL
PER OCS A/6-7, 184.

SEE PAGE 17

BEAIRD

APRIL 1976


17 OF 30

SEE PAGE 16

P.I. 53
FD NOTHING. ESTB
POINT PER TIES SHOWN
ON O.C.S. A/6-7, 185. SET
2" IP TAGGED "ORANGE"
COUNTY SUPERVISOR, 12" DEEP.
WITH 3-2' PUN SFT TIES.

$158^{\circ}21'36''$
($158^{\circ}21'28''$ PER
OCS A/6-7, 185)

SET PUN SFT.
IN E.P.

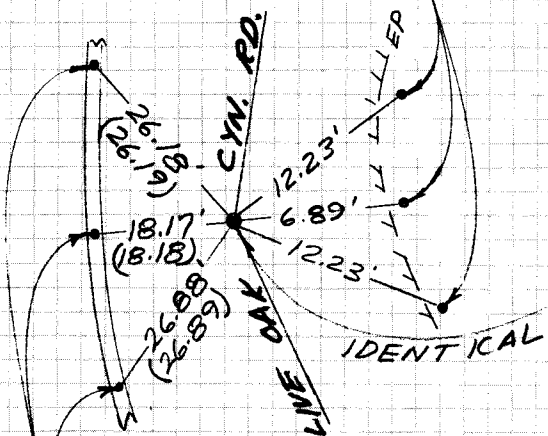


FD LET IN TOP
OF ROCK WALL
PER OCS A/6-7, 186.

P.I. 54
FD 3/4" IP WITH COPPER NAIL,
NO TAG, PER O.C.S. A/6-7, 186,
10" DEEP.

$147^{\circ}10'51''$
($147^{\circ}10'44''$ PER
OCS A/6-7, 186)

P.I. 55
FD 3/4" IP WITH COPPER
NAIL, NO TAG, PER O.C.S.
A/6-7, 187, 12" DEEP.
SET 3-2' PUN SFT TIES.

$155^{\circ}03'04''$
($155^{\circ}03'13''$ PER
O.C.S. A/6-7, 187)

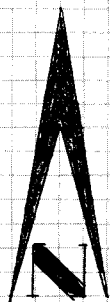

552.49' (552.47'
PER OCS A/6-7, 187)
TO P.I. 56

SEE PAGE 18

IDENTICAL

FD LET IN TOP
OF ROCK WALL
PER O.C.S. A/6-7, 185.

IDENTICAL

FD LET IN TOP
OF ROCK WALL
PER O.C.S. A/6-7, 187.

SURVEYED BY BEAIRD

APRIL 1976
PAGE 17


18 OF 30

PI 56
FD 3/4" IP WITH COPPER
NAIL, NO TAG, PER O.C.S.
A/6-7, 188, 12" DEEP.
SET 4-2' PUN SET & TIES.

163° 48' 26"
(163° 48' 12" PER
OCS A/6-7, 188)

SEE
552.49'
TO PI 55

IDENTICAL

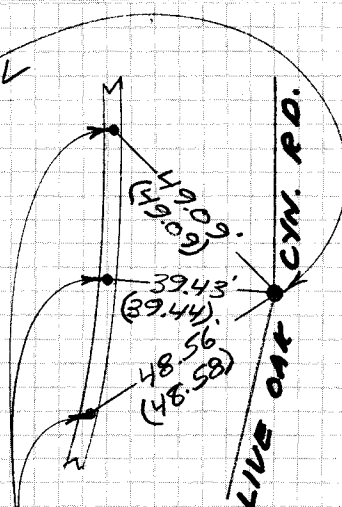

FD LET IN TOP
OF ROCK WALL
PER O.C.S. A/6-7, 188.


FD NAIL IN 12"
OAK PER OCS
A/6-7, 189.

IDENTICAL

SET PUN
SET IN
EP.

PI 57
FD 3/4" IP, NO NAIL, NO
TAG PER OCS A/6-7, 189,
4" DEEP.

146° 34' 53"
(146° 34' 50" PER
OCS A/6-7, 189)

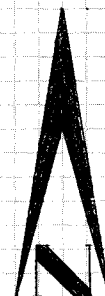

FD NET IN
P.P. #990076E
PER O.C.S.
A/6-7, 189.

FD NET IN
14" OAK PER
OCS A/6-7, 189.

293.48 (293.45 PER O.C.S. A/6-7, 189)
CYN.
OAK
LIVE
347.29 (347.32 PER O.C.S. A/6-7, 190)
LIVE

SET NET IN
30" OAK.

SET NET IN
24" TWIN OAK.

PI 58
FD 3/4" IP WITH NAIL,
NO TAG, PER OCS
A/6-7, 190, 22" DEEP.

149° 55' 47"
(149° 55' 53" PER
OCS A/6-7, 190)

TO PI 59
446.89 (446.91 PER O.C.S. A/6-7, 190)

IDENTICAL

SET NET IN
PP #1678242E.

SET NET IN
GUY POLE
#2044574E.


SEE PAGE 19

SURVEYED BY BEAIRD


DATE APRIL 1976

19 OF 30


SEE PAGE 18

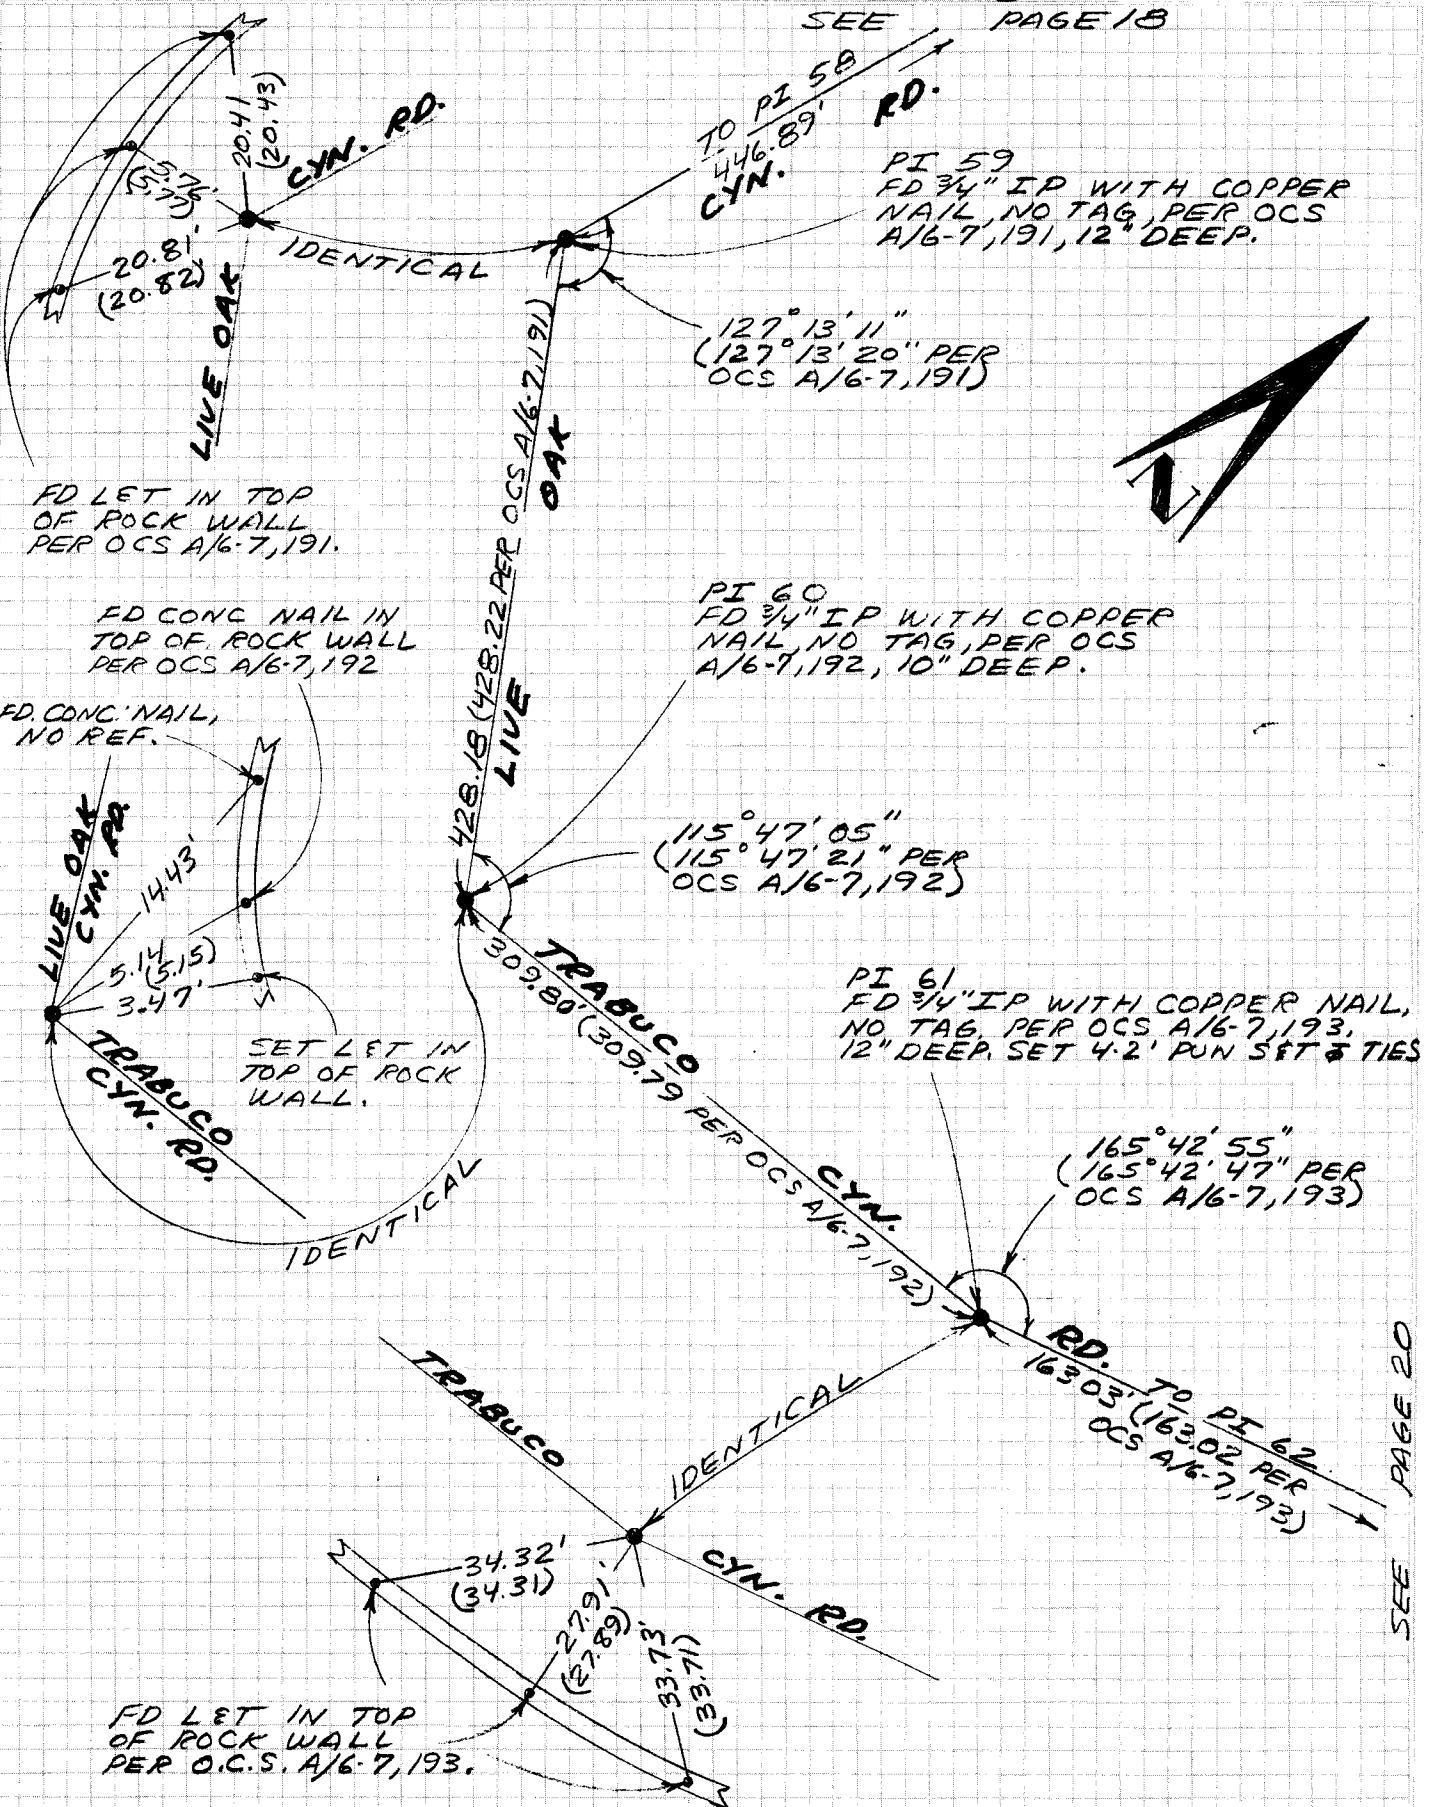


SEE PAGE 20

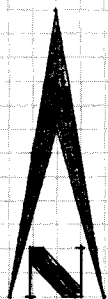

PI 64
FD 3/4" IP WITH COPPER
NAIL, NO TAG, PER O.C.S.
A/6-7, 196, 12" DEEP.
SET 4-2' PUN SET & TIES

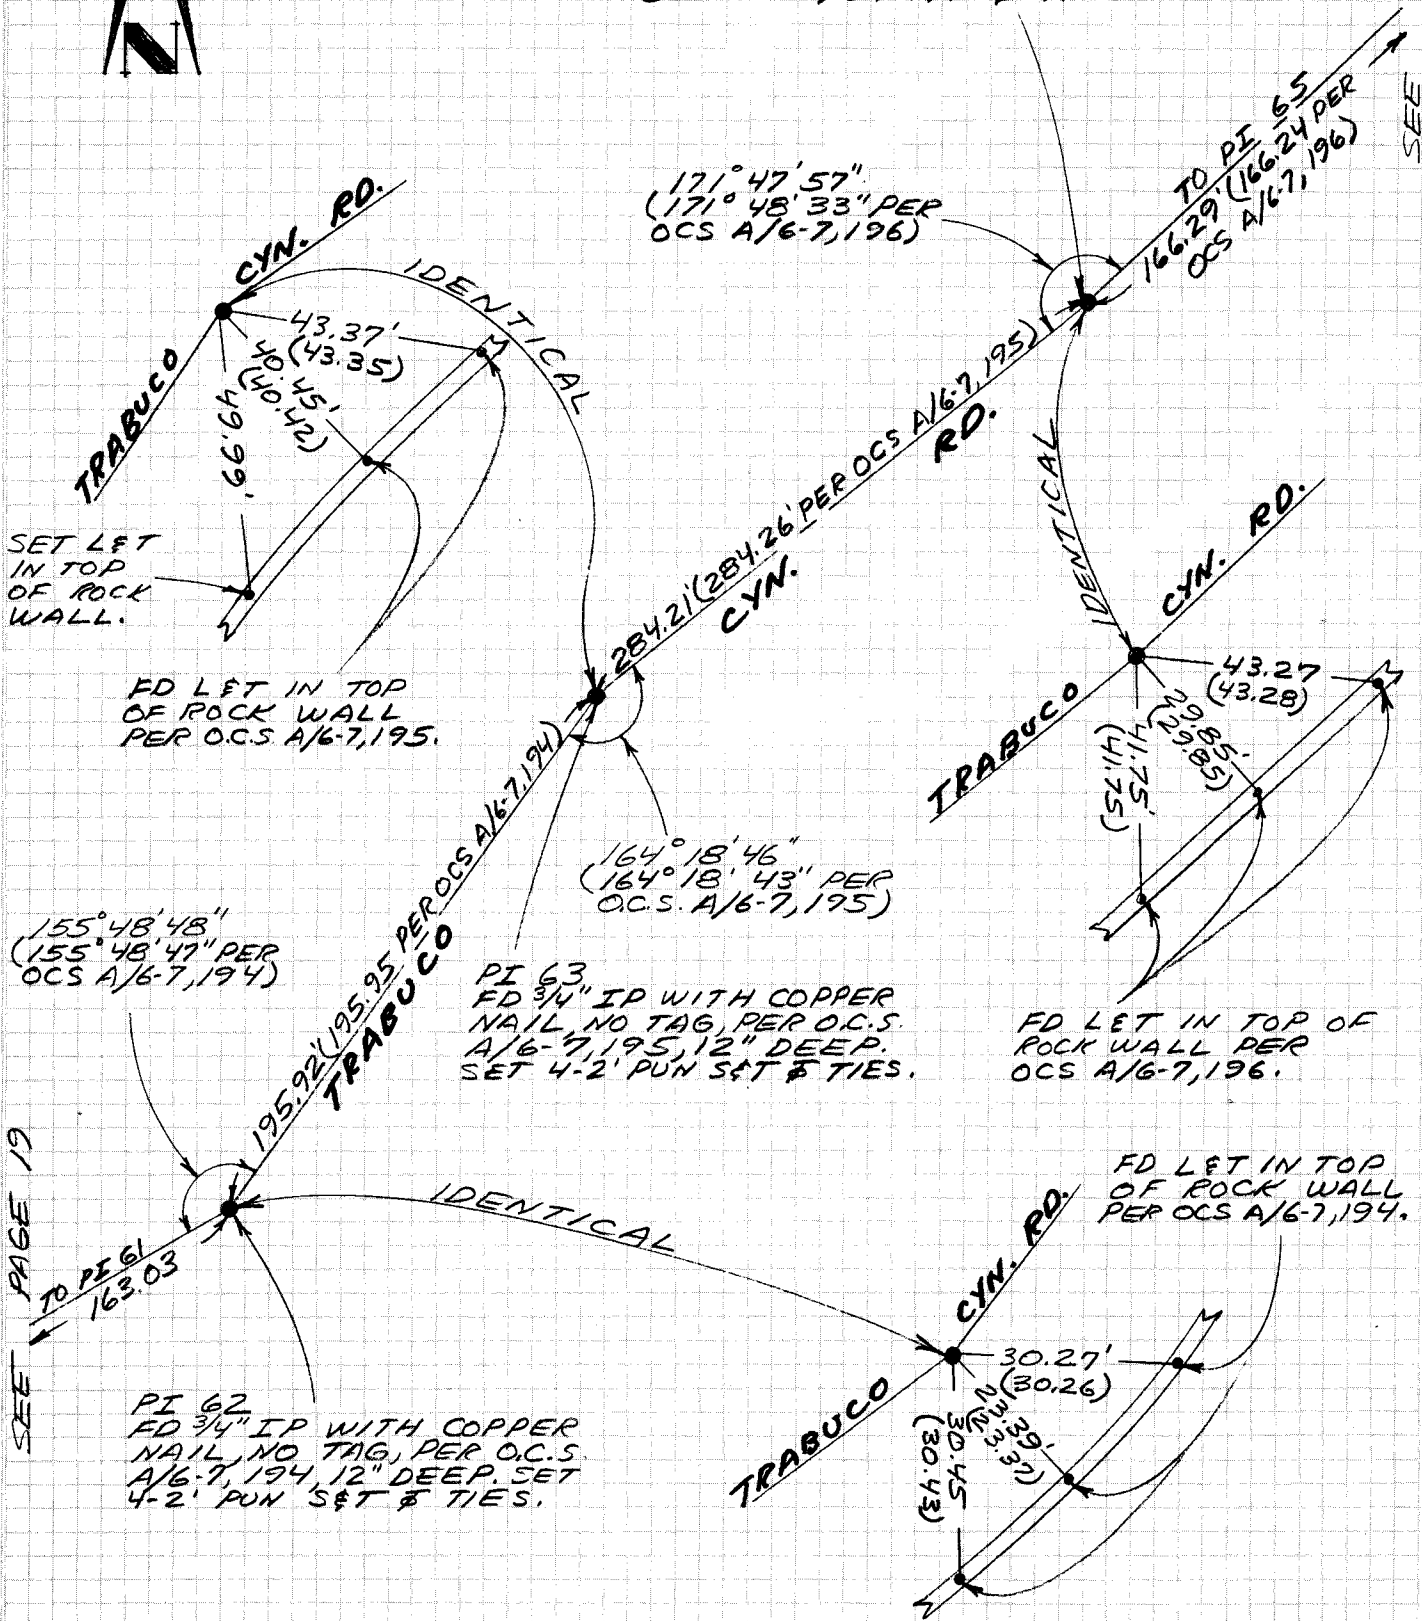

SEE PAGE 22

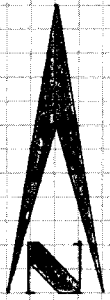

PI 67
FD 3/4" IP WITH COPPER
NAIL, NO TAG, PER O.C.S.
A/6-7, 199, 12" DEEP.
SET 4-2' PUN SET & TIES.

FD LET IN TOP
OF ROCK WALL
PER OCS A/6-7, 199.

155° 23' 40"
(155° 24' 30" PER
OCS A/6-7, 198)


FD LET IN TOP
OF ROCK WALL
PER OCS
A/6-7, 197.

FD LET IN TOP
OF ROCK WALL
PER OCS A/6-7, 198.

PI 66
FD 3/4" IP WITH COPPER
NAIL, NO TAG, PER O.C.S.
A/6-7, 198, 16" DEEP.
SET 3-3' PUN SET & TIES.

PI 65
FD 3/4" IP WITH COPPER
NAIL, NO TAG, PER O.C.S.
A/6-7, 197, 13" DEEP.
SET 4-2' PUN SET & TIES.


SEE PAGE 20

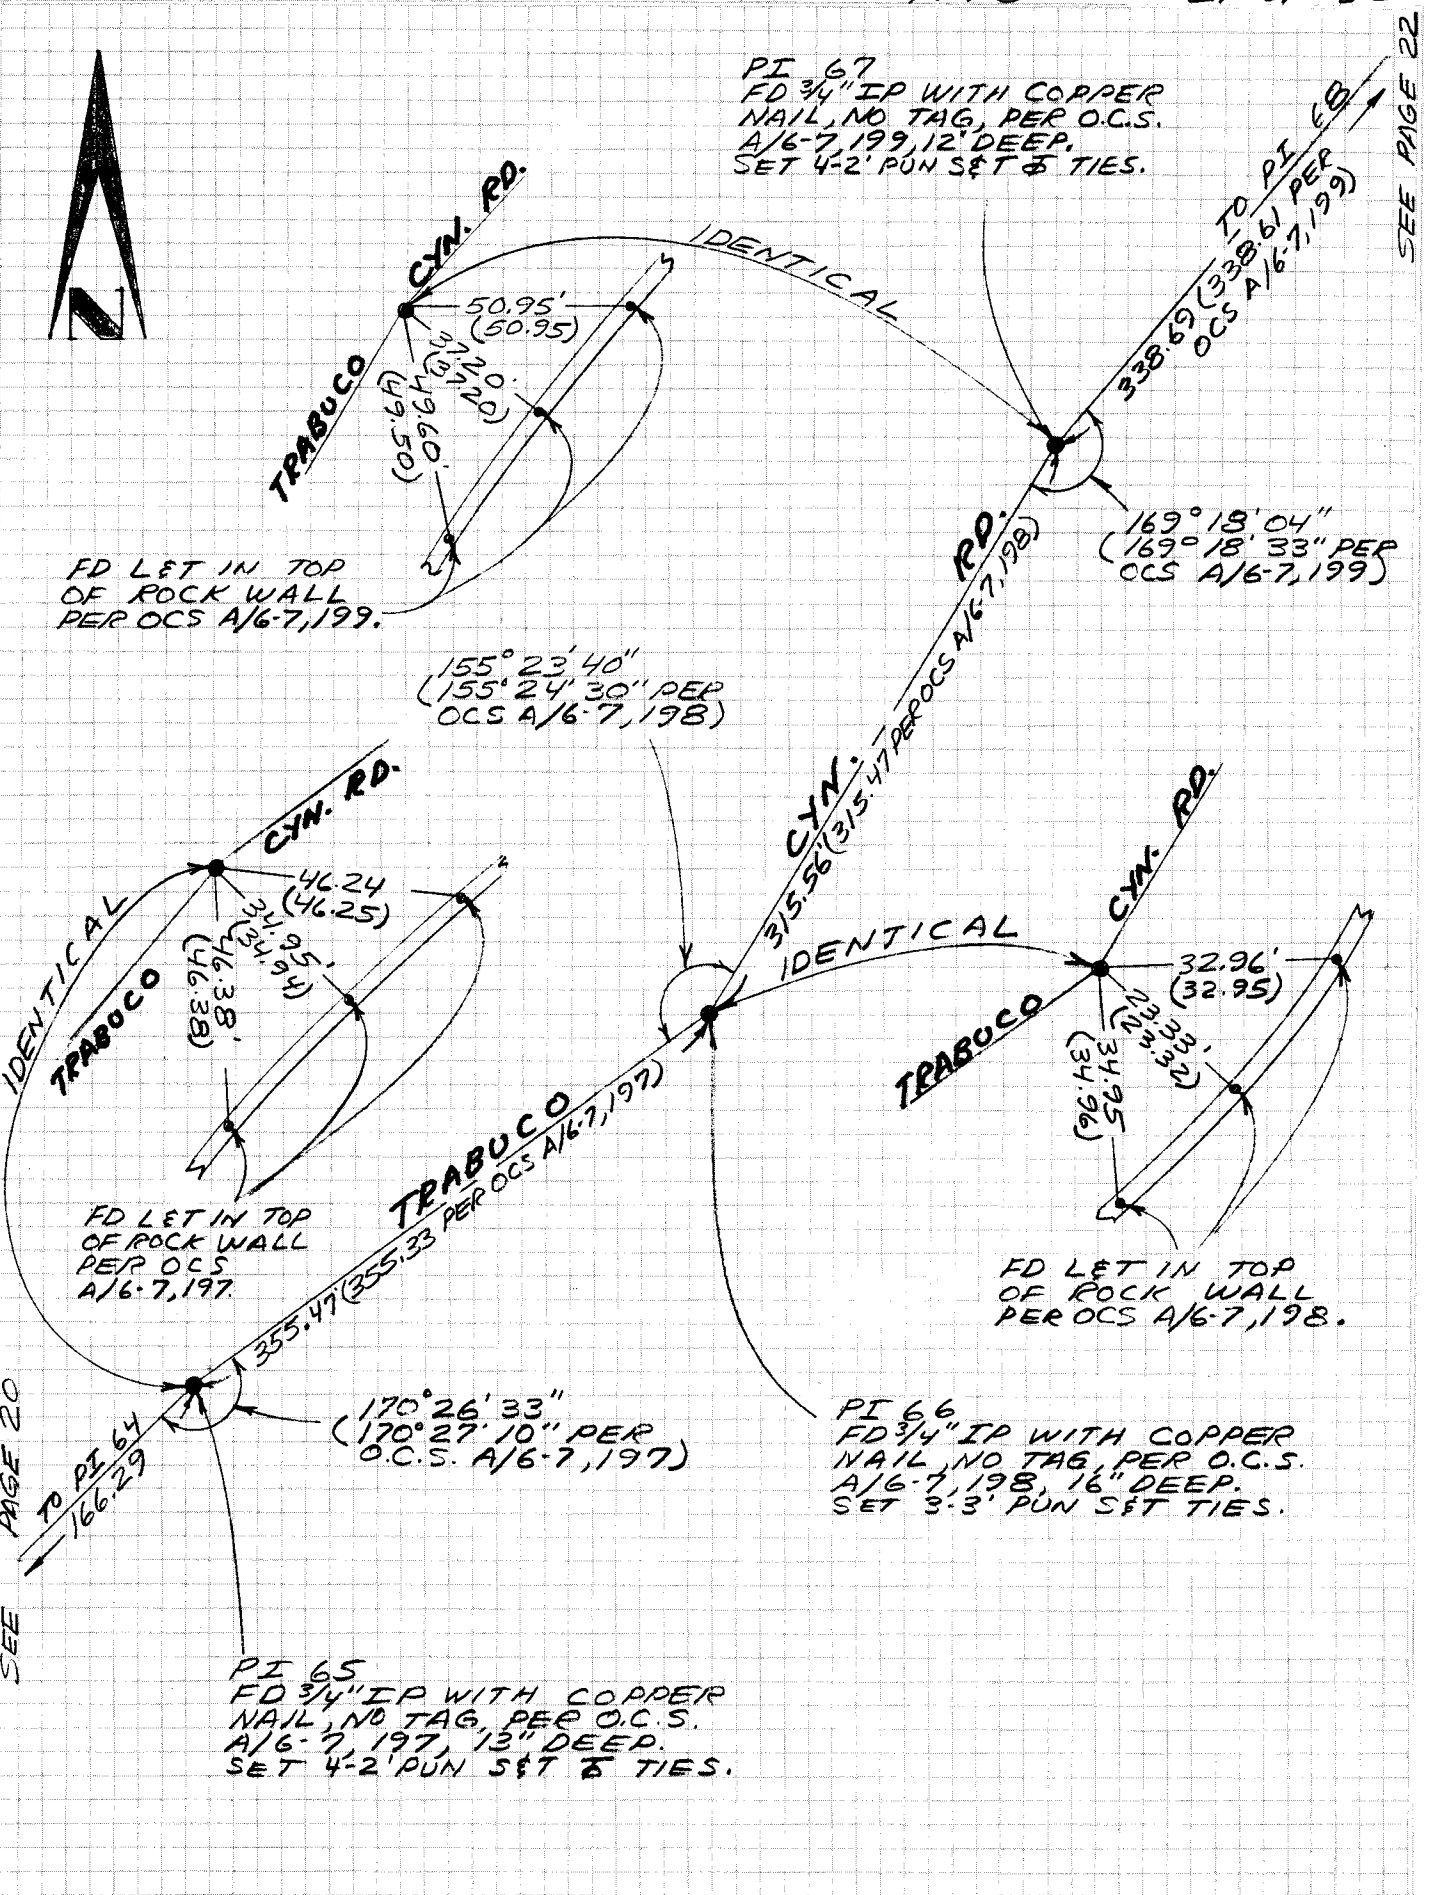

SURVEYED BY BEAIRD

APRIL 1976

22 OF 30

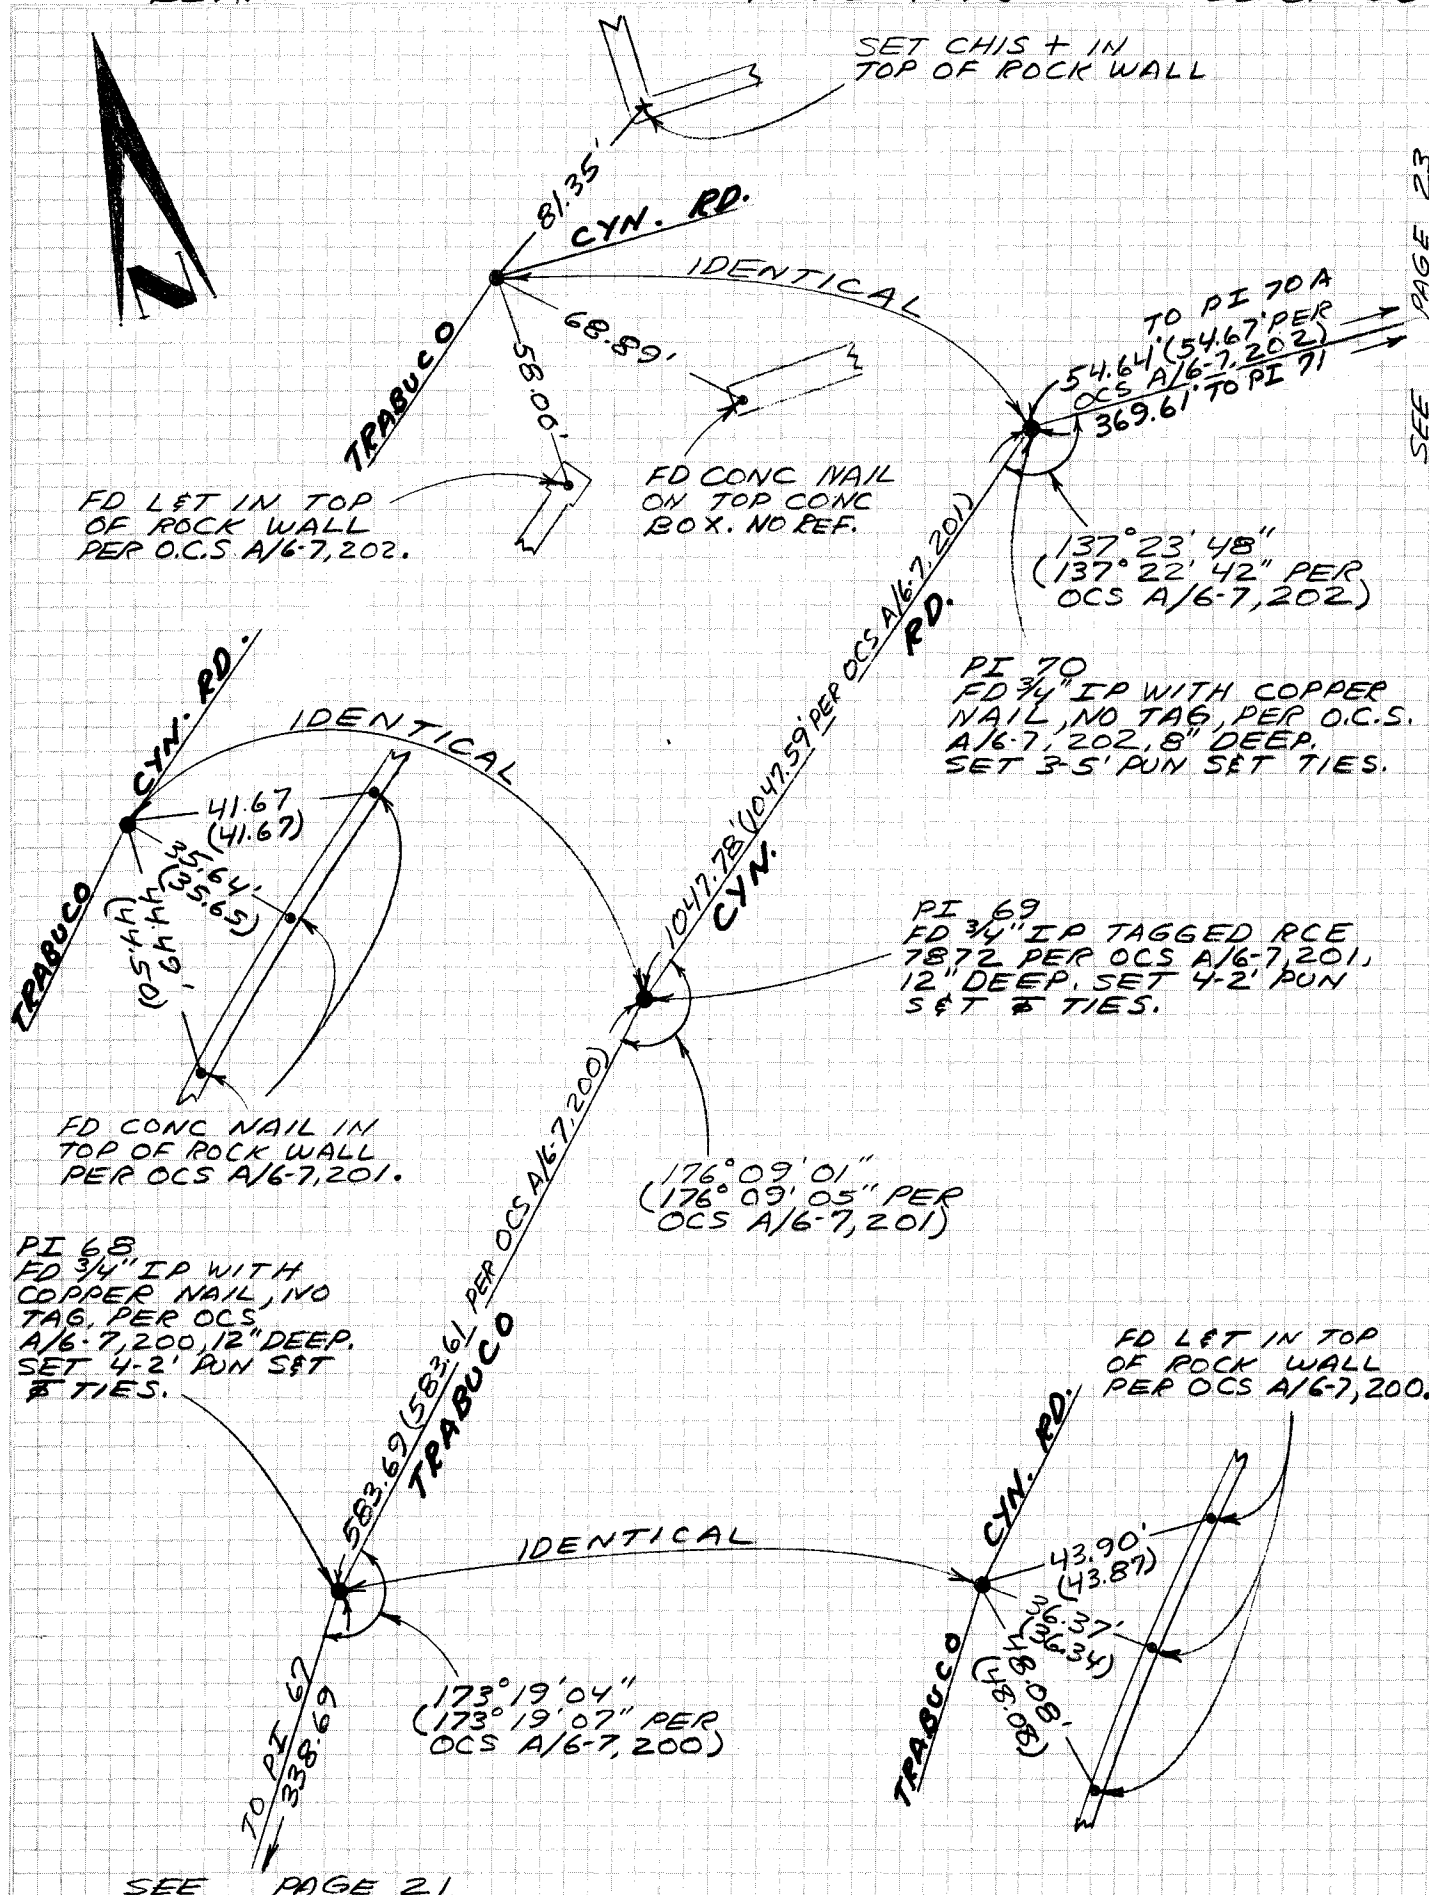

SEE PAGE 23


SEE PAGE 21

BEAIRD

APRIL 1976

23 OF 30

SEE PAGE 24

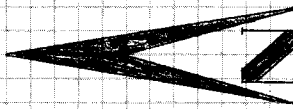

PI 72
FD NOTHING. ESTB. PER
REC. & DATA SHOWN ON
OCS A/6-7, PGS 203 & 204.
SET 2" IP TAGGED "ORANGE
COUNTY SURVEYOR", 12" DEEP.

144° 31' 17"
(144° 31' 00" PER OCS A/6-7, 204)

SET CHIST
IN 8" STEEL GATE
POST.

69.71' CYN. RD.

SET NET IN
PP# 1678047E

IDENTICAL

SET NET
IN 18" OAK

SET NET IN
84" OAK.

SET NET IN
16" SYC.

SET SET IN
14" OAK

17.49'

41.44'

47.63'

IDENTICAL

SET NET IN
PP# 765892H

SET NET IN
14" SYC.

PI 71
FD 3/4" IP TAGGED RE 561
PER OCS A/6-7, 203, 12" DEEP.
SET 4-2' PUN SET & TIES.

168° 44' 42"
(168° 44' 38" PER
OCS A/6-7, 203)

FD 3/4" IP TAGGED RE 561
PER CSTB 147-67, 12" DEEP,
ON LINE. SET 4-2' PUN SET
& TIES. THIS POINT ALSO
FALLS ON THE TRABUCO
RANCH LINE AS SHOWN ON
PM 55/16-18.

84° 25' 41"
(84° 26' 30" PER
CSTB 147-67)

529.71'
289.21' (289.22'
PER CSTB 147-67)
OAKS DR.

95° 34' 19"

PI 70A
FD NOTHING. ESTB POINT
BY INTERSECTION OF THE
ROAD CENTERLINES.
SET PUN. SPK. TAGGED "ORANGE
COUNTY SURVEYOR" ON SUR.
ALSO, SET 4-2' PUN SET
& TIES.

180° 00' 00"
(180° 01' 22" PER
OCS A/6-7, 202)

TO PI 70
54.64'
369.61'
TO PI 70

SEE PAGE 22

PAGE 28

SEE

SURVEYED BY BEARD

APRIL 1976

24 OF 30

FD NET IN 4X4
FENCE POST
PER CSTB 147-46

SET NET IN
P.P. 1678045E

FD NET IN
4X6 FENCE
POST. NO REF.

FD NET IN
P.P. #627366H
NO REF.

SET SET
IN 12" SYC.

SET SET
IN 10" OAK.

FD NET IN
POMEGRANATE
TREE. NO REF.

PI 73C
FD 1" IP, WITH NAIL,
NO TAG, PER OCS
A/6-7, 205, 6" DEEP.

PI 74
FD 1 1/4" IP WITH NAIL,
NO TAG, PER OCS
A/6-7, 205, 4" DEEP,
ON LINE.

FD CHIS + IN
STEEL COR FENCE
POST PER CSTB
147-46


FD 3/4" IP TAGGED RE 7872
6" DEEP ON LINE, PER
CSTB 159-66.

SET NET
IN 10" SYC.

PI 73A
FD 3/4" IP WITH NAIL, NO TAG,
PER O.C.S. A/6-7, 205, 12" DEEP.
SET 3-2' PUN SET TIES.
PIPE IS ON LINE.


PI 73
FD 3/4" IP WITH NAIL NO TAG,
PER OCS A/6-7, 204, 12" DEEP.
SET 3-2' PUN SET TIES.

140° 01' 10"
(140° 00' 39" PER
OCS A/6-7, 204)

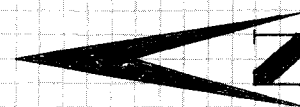

SEE PAGE 23

SEE PAGE 25


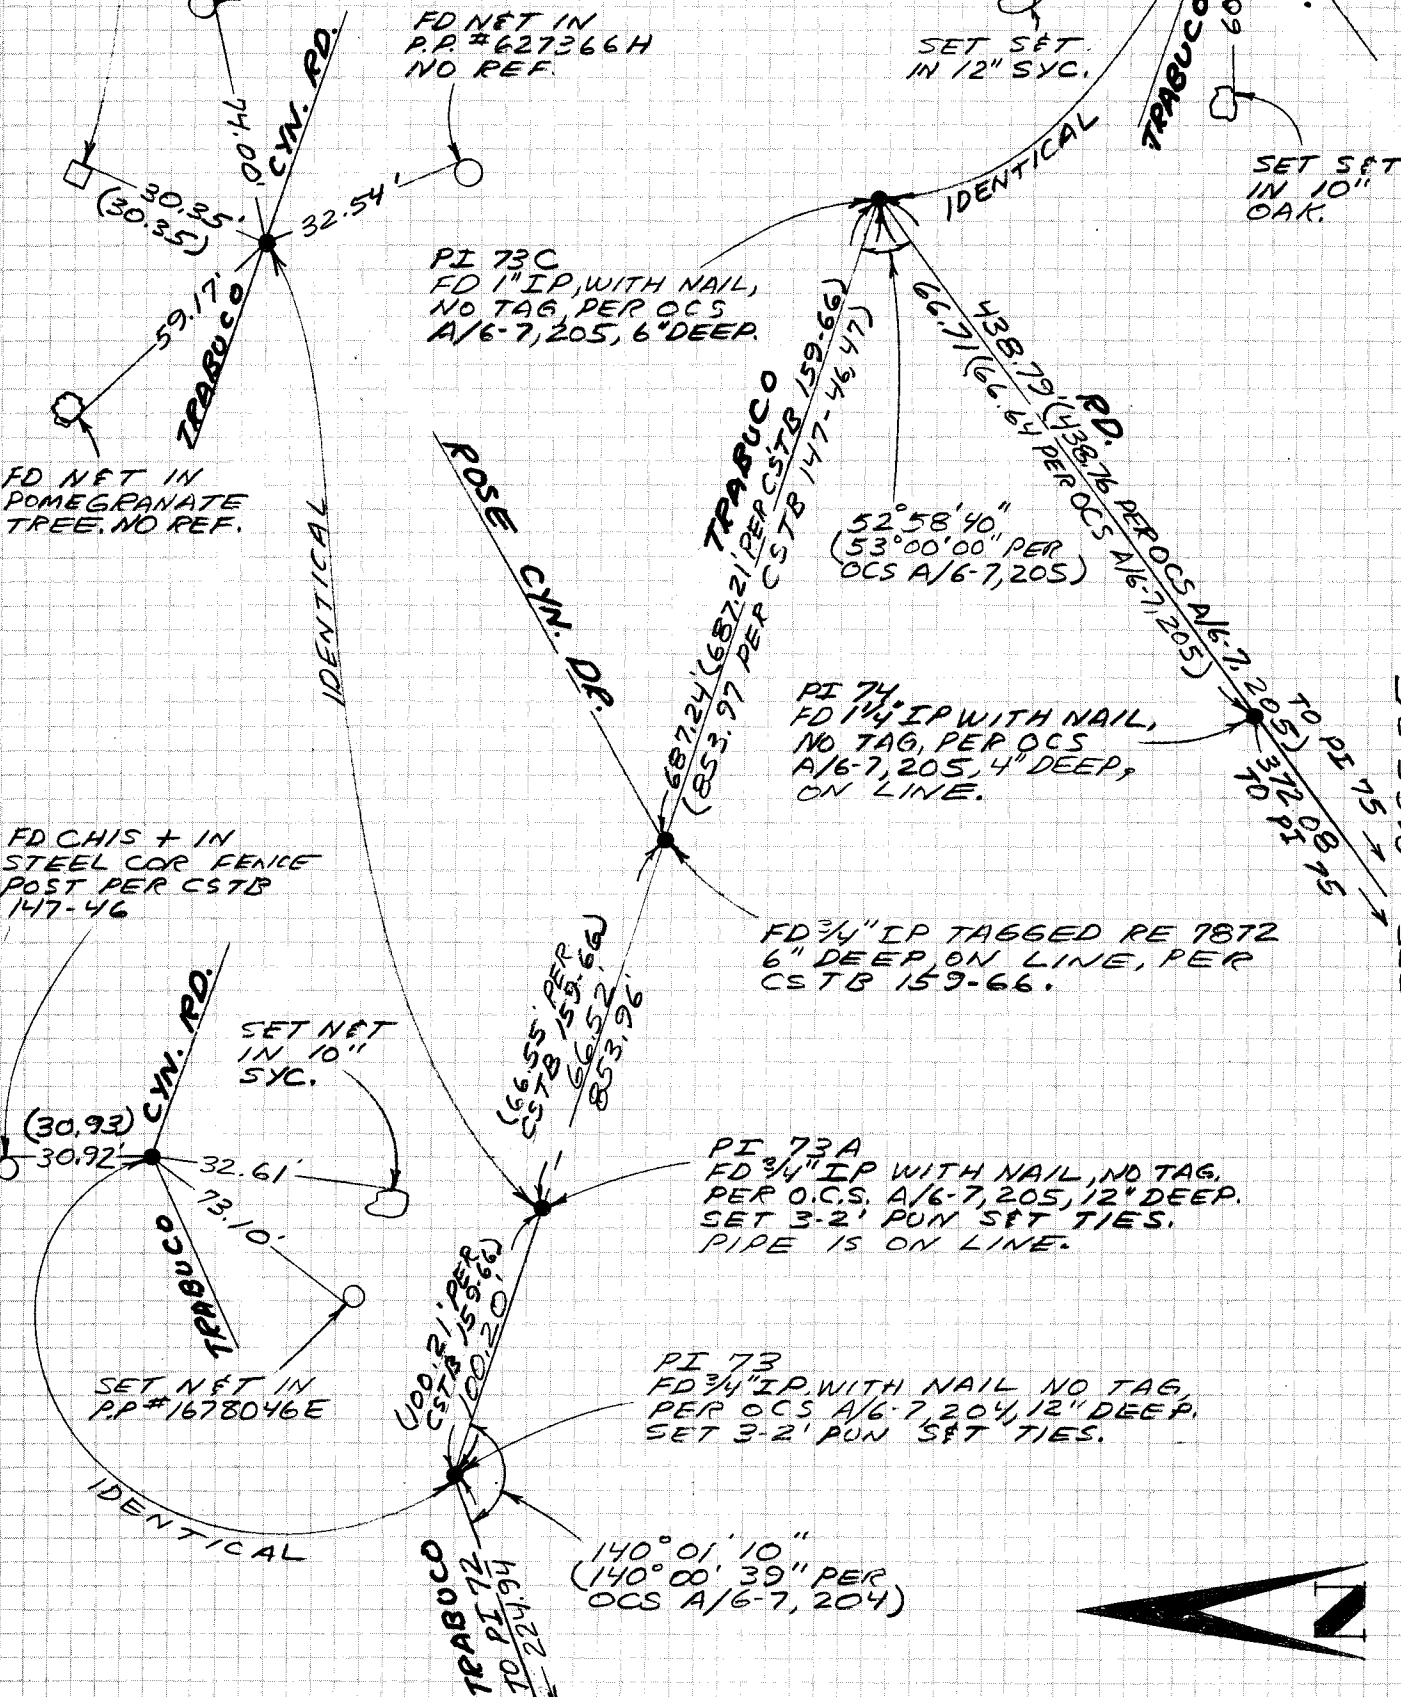


BEAIRD

APRIL 1976

25 OF 30

SEE PAGE 24

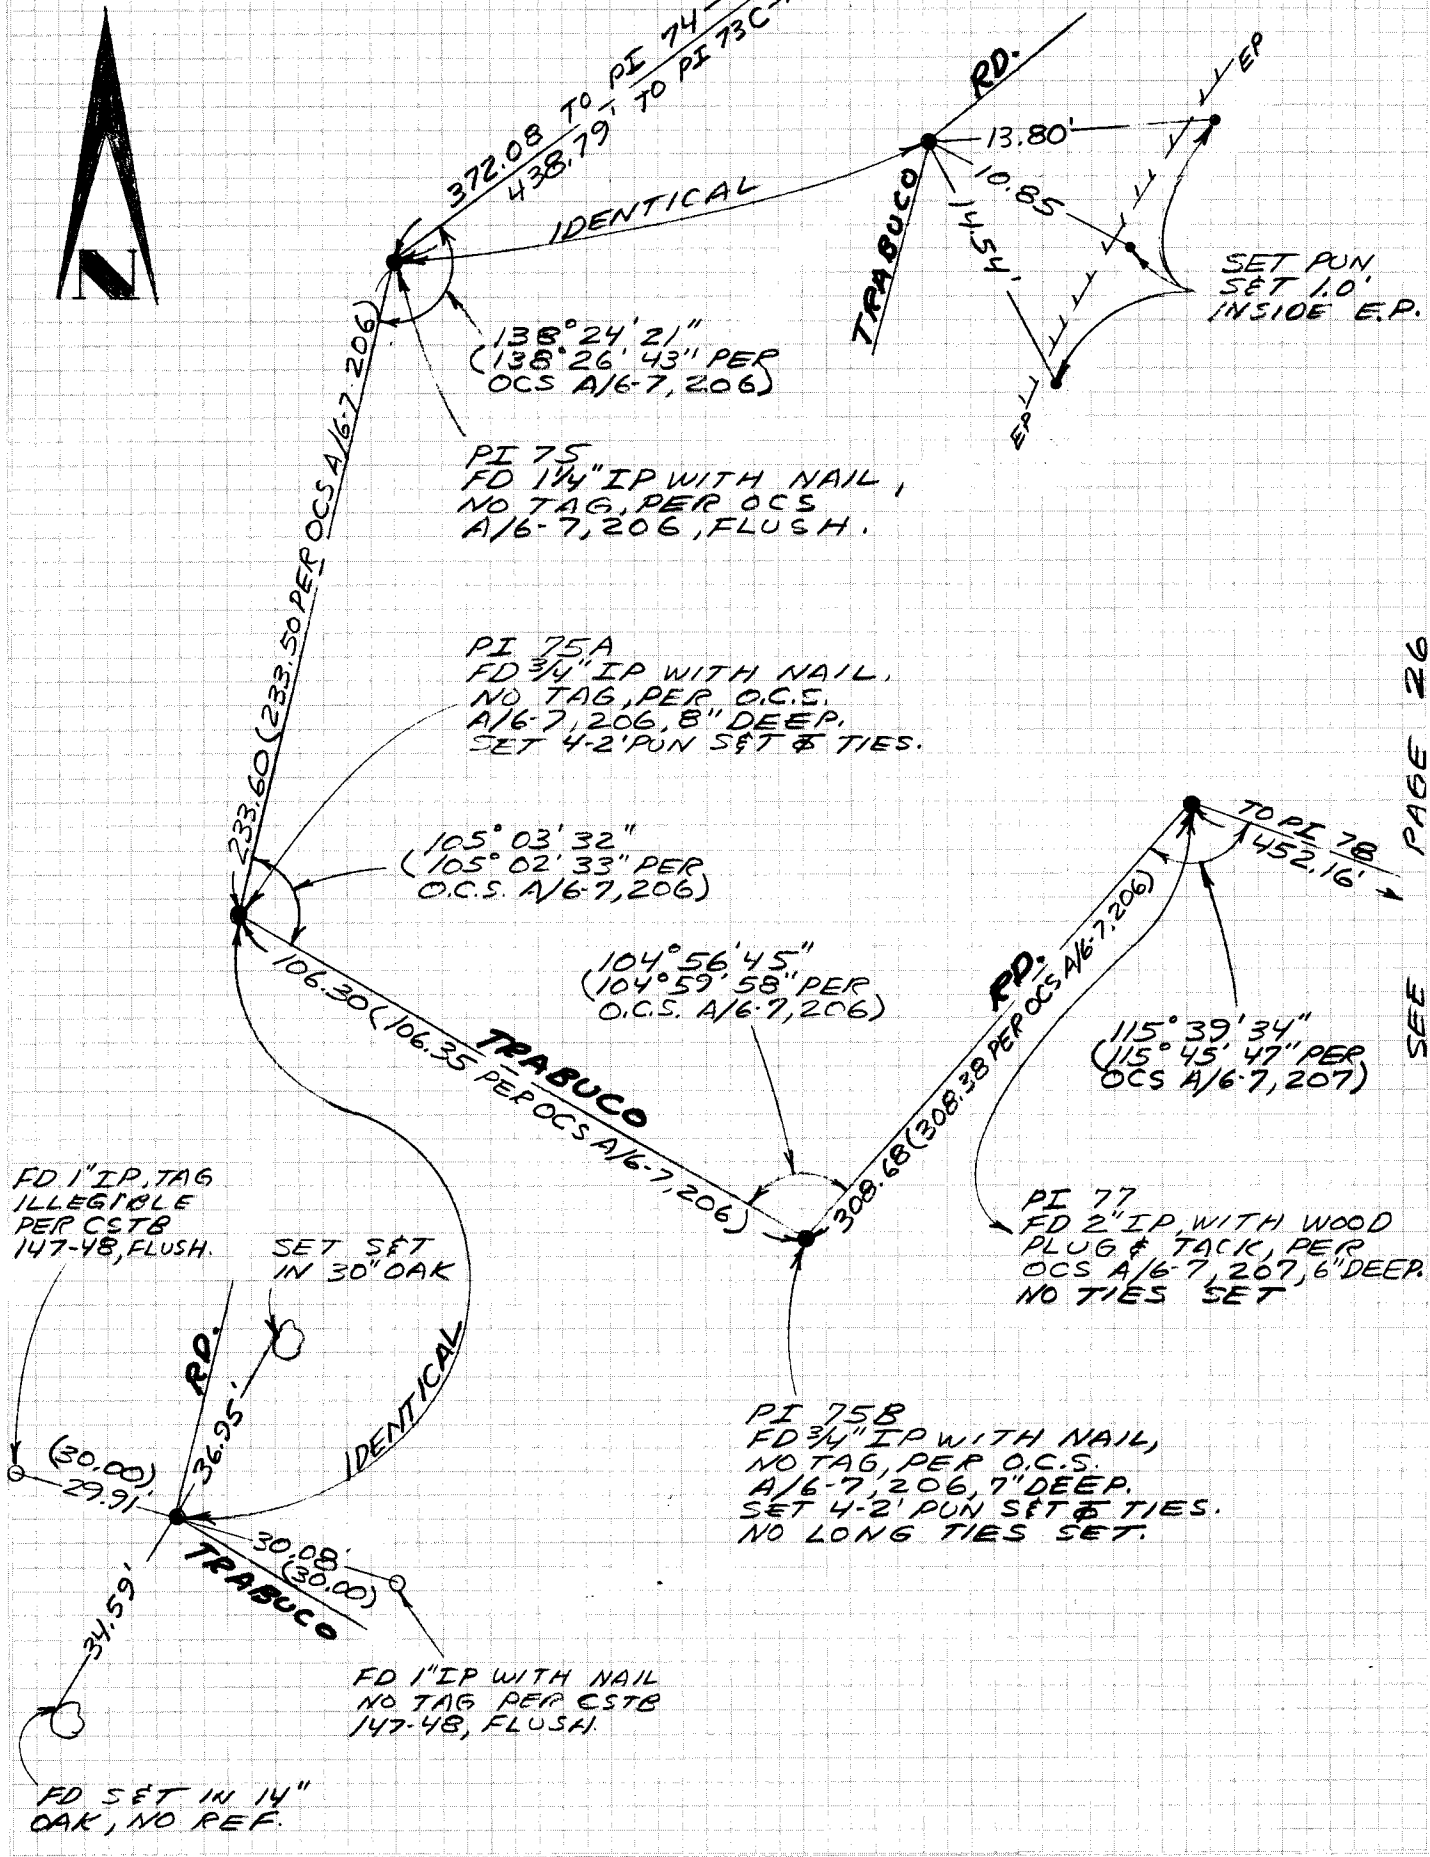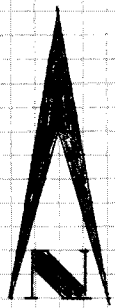

PAGE 26
SEE

PI 80
FD 3/4" AXLE PER
OCS A/6-7, 209,
8" DEEP. NO
TIES SET.

1238.84 (1238.60 PER OCS A/6-7, 209)
RD. TO PI 80 A

66° 45' 36"
(66° 45' 45" PER
OCS A/6-7, 209)

PI 79
FD 3/4" IP WITH NAIL,
NO TAG PER OCS
A/6-7, 208, UP 4",
NO TIES SET.

101° 57' 58"
(101° 57' 06" PER
OCS A/6-7, 208)

145° 01' 39"
(145° 05' 06" PER
OCS A/6-7, 208)

TRABUCO

TO PI 77

452.16 (452.01 PER
OCS A/6-7, 207)

230.70' (230.74 PER OCS A/6-7, 208)

SET SET IN
18" OAK.

PI 78
FD 3/4" IP WITH NAIL,
NO TAG PER O.C.S.
A/6-7, 208, 12" DEEP.
SET 3-2' PUN SET TIES.

IDENTICAL


TRABUCO

RD.

33.12'
(33.20)

FD SET IN
12" OAK PER
CSTB 147-49.


SET SPR IN
12" OAK.

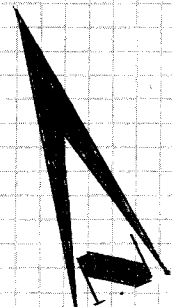

BF A 140

APRIL 1976

27 OF 30

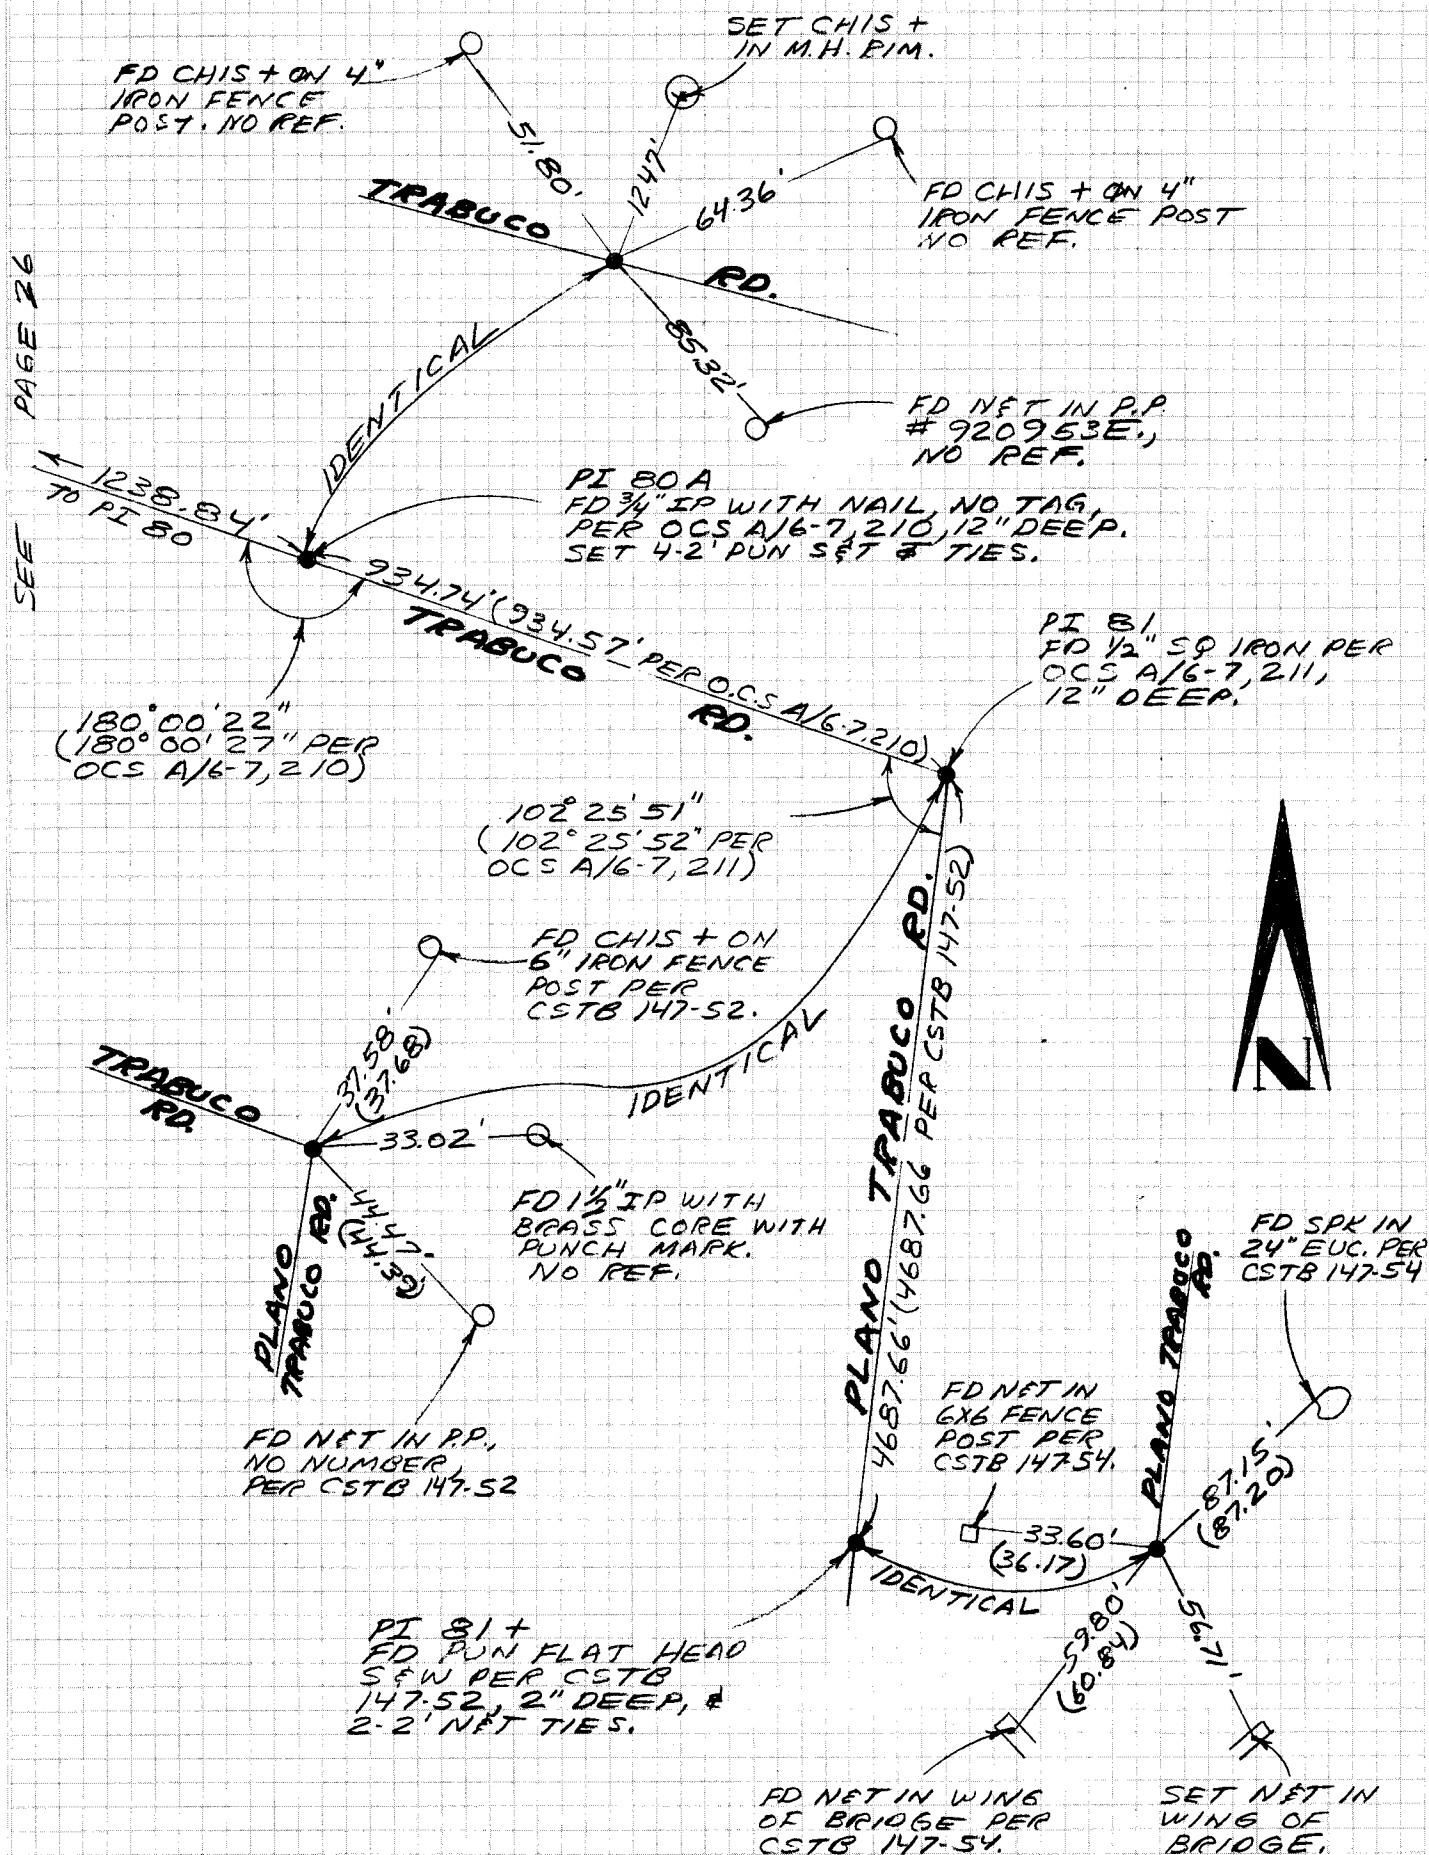


BEAIPD

FD NAIL IN
18" OAK PER
CSTB 147-68

SEE
APRIL, 1976
PAGE 29

28 OF 30

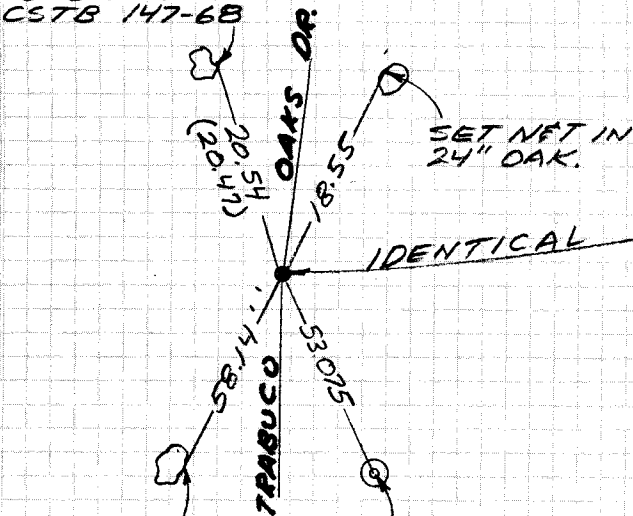


SET NET IN
18" OAK

SET PUN. MK.
IN CTR. HEX. BOLT
ON TOP OF FIRE
HYD.

SET NET IN
24" OAK.

FD NET IN 24"
LEANING OAK
PER CSTB 147-67

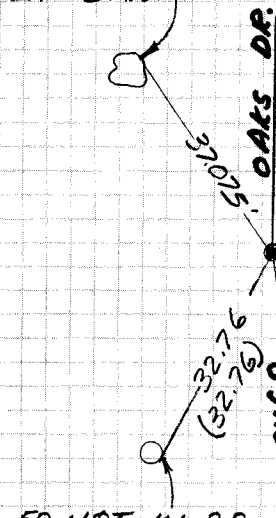


FD NET IN P.P.
432985E PER
CSTB 147-67.

SET NET IN
18" OAK.

P.I.
FD 12" SPK ON SURFACE &
FD 3/4" I.P. TAGGED RE 561
PER CSTB 147-67, 12" DEEP.
SET 4-2' PUN SET & TIES.

162° 55' 40"
(162° 57' 30" PER
CSTB 147-67)

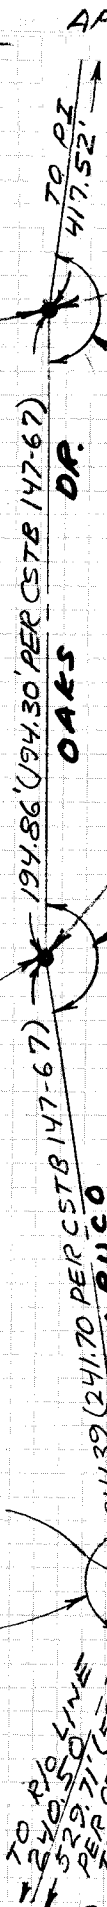

P.I.
FD 3/4" IP TAGGED RE 561
PER CSTB 147-68, 20" DEEP.
SET 4-2' PUN SET & TIES.


173° 55' 47"
(173° 51' 21" PER
CSTB 147-68)

P.I.
FD 12" SPK ON SURFACE OVER
3/4" IP TAGGED RE 561 PER
CSTB 147-67, 12" DEEP.
SET 4-2' PUN SET & TIES.


170° 33' 49"
(170° 37' 20" PER
CSTB 147-67)

FD NET IN
PP # 493286E
PER CSTB
147-67.

FD CHIS + IN
TOP ROCK WALL
PER CSTB
147-67.

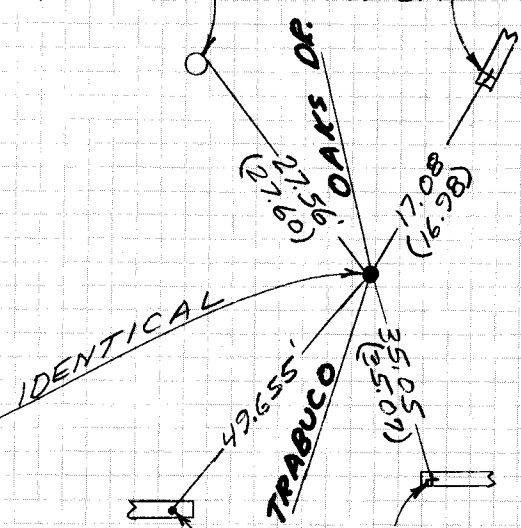

SET PUN MK. IN TOP OF
3/4" RE-BAR IN TOP OF
CONC. RET. WALL.

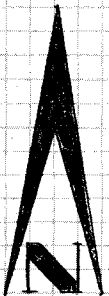

BEAIRD

APRIL, 1976

29 OF 30

SEE PAGE 30

FD NET IN
PP# 432977E
PER CSTB
147-69.

SET NET IN
15" OAK

PI
FD 3/4" IP TAGGED
RE 561 PER CSTB
147-69, 15" DEEP.
SET 4-2' PUN SET
TIES.

SET + IN
STEEL FENCE
POST.

SET NET IN
24" OAK.

FD NET IN
PP# 432978E
PER CSTB 147-69.

FD NAIL IN
24" OAK PER
CSTB 147-69.

PI
FD NOTHING. ESTB. PER TIES
SHOWN ON CSTB 147-69.
SET 2" I.P. TAGGED "ORANGE
COUNTY SURVEYOR" 12" DEEP,
WITH 2-2' PUN SET TIES
ON SURFACE.

FD NAIL IN
24" OAK PER
CSTB 147-69.

SET + ON COR
STEEL FENCE
POST.

PI
FD 3/4" IP, NO NAIL,
NO TAG, PER CSTB
147-68, 6" DEEP.
SET 4-2' PUN SET
TIES.

FD NET IN
12" FORKED
OAK PER
CSTB 147-68.

163° 54' 06"
(163° 51' 47" PER
CSTB 147-68)

SET NET IN
PP# 844351E.

FD NET IN
STUB POLE,
NO NUMBER, PER
CSTB 147-68.

SEE PAGE 28

30 OF 30

