

ALL SHEET OF THIS
RECORD APPLY TO
OUR BOUNDARY

ORANGE COUNTY SURVEYOR
PRELIMINARY SURVEY

R77-37 (MF)

A/5-11&12 591

PROJECT

NEWLAND STREET

LIMITS OR LOCATION

150' S/O Balsa Ave. to 150'
N/O Hazard Ave.

WORK ORDER NUMBER PPB DATED

R1431120

KB

3-25-77

PAGE INDEX

ALIGNMENT PG. 1 TO PG. 5

LEVEL RUN PG. 6 TO PG. 11

TOPO PG. 12 TO PG. 45

DETAILS PG. 46 TO PG. 50

X-SECTION PG. 51 TO PG. 80

DATE COMPLETED

4-28-77

REMARKS

4 int. ties @ Newland St. @
Washington, Madison Ave, & Roosevelt Ave.
Per C.S.T.B. 130-B are on displaced curbs

DEPUTY COUNTY SURVEYOR'S NOTE:

The purpose of these notes is to show the relationship of the points and/or lines shown hereon to either lines or record, control lines, or to each other. The Deputy County Surveyor does not claim at this time, that the points or lines shown hereon are true centerline, boundary, deed, or control points or lines. Without further analysis, the interpretation of these notes is left to the discretion of the user.

John Canas
Deputy County Surveyor

By:


John Toomey
Supervising Land Surveyor

EQUIPMENT

TZ 169318
EDM 2549
Level 14208
FT. chain 63
Meter chain 55

PERSONNEL


R. Bailey
D. Minich
J. DelSigne
J. Pfeifer

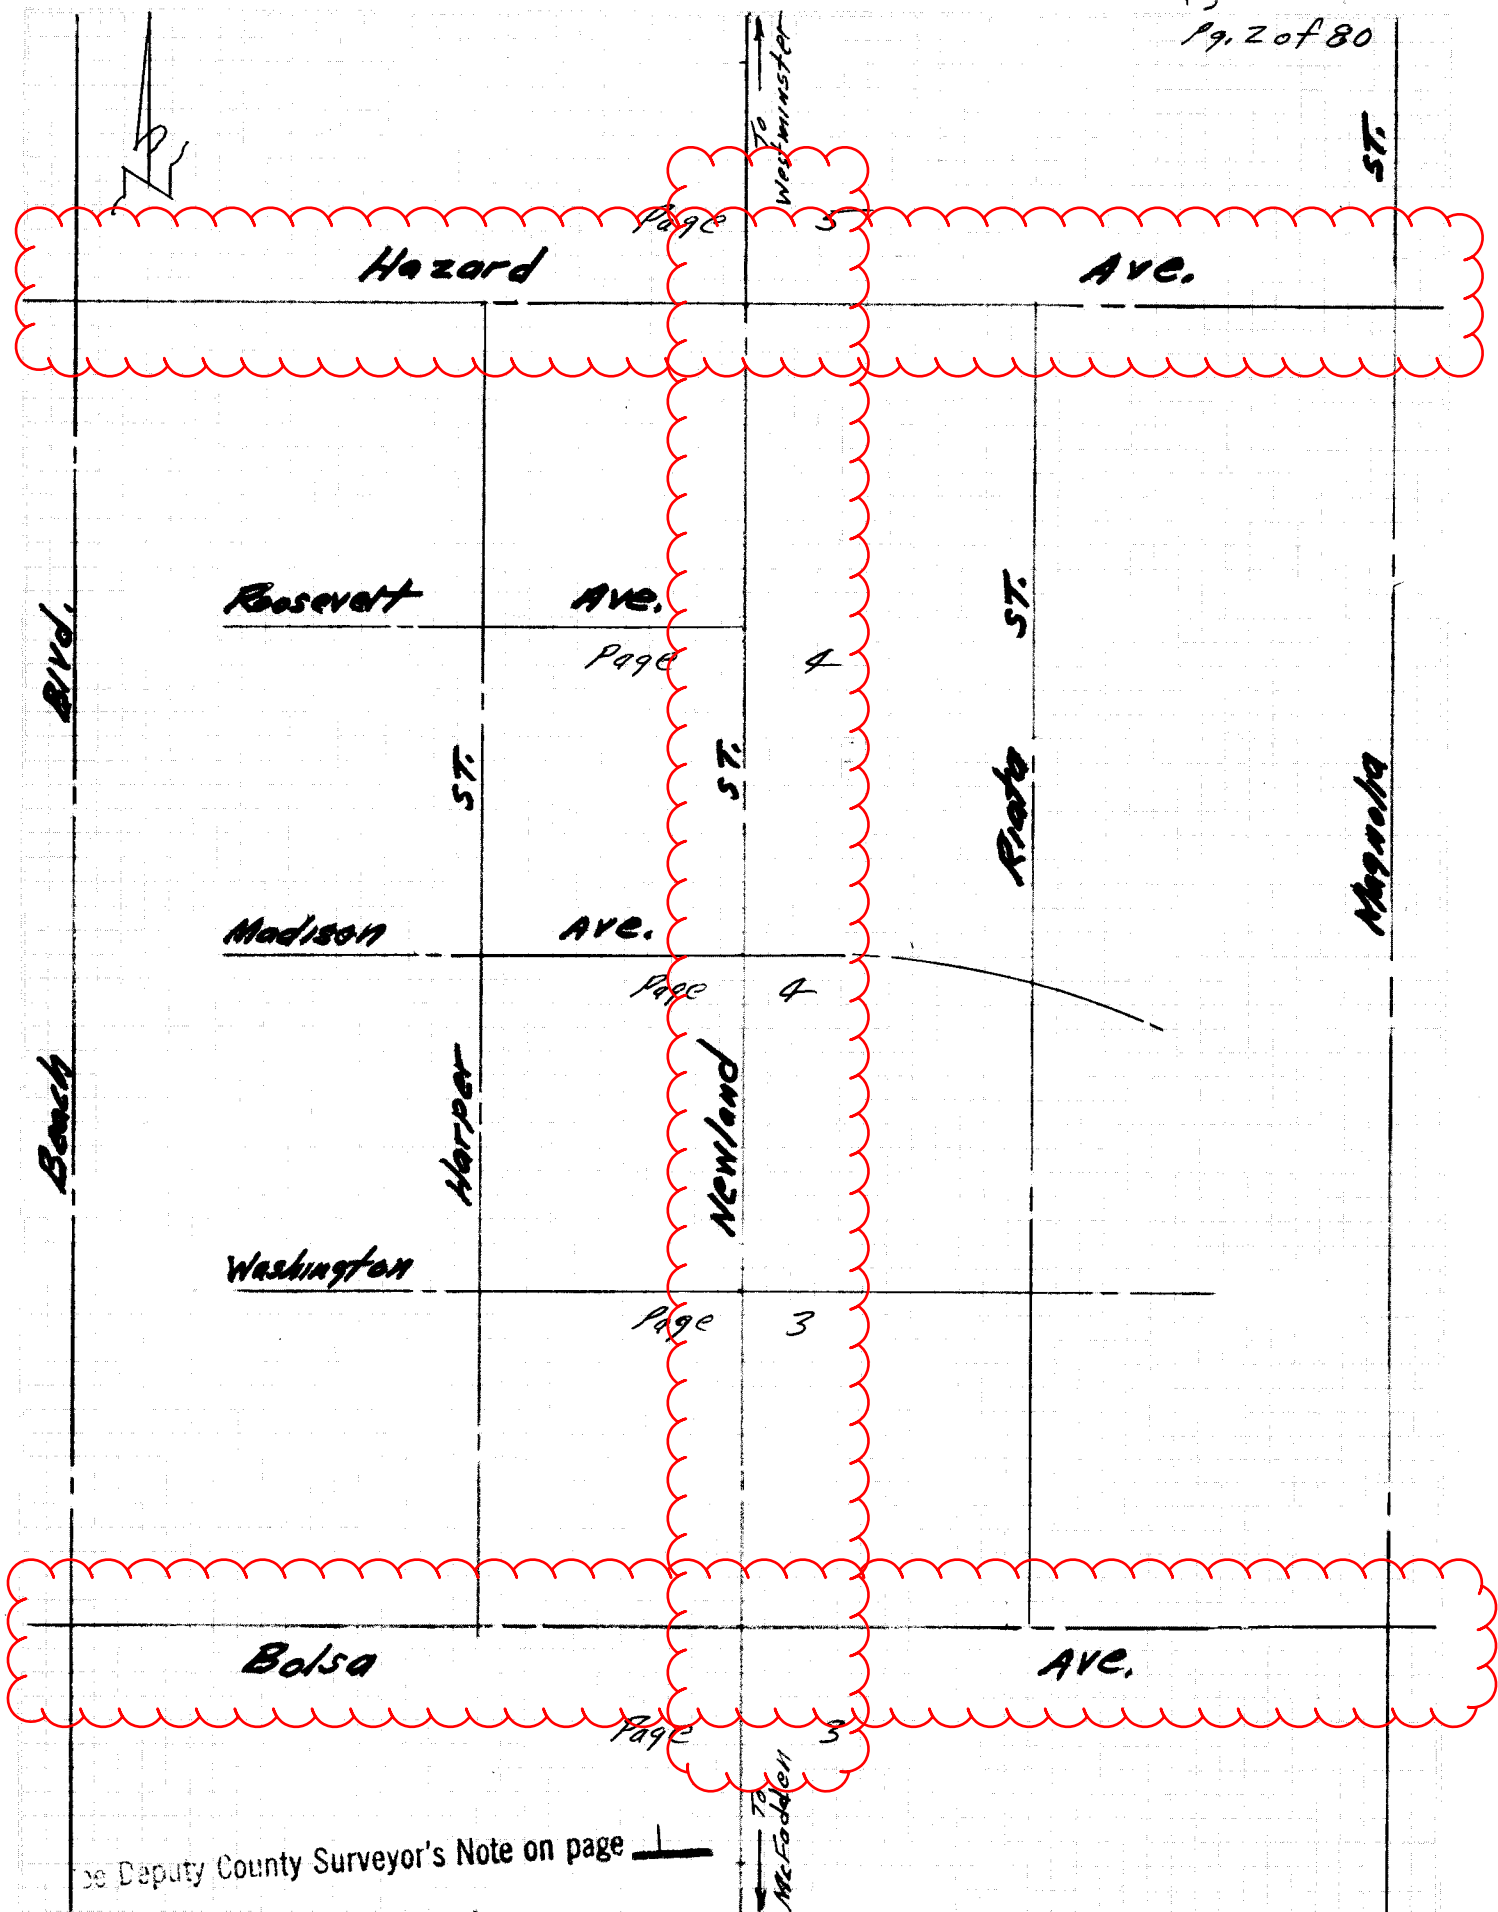

Barley & Pty.

4-11-77

Pg. 3 of 80

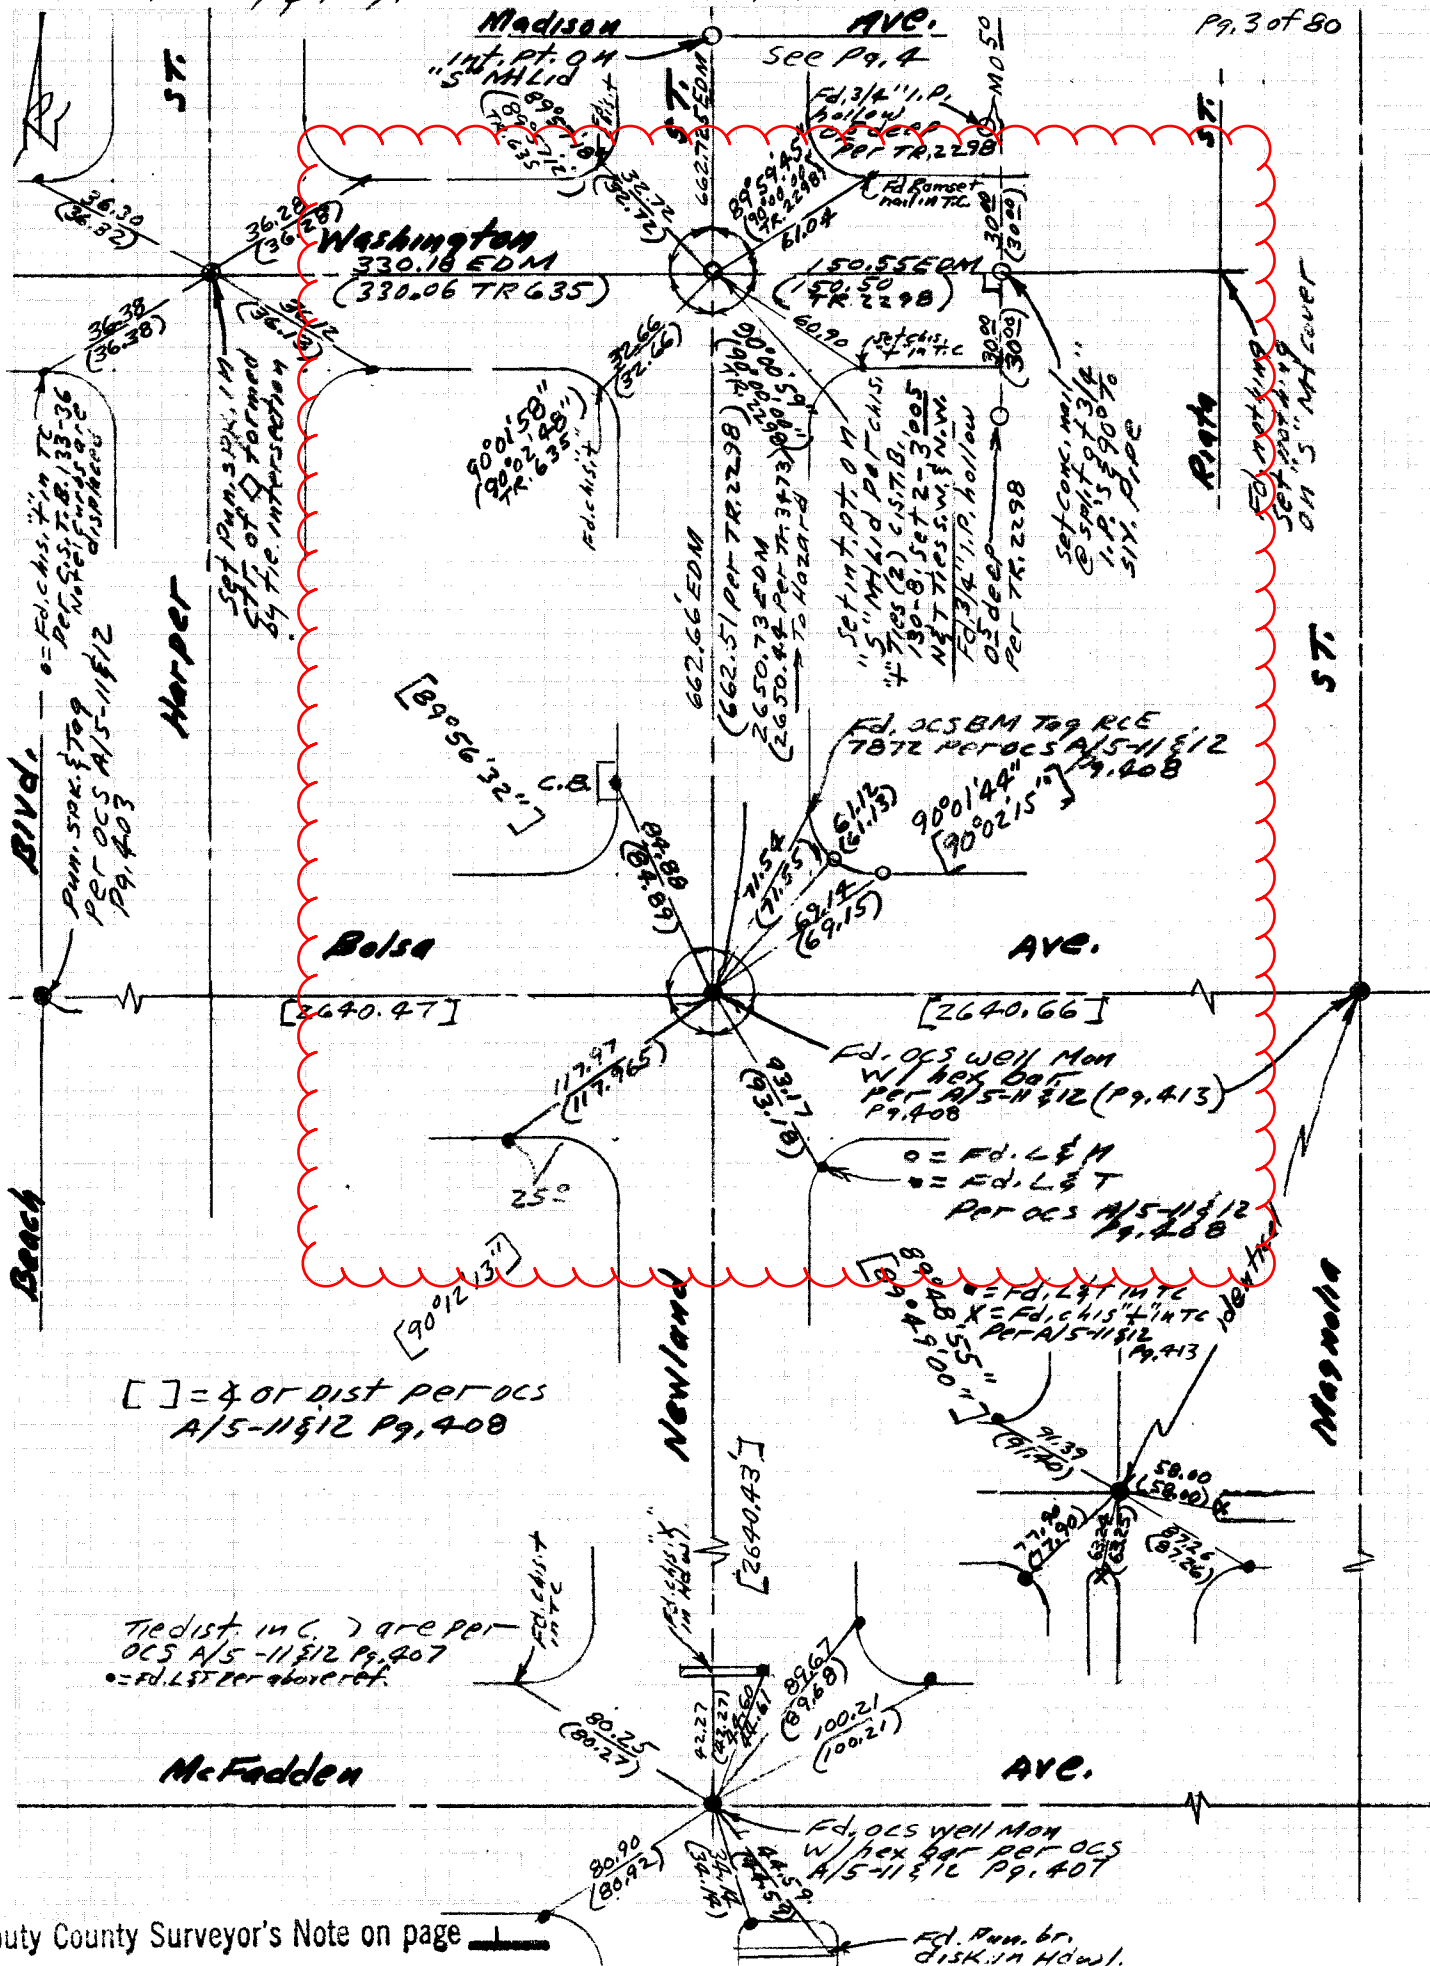

Newland ST.

A/5-11&12

594

pg 4 of 5

Bailey & pty.

4-12-77

Sec Pg. 5

Ave.

pg. 4 of 80

Hazard

INT. PT. ON "S" NH LID

• = Fd. chis. "t" IN T.C.
PER C.S.T.B. 133-36

Roosevelt Ave.

329.78 EDM
(329.73 TR. 665)

Set P.M. SPK. IN
CTR. of $\square$ formed
by tie intersection
Notes: curbs are
displaced

• = set chis. "t" IN T.C.

Set INT. PT. ON "S"
NH LID PER TIES (2) chis. "t"
C.S.T.B. 130-8
Set 2 N&T TIES
200 S. W.I.Y.
1995 S. E.I.Y.

ST.

ST.

Madison

329.95 EDM
(329.89 TR. 635)

• = Fd. chis. "t"
INT. PT. ON "S" NH LID
PER C.S.T.B. 133-36
Notes: curbs
are displaced

Ave.

253.14 EDM
(253.15 TR. 2298)

Fd. PK MAIL
ON LINE

• = set chis. "t" IN T.C.
1/2 E/O ECR

Harper

Set int. pt. on
"S" NH LID @ E.I.Y.
of $\square$ formed by
tie intersection
Set 2-200 N&T
TIES S. W.I.Y.
S. E.I.Y.

Newland

662.725 EDM
(662.50 PER TR. 2298)

• = set chis. "t" IN T.C.
1/2 E/O ECR

Pinto

ROC. Set conc. nail by 2
curve defl. & chords

(4=13056'45")
R=1000
PER TR. 2298

Washington

INT. PT. ON "S"
NH LID

Bolsa

Fd. OCS W/II MOM.
W/ hex bar
Ave.

See Pg. 3

