

Block: 5259, Module: 20 & 21
CORNER RECORD


WM 40E

Document Number 98-460

City of UNINCORPORATED

County of ORANGE, California

Brief Legal Description TIES FOR 14959

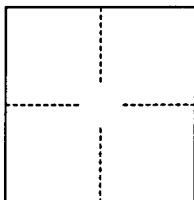

CORNER TYPE

Government Corner ☐ Control ☐
Meander ☐ Property ☒
Rancho ☐ Other ☐
Date of Survey MARCH 30, 1998

COORDINATES
(Optional)

N. _____
E. _____
Zone _____ Datum _____
Elev. _____

Corner — Left as found ☐ Found and tagged ☐ Established ☒ Reestablished ☐ Rebuilt ☐

Identification and type of corner found: Evidence used to identify or procedure used to establish or reestablish the corner:

SET SPIKE AND WASHER, R.C.E. 23956 AT THE CENTERLINE OF THE STREETS IN THIS TRACT ON
FRONTIER STREET, CHEYENNE STREET AND ALTURA.

A description of the physical condition of the monument as found and as set or reset: _____

SURVEYOR'S STATEMENT

This Corner Record was prepared by me or under my direction in conformance with the
Land Surveyors' Act on NOVEMBER 3RD, 1998.


Signed Tom R. McGannon L.S. or R.C.E. Number 23956



COUNTY SURVEYOR'S STATEMENT

This Corner Record was received Dec. 23, 1998 and examined
and filed January 9th, 1999.

Signed Robert Jelinek Title DEPUTY COUNTY SURVEYOR

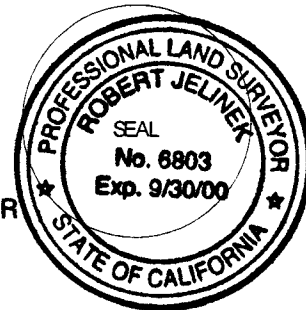

County Surveyor's Comment _____

HUNSAKER & ASSOCIATES, INC.

MARCH 30, 1998

ORANGE COUNTY SURVEYOR

SURVEYED BY


LAND SURVEYOR: TOM R. McGANNON, R.C.E. 23956

NOTE


ALL TIE POINTS ARE
L & T TAGGED R.C.E. 23956
SET IN TOP OF CURB
UNLESS OTHERWISE NOTED.

LEGEND

● INDICATES SET 8" SPIKE &
WASHER STAMPED R.C.E. 23956
UNLESS OTHERWISE NOTED.

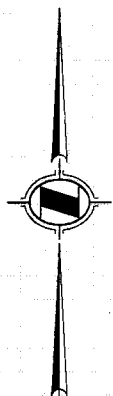

SCALE: 1" = 250'

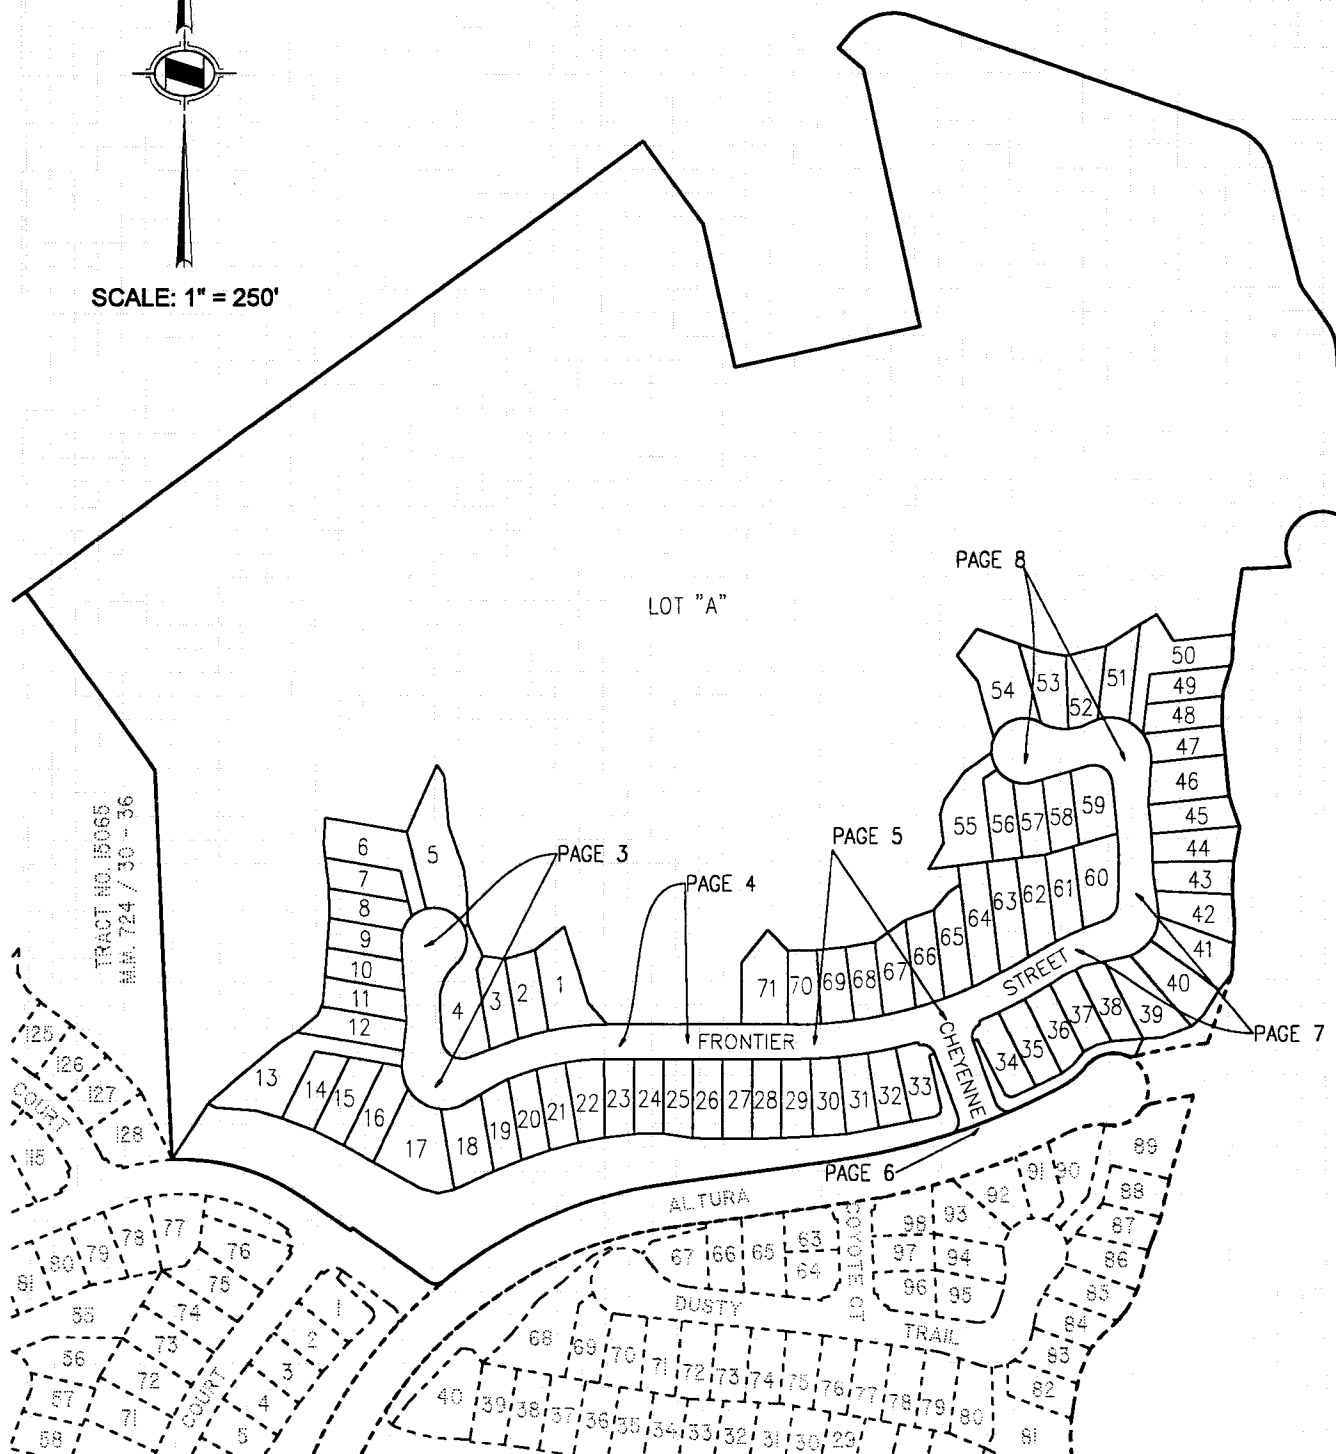

SURVEY OF

HUNSAKER & ASSOCIATES, INC.

MARCH 30, 1998

PAGE


NOTE

ALL TIE POINTS ARE
L & T TAGGED R.C.E. 23956
SET IN TOP OF CURB
UNLESS OTHERWISE NOTED.

LAND SURVEYOR: TOM R. MCGANNON, R.C.E. 23956

LEGEND

● INDICATES SET 8" SPIKE &
WASHER STAMPED R.C.E. 23956
UNLESS OTHERWISE NOTED.

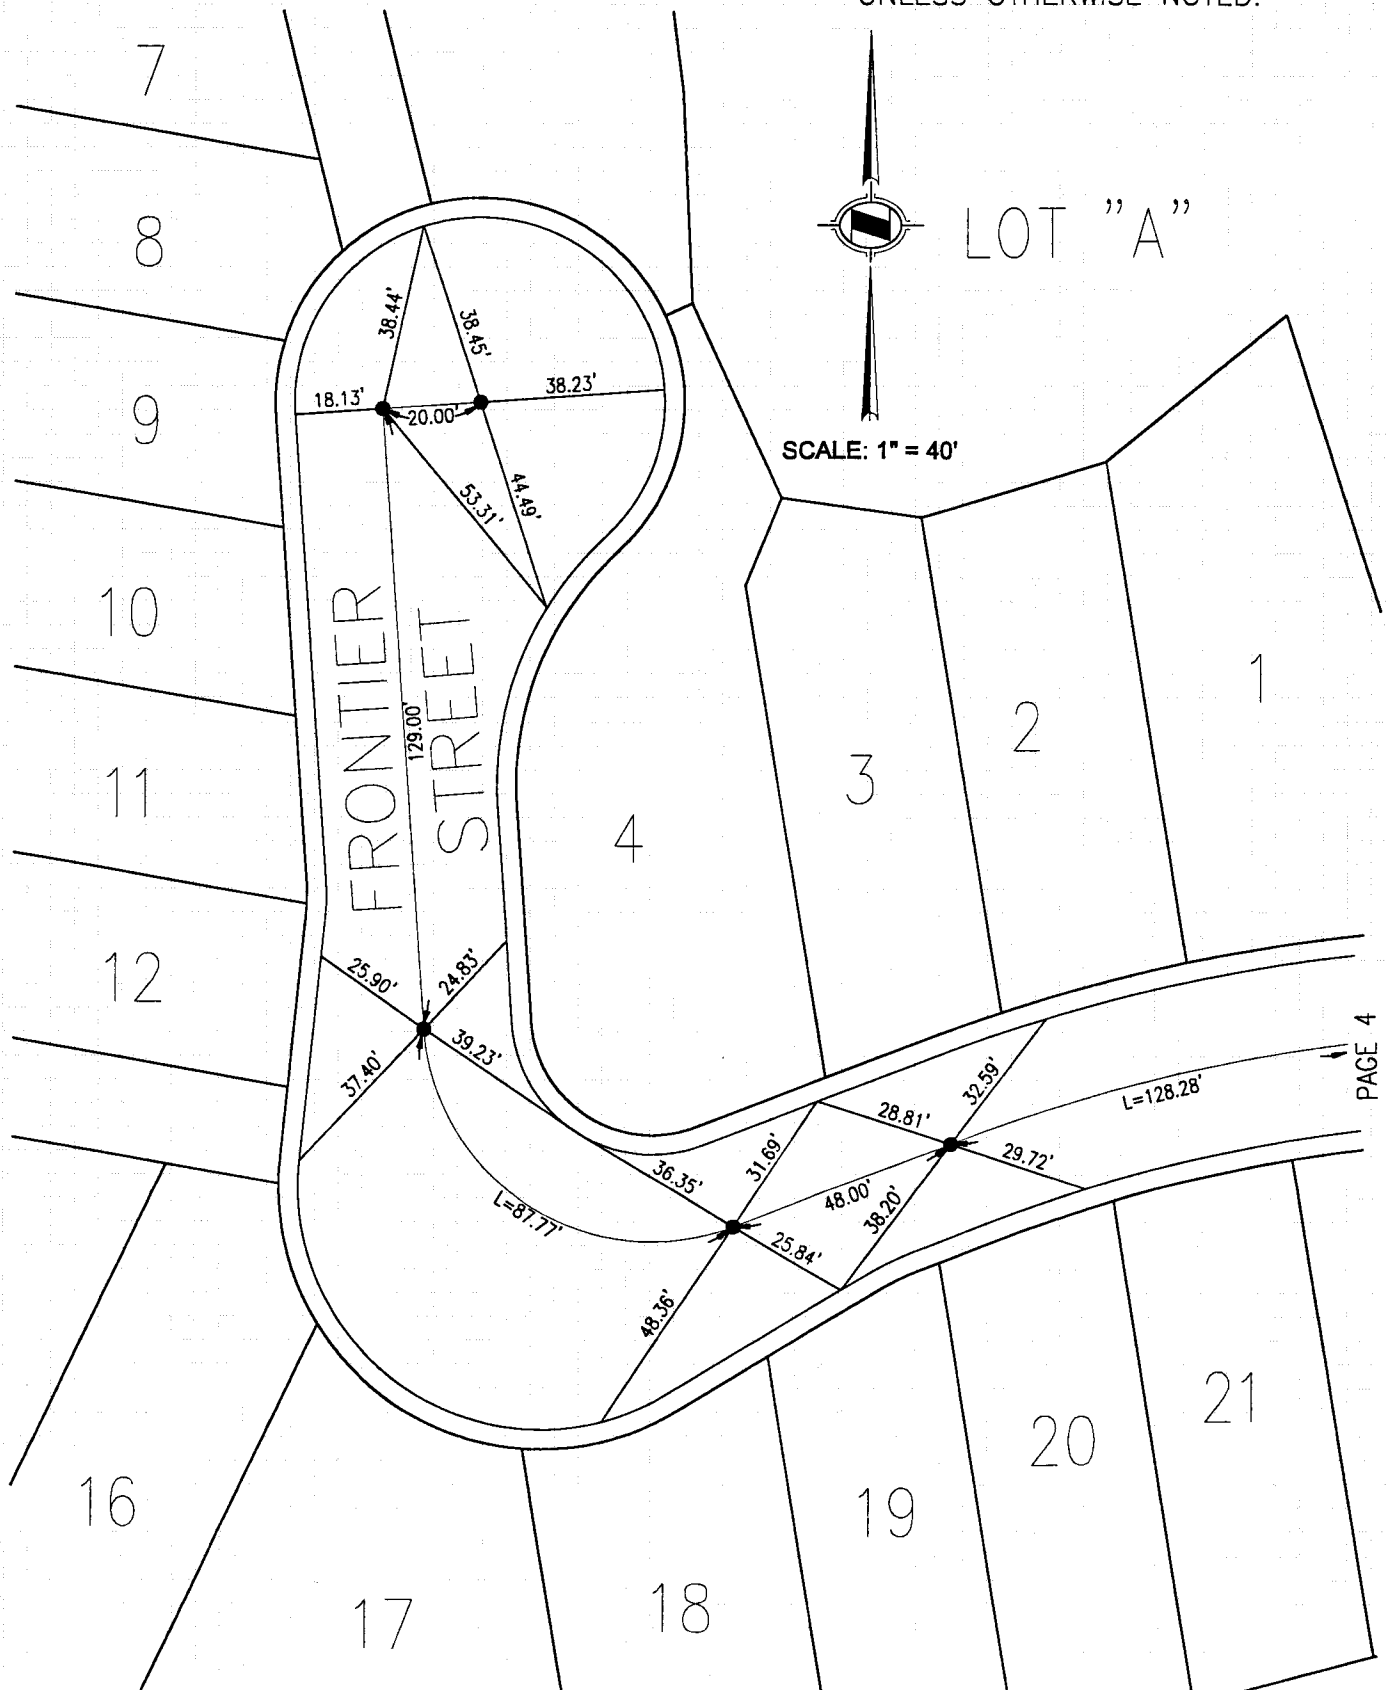

HUNSAKER & ASSOCIATES, INC.

MARCH 30, 1998

NOTE


ALL TIE POINTS ARE
L & T TAGGED R.C.E. 23956
SET IN TOP OF CURB
UNLESS OTHERWISE NOTED.

LAND SURVEYOR: TOM R. McGANNON, R.C.E. 23956

ORANGE COUNTY SURVEYOR

LEGEND

● INDICATES SET 8" SPIKE &
WASHER STAMPED R.C.E. 23956
UNLESS OTHERWISE NOTED.

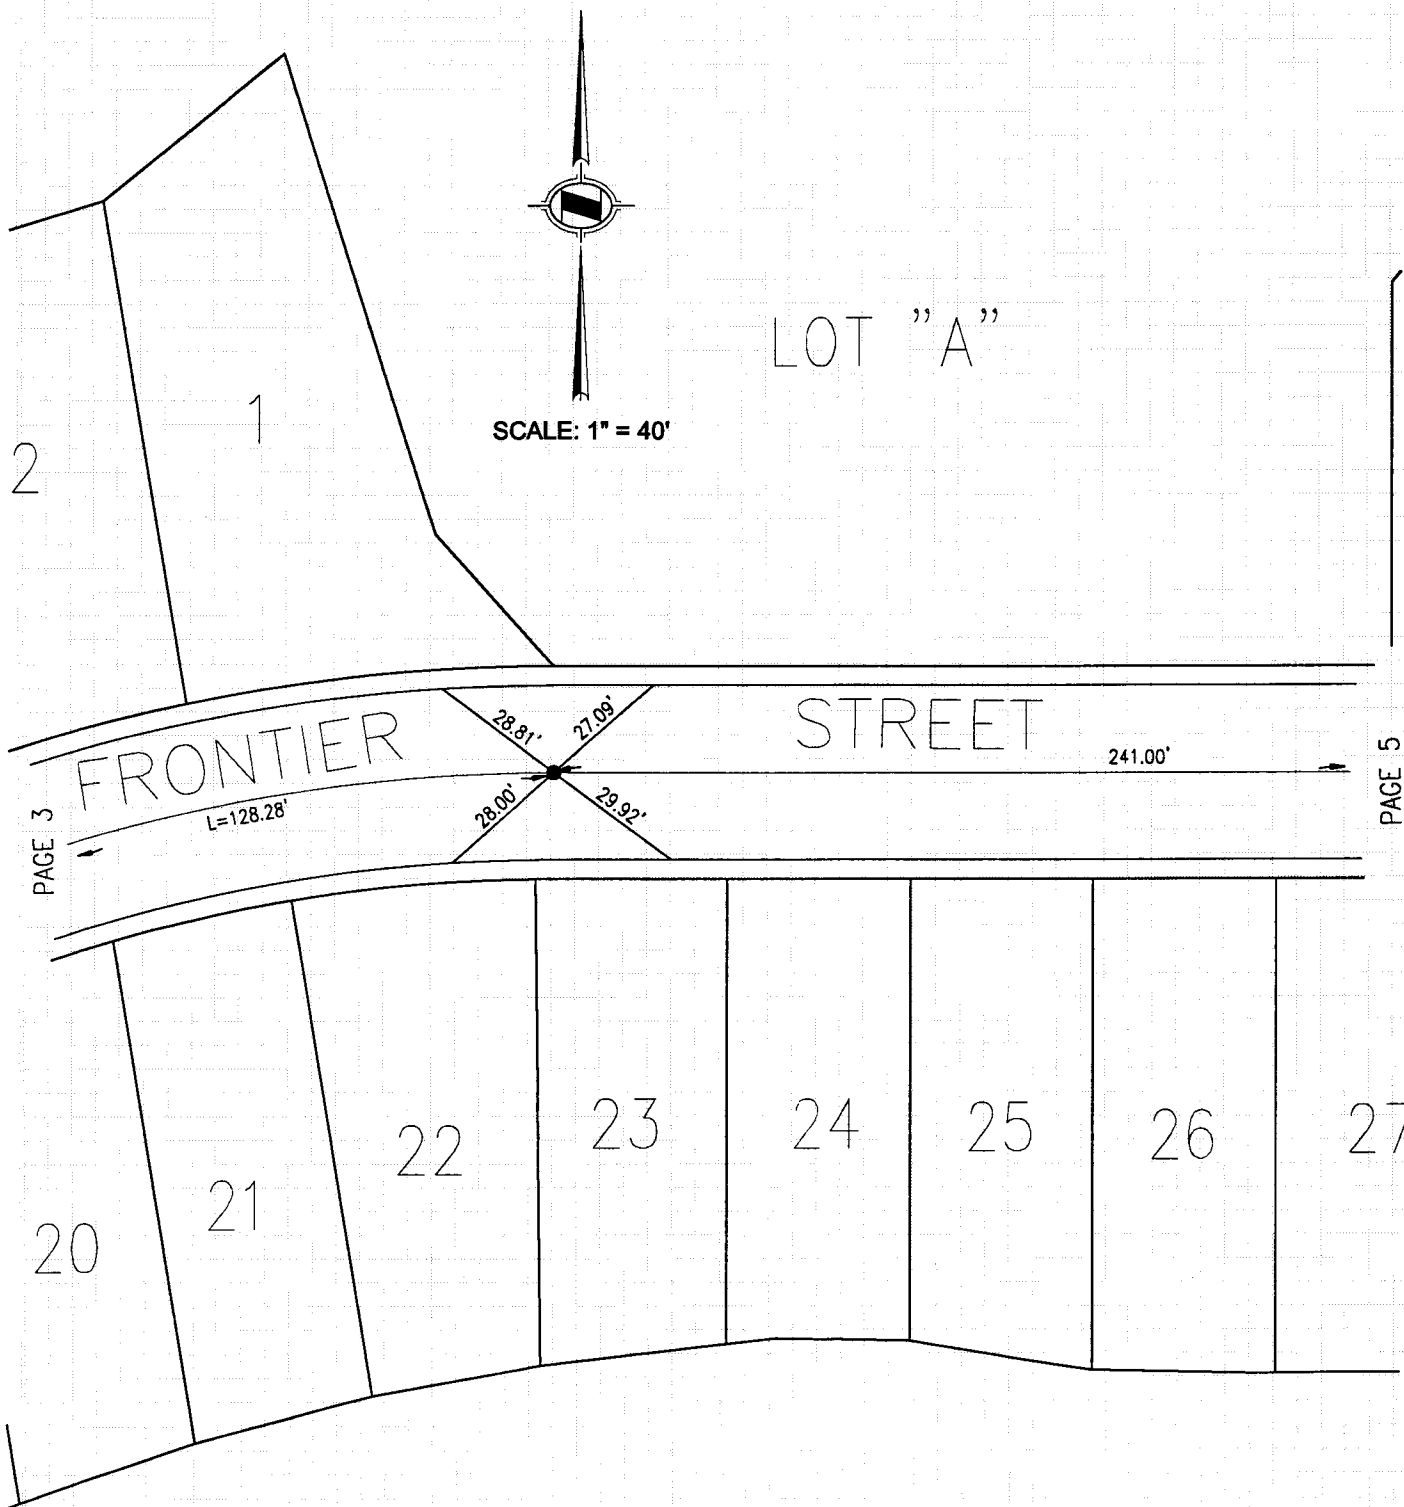

TRACT BDY.

SURVEY OF

INDEX

PAGE

HUNSAKER & ASSOCIATES, INC.

MARCH 30, 1998


NOTE

ALL TIE POINTS ARE
L & T TAGGED R.C.E. 23956
SET IN TOP OF CURB
UNLESS OTHERWISE NOTED.

LAND SURVEYOR: TOM R. MCGANNON, R.C.E. 23956

LEGEND

● INDICATES SET 8" SPIKE &
WASHER STAMPED R.C.E. 23956
UNLESS OTHERWISE NOTED.

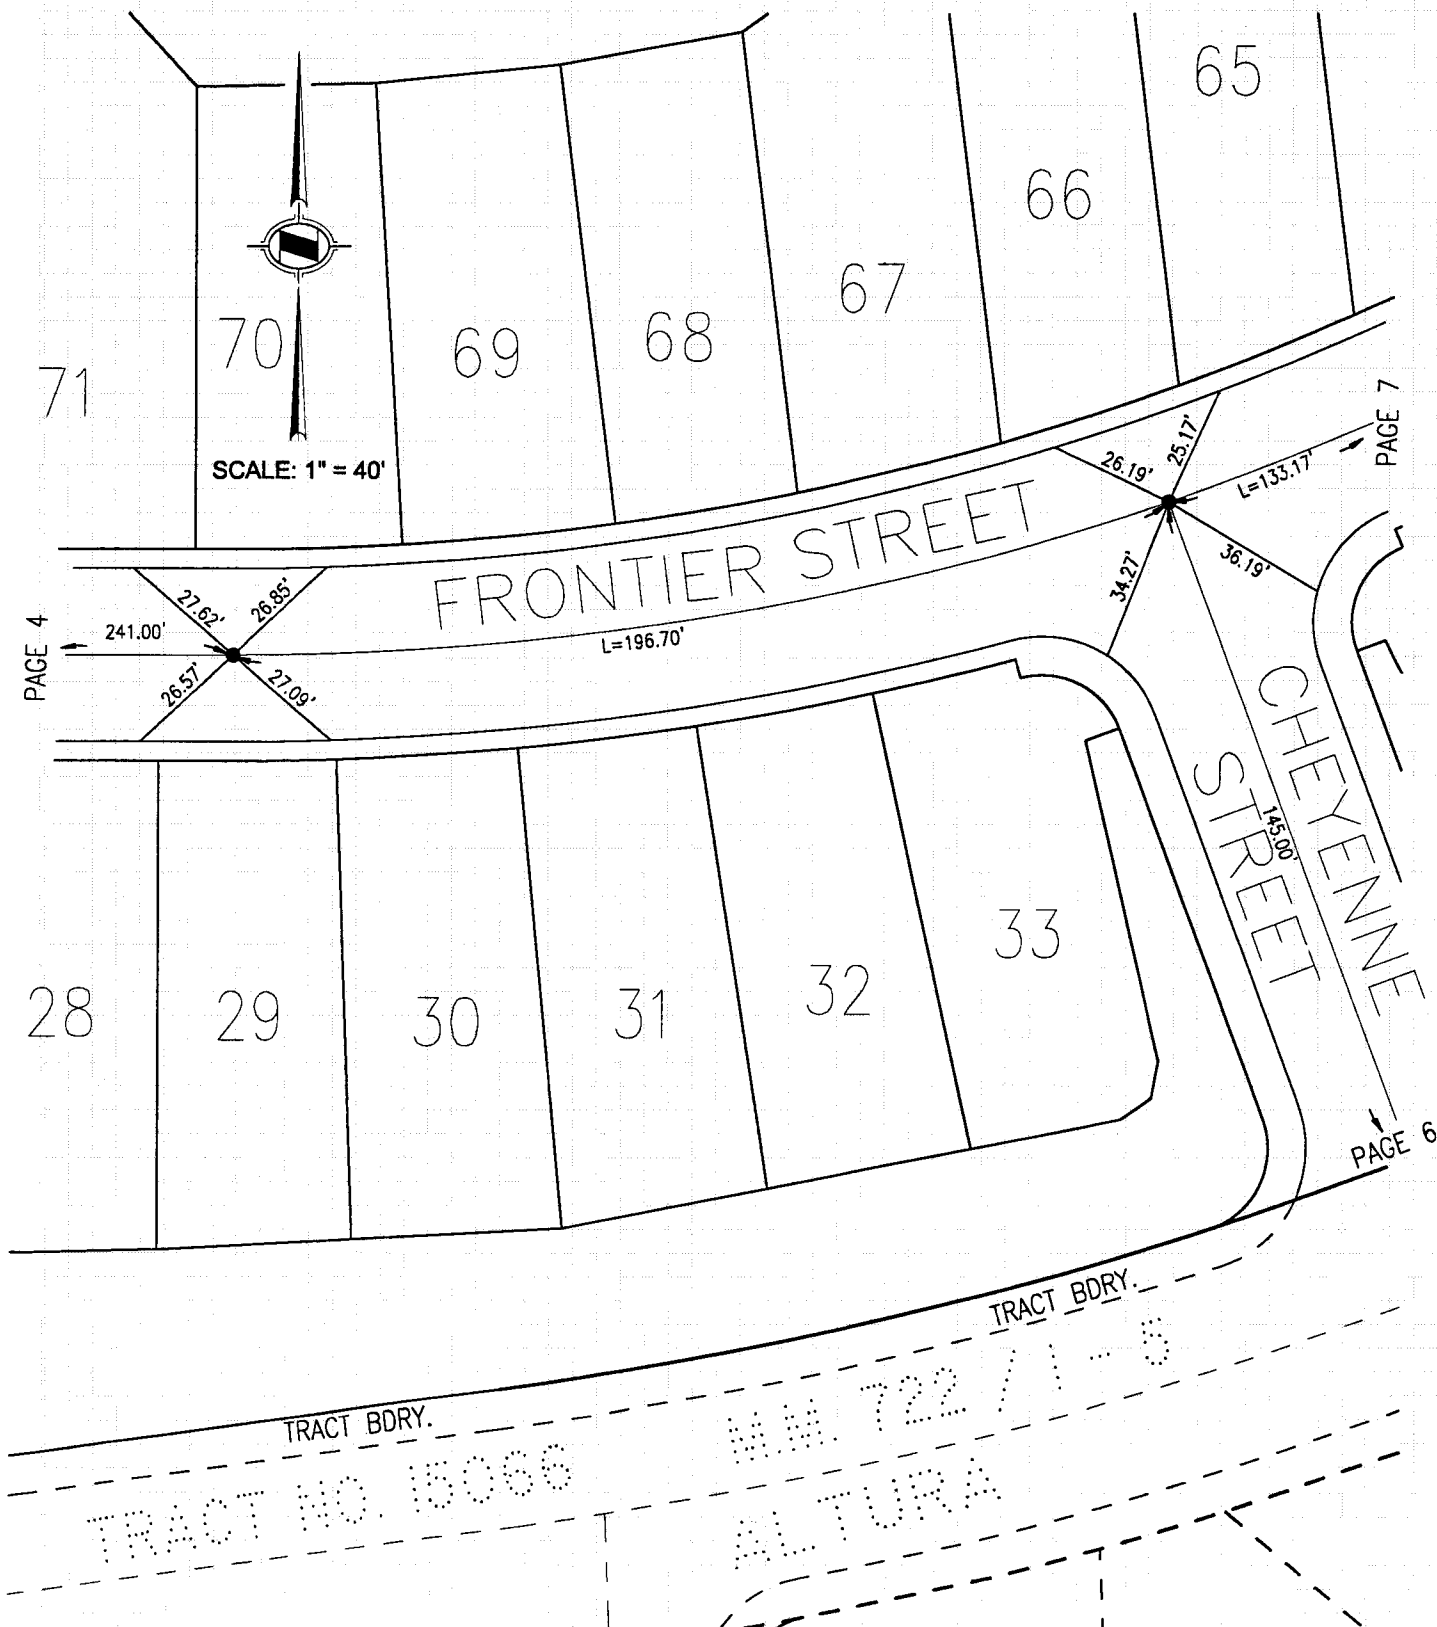

HUNSAKER & ASSOCIATES, INC.

MARCH 30, 1998

ORANGE COUNTY SURVEYOR


NOTE

LAND SURVEYOR: TOM R. McGANNON, R.C.E. 23956

ALL TIE POINTS ARE
L & T TAGGED R.C.E. 23956
SET IN TOP OF CURB
UNLESS OTHERWISE NOTED.

LEGEND

- INDICATES SET 8" SPIKE & WASHER STAMPED R.C.E. 23956 UNLESS OTHERWISE NOTED.
- ▲ INDICATES SPIKE & WASHER SET PER TRACT 13575

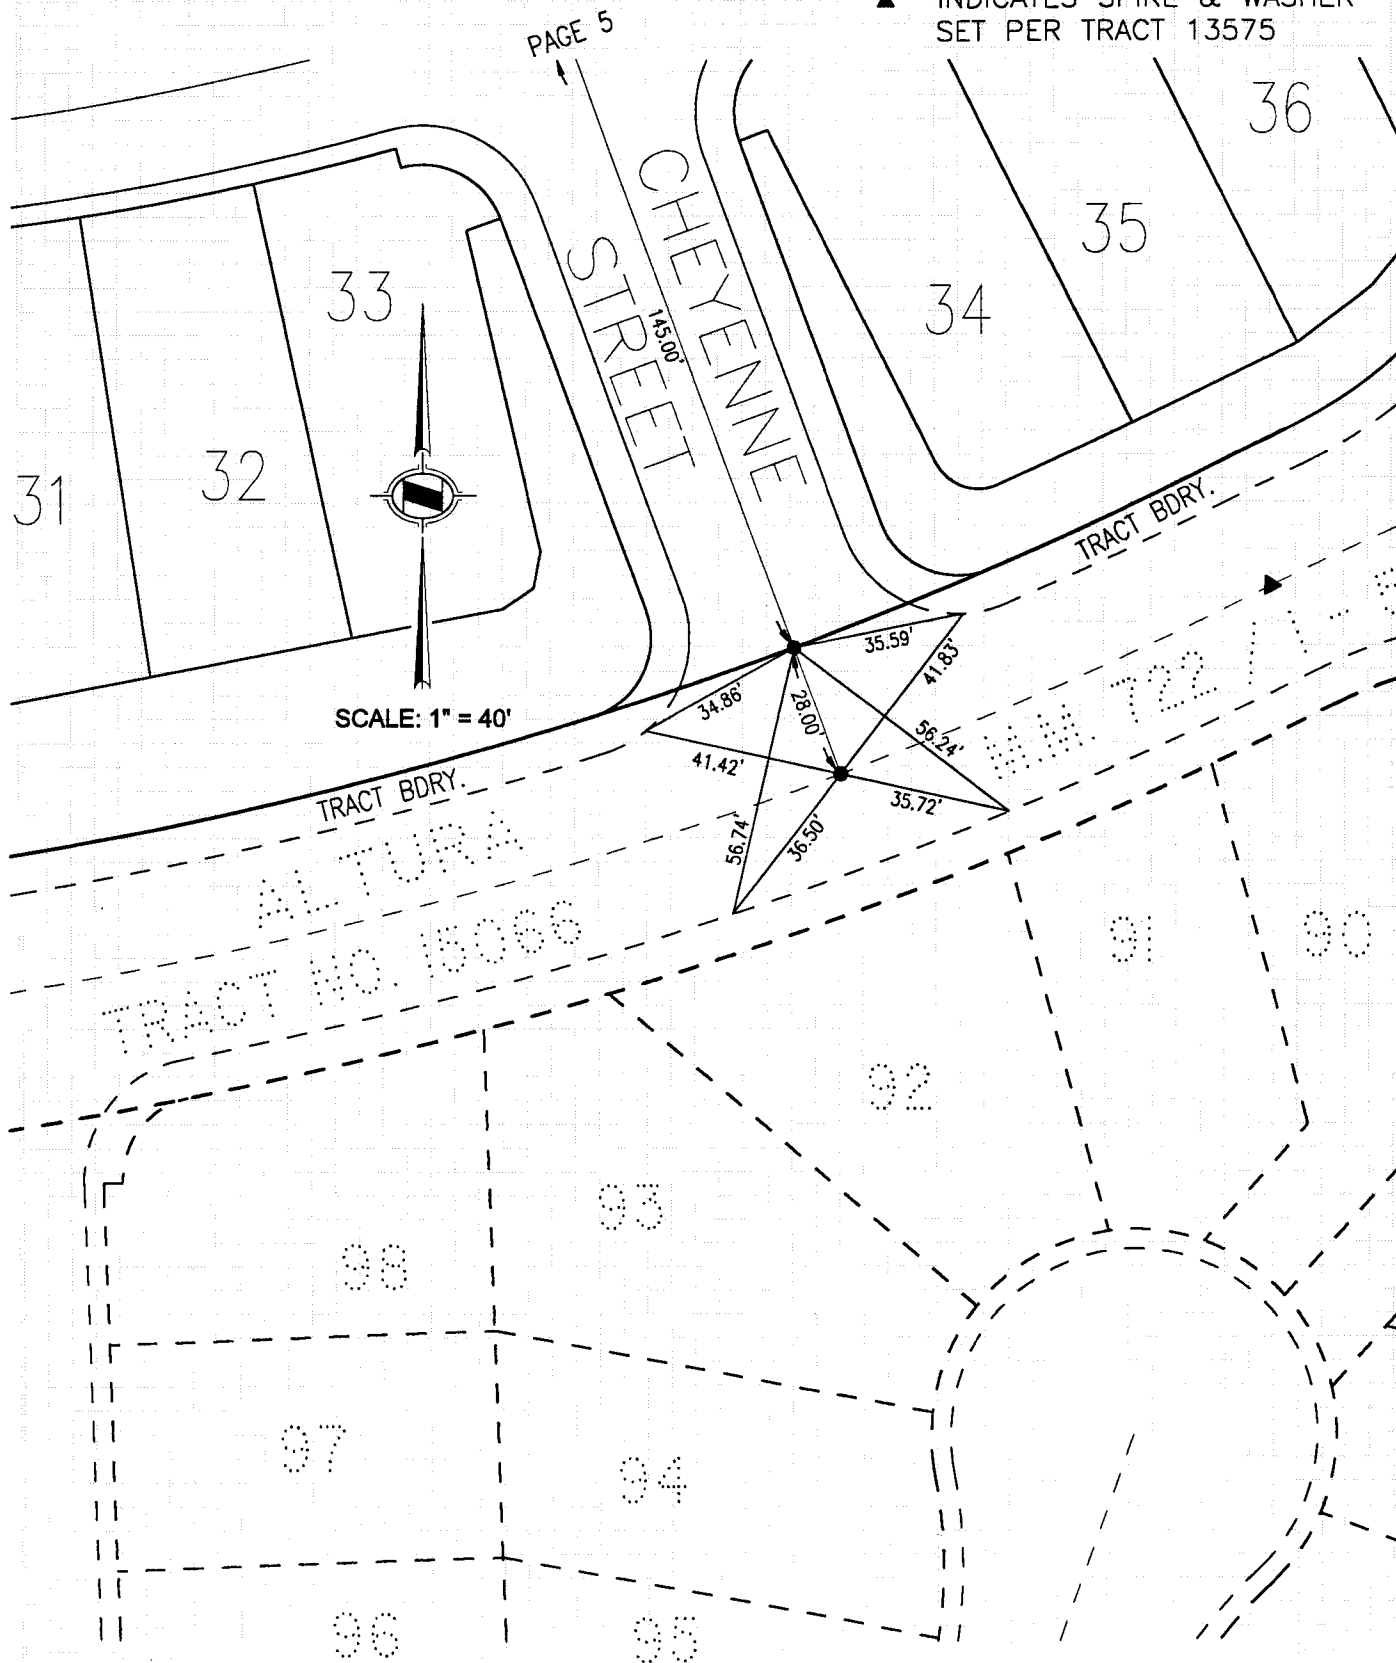

HUNSAKER & ASSOCIATES, INC.

MARCH 30, 1998


NOTE

ALL TIE POINTS ARE
L & T TAGGED R.C.E. 23956
SET IN TOP OF CURB
UNLESS OTHERWISE NOTED.

LAND SURVEYOR: TOM R. MCGANNON, R.C.E. 23956

LEGEND

● INDICATES SET 8" SPIKE &
WASHER STAMPED R.C.E. 23956
UNLESS OTHERWISE NOTED.

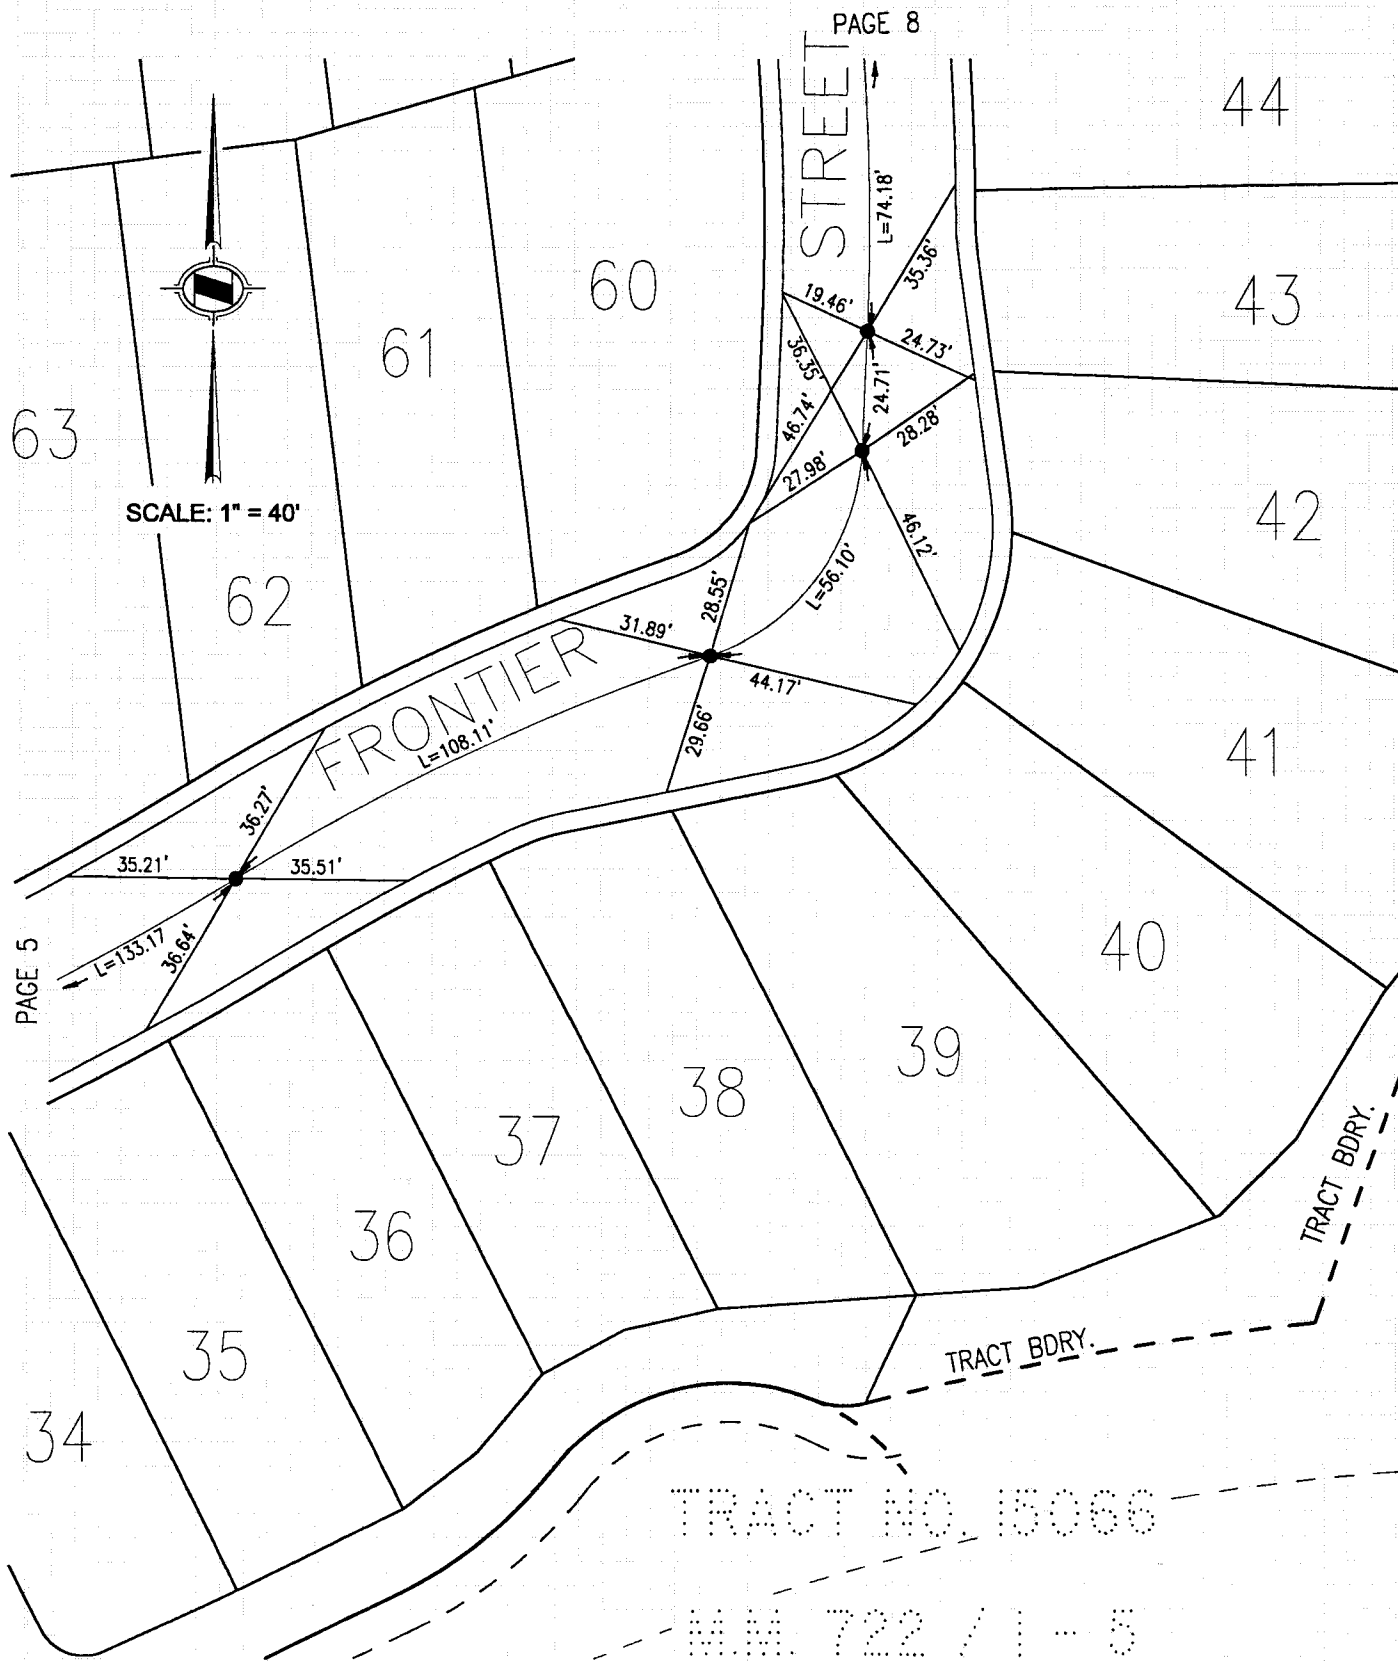

HUNSAKER & ASSOCIATES, INC.

MARCH 30, 1998

ORANGE COUNTY SURVEYOR

NOTE

LAND SURVEYOR: TOM R. MCGANNON, R.C.E. 23956

ALL TIE POINTS ARE
L & T TAGGED R.C.E. 23956
SET IN TOP OF CURB
UNLESS OTHERWISE NOTED.

LEGEND

● INDICATES SET 8" SPIKE &
WASHER STAMPED R.C.E. 23956
UNLESS OTHERWISE NOTED.

