

Block: 5259, Module: 00, #10

WM44E


CORNER RECORD

Document Number

98-462

City of UNINCORPORATEDCounty of ORANGE

, California

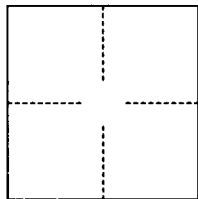Brief Legal Description TIES FOR 15064

CORNER TYPE

Government Corner ☐Control ☐Meander ☐Property ☒Rancho ☐Other ☐Date of Survey FEBRUARY 13, 1998

COORDINATES

(Optional)

N. _____

E. _____

Zone _____ Datum _____

Elev. _____

Corner —

Left as found ☐Found and tagged ☐Established ☒Reestablished ☐Rebuilt ☐

Identification and type of corner found: Evidence used to identify or procedure used to establish or reestablish the corner:

SET SLIKE & WASHER, R.C.E. 23956 AT THE CENTERLINE OF THE STREETS IN THIS TRACTON HOMESTEAD DRIVE, RAINDANCE STREET, CLEMENTINE STREET AND ABILENE DRIVE.

A description of the physical condition of the monument as found and as set or reset: _____

SURVEYOR'S STATEMENT

This Corner Record was prepared by me or under my direction in conformance with the

Land Surveyors' Act on NOVEMBER 3RD, 19 98.Signed Tom R. McGannon L.S. or R.C.E. Number 23956

COUNTY SURVEYOR'S STATEMENT

This Corner Record was received Dec. 23, 19 98 and examinedand filed January 5th, 19 99.Signed Robert Jelinek Title _____

DEPUTY COUNTY SURVEYOR

County Surveyor's Comment _____



HUNSAKER & ASSOCIATES, INC.

FEBRUARY 13, 1998


NOTE

ALL TIE POINTS ARE
L & T TAGGED R.C.E. 23956
SET IN TOP OF CURB
UNLESS OTHERWISE NOTED.

LAND SURVEYOR: TOM R. McGANNON, R.C.E. 23956

LEGEND

● INDICATES SET 8" SPIKE &
WASHER STAMPED R.C.E. 23956
UNLESS OTHERWISE NOTED.

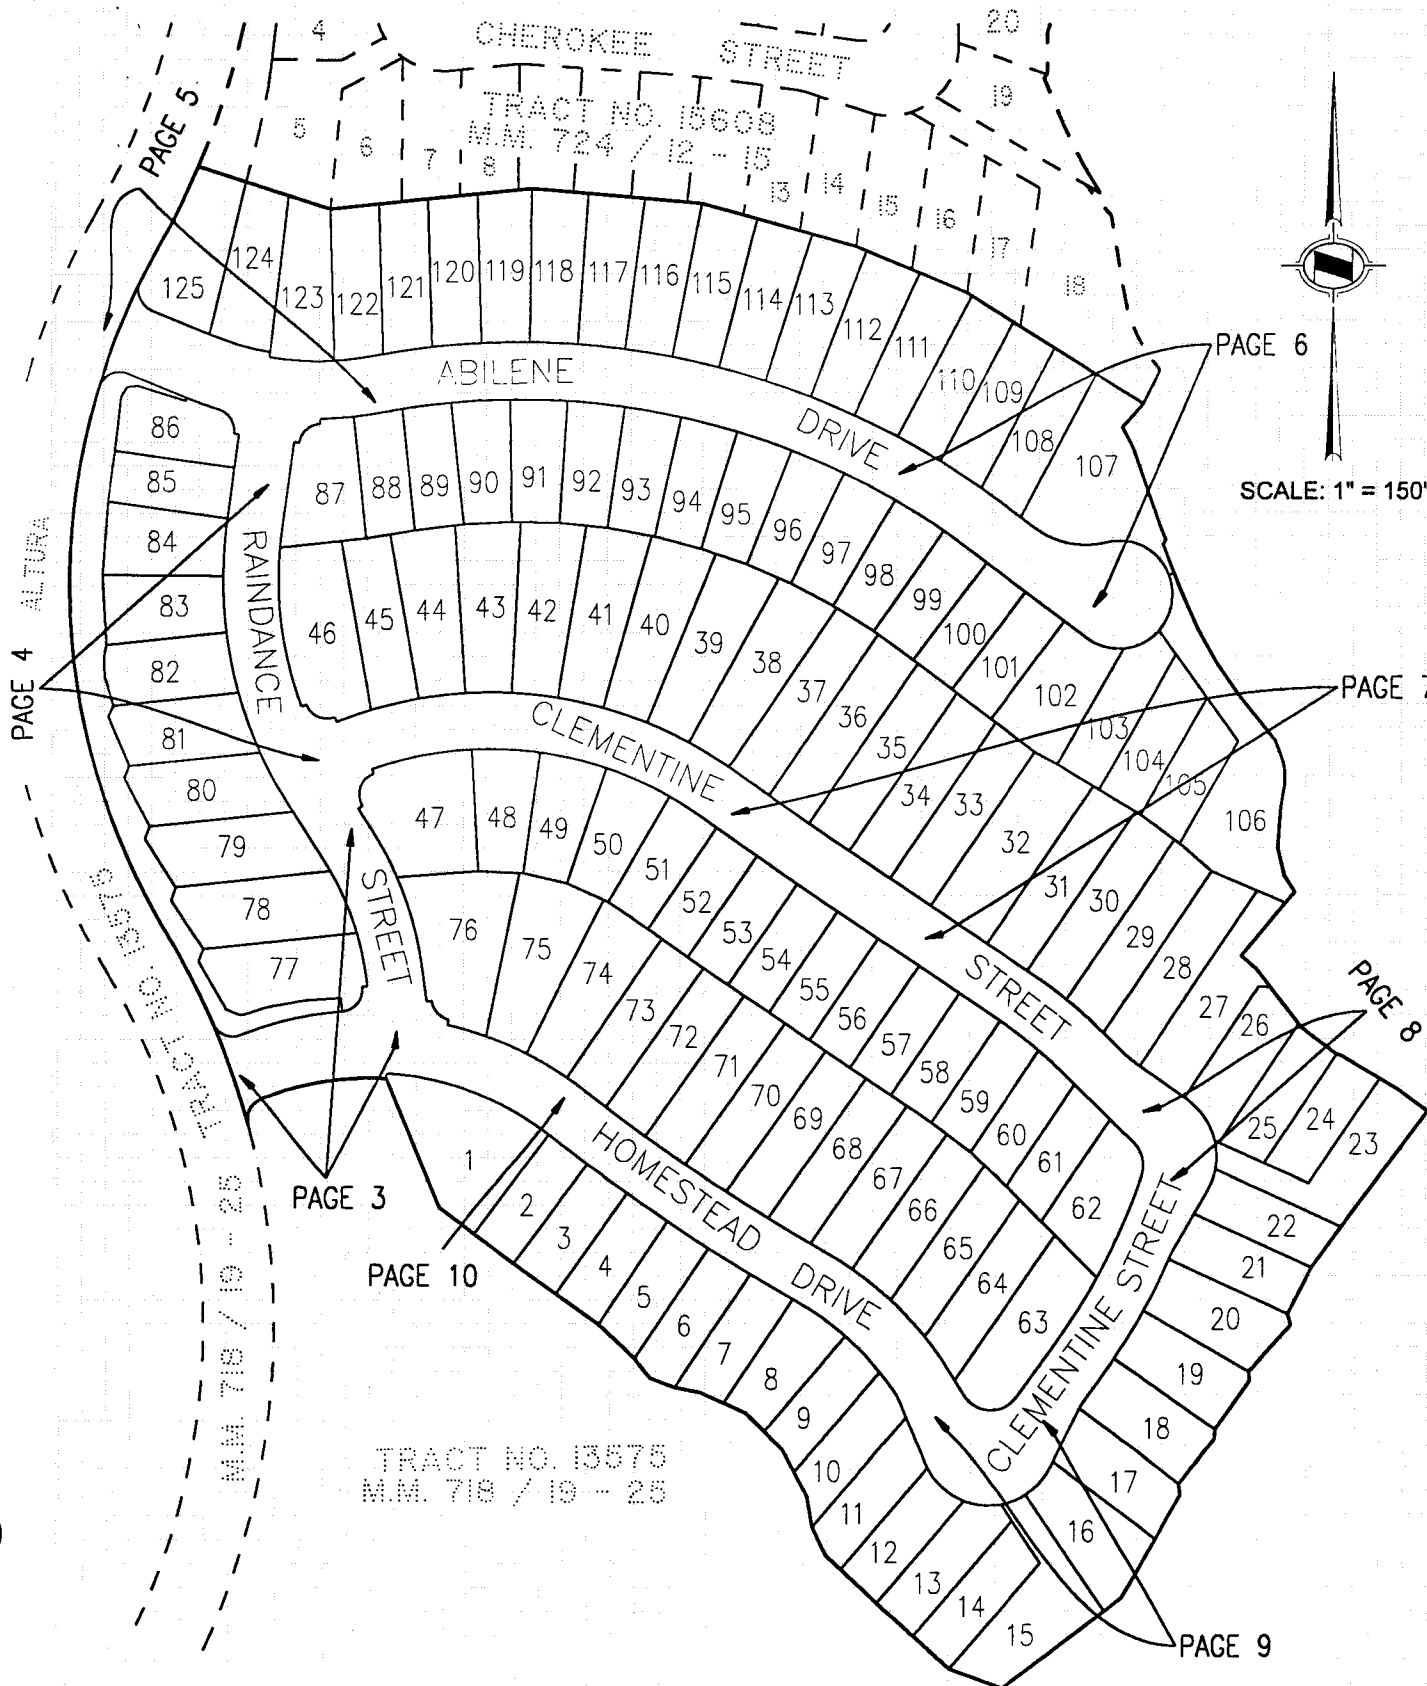

HUNSAKER & ASSOCIATES, INC.

FEBRUARY 13, 1998


NOTE

ALL TIE POINTS ARE
L & T TAGGED R.C.E. 23956
SET IN TOP OF CURB
UNLESS OTHERWISE NOTED.

LAND SURVEYOR: TOM R. MCGANNON, R.C.E. 23956

LEGEND

● INDICATES SET 8" SPIKE &
WASHER STAMPED R.C.E. 23956
UNLESS OTHERWISE NOTED.

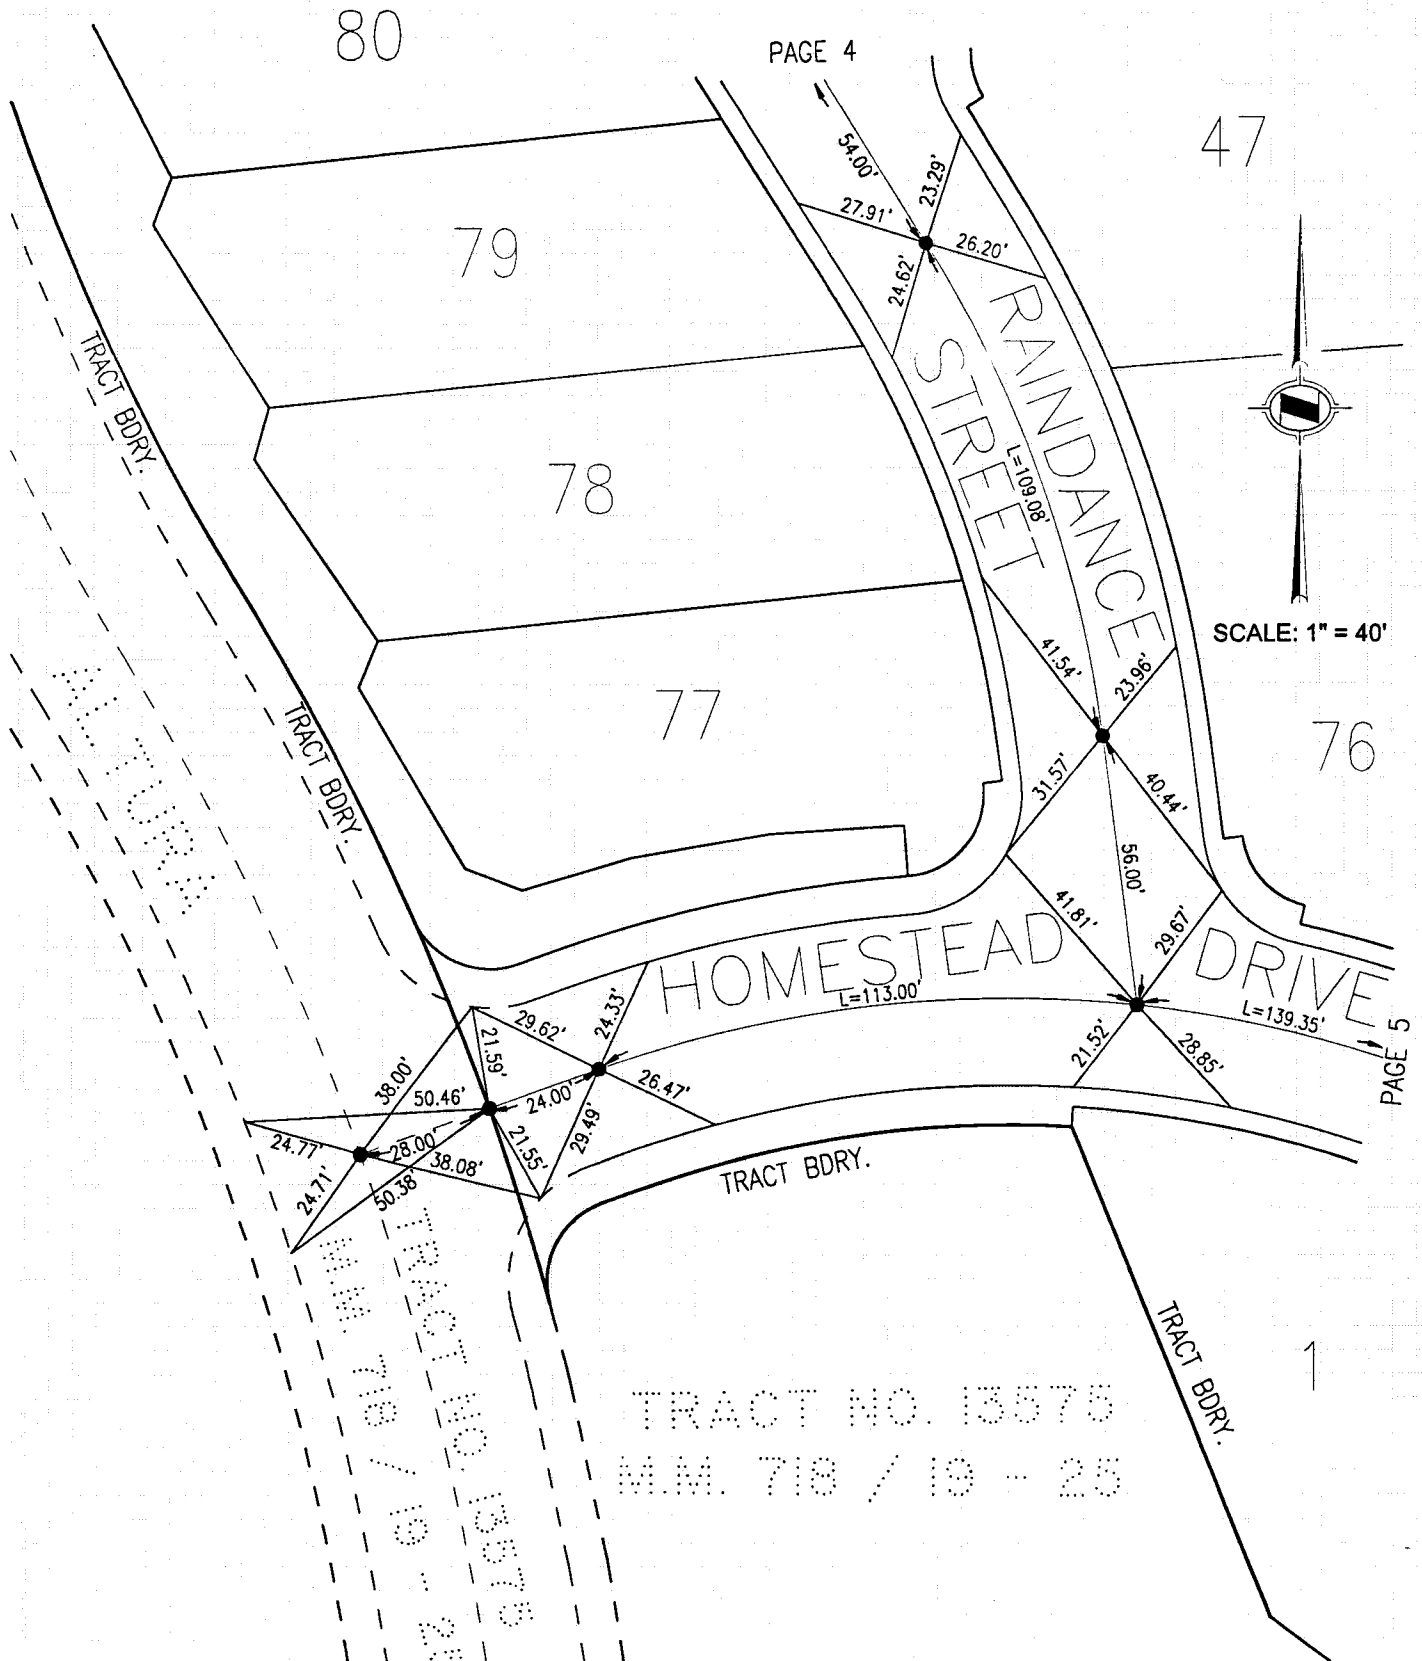

TRACT NO. 13575
M.M. 718 / 19 - 25

SURVEYED BY HUNSAKER & ASSOCIATES, INC.

FEBRUARY 13, 1998

GRAND COUNTY SURVEYOR


NOTE

LAND SURVEYOR: TOM R. McGANNON, R.C.E. 23956

ALL TIE POINTS ARE
L & T TAGGED R.C.E. 23956
SET IN TOP OF CURB
UNLESS OTHERWISE NOTED.

LEGEND

● INDICATES SET 8" SPIKE &
WASHER STAMPED R.C.E. 23956
UNLESS OTHERWISE NOTED.

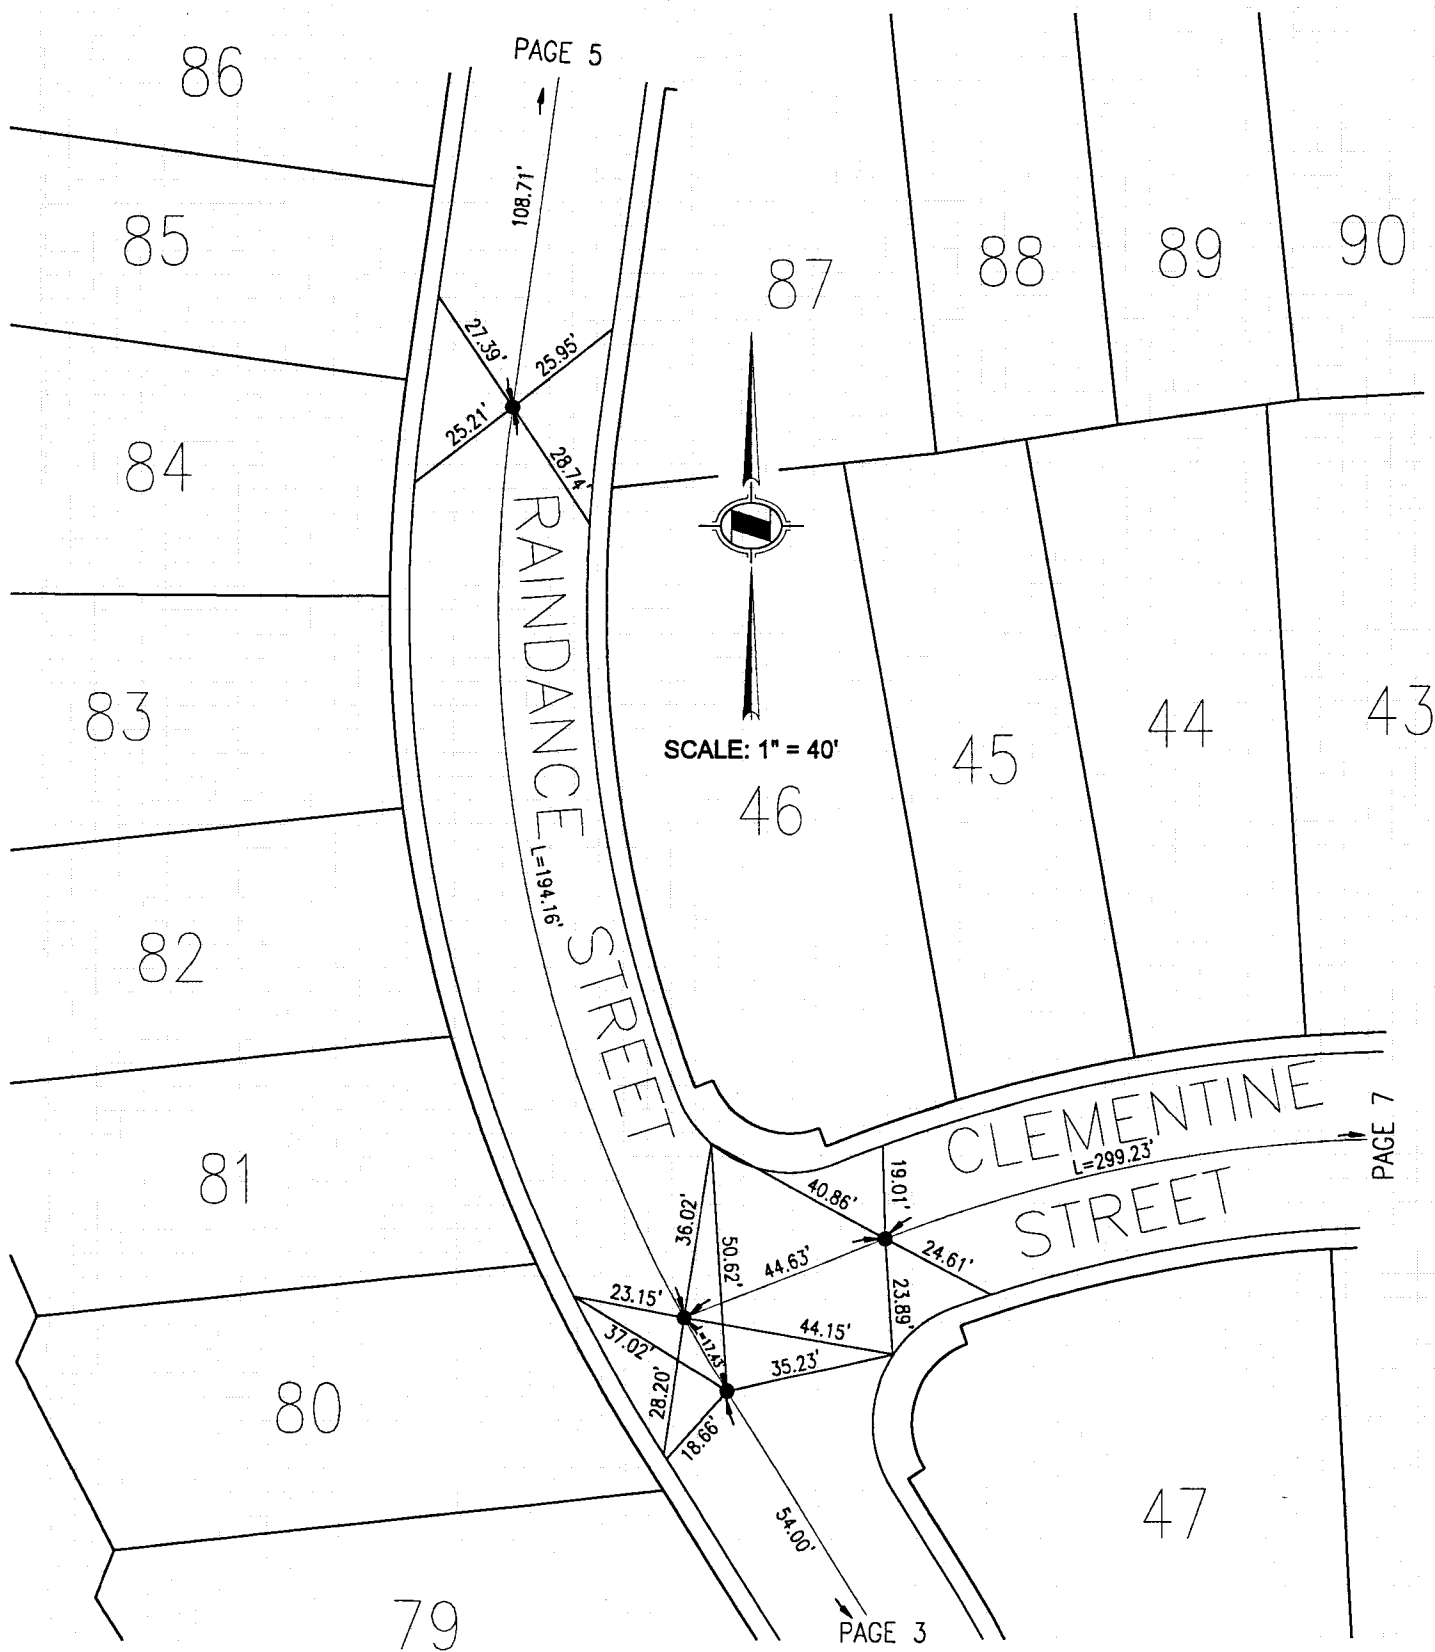


NOTE

ALL TIE POINTS ARE
L & T TAGGED R.C.E. 23956
SET IN TOP OF CURB
UNLESS OTHERWISE NOTED.

LEGEND

● INDICATES SET 8" SPIKE &
WASHER STAMPED R.C.E. 23956
UNLESS OTHERWISE NOTED.

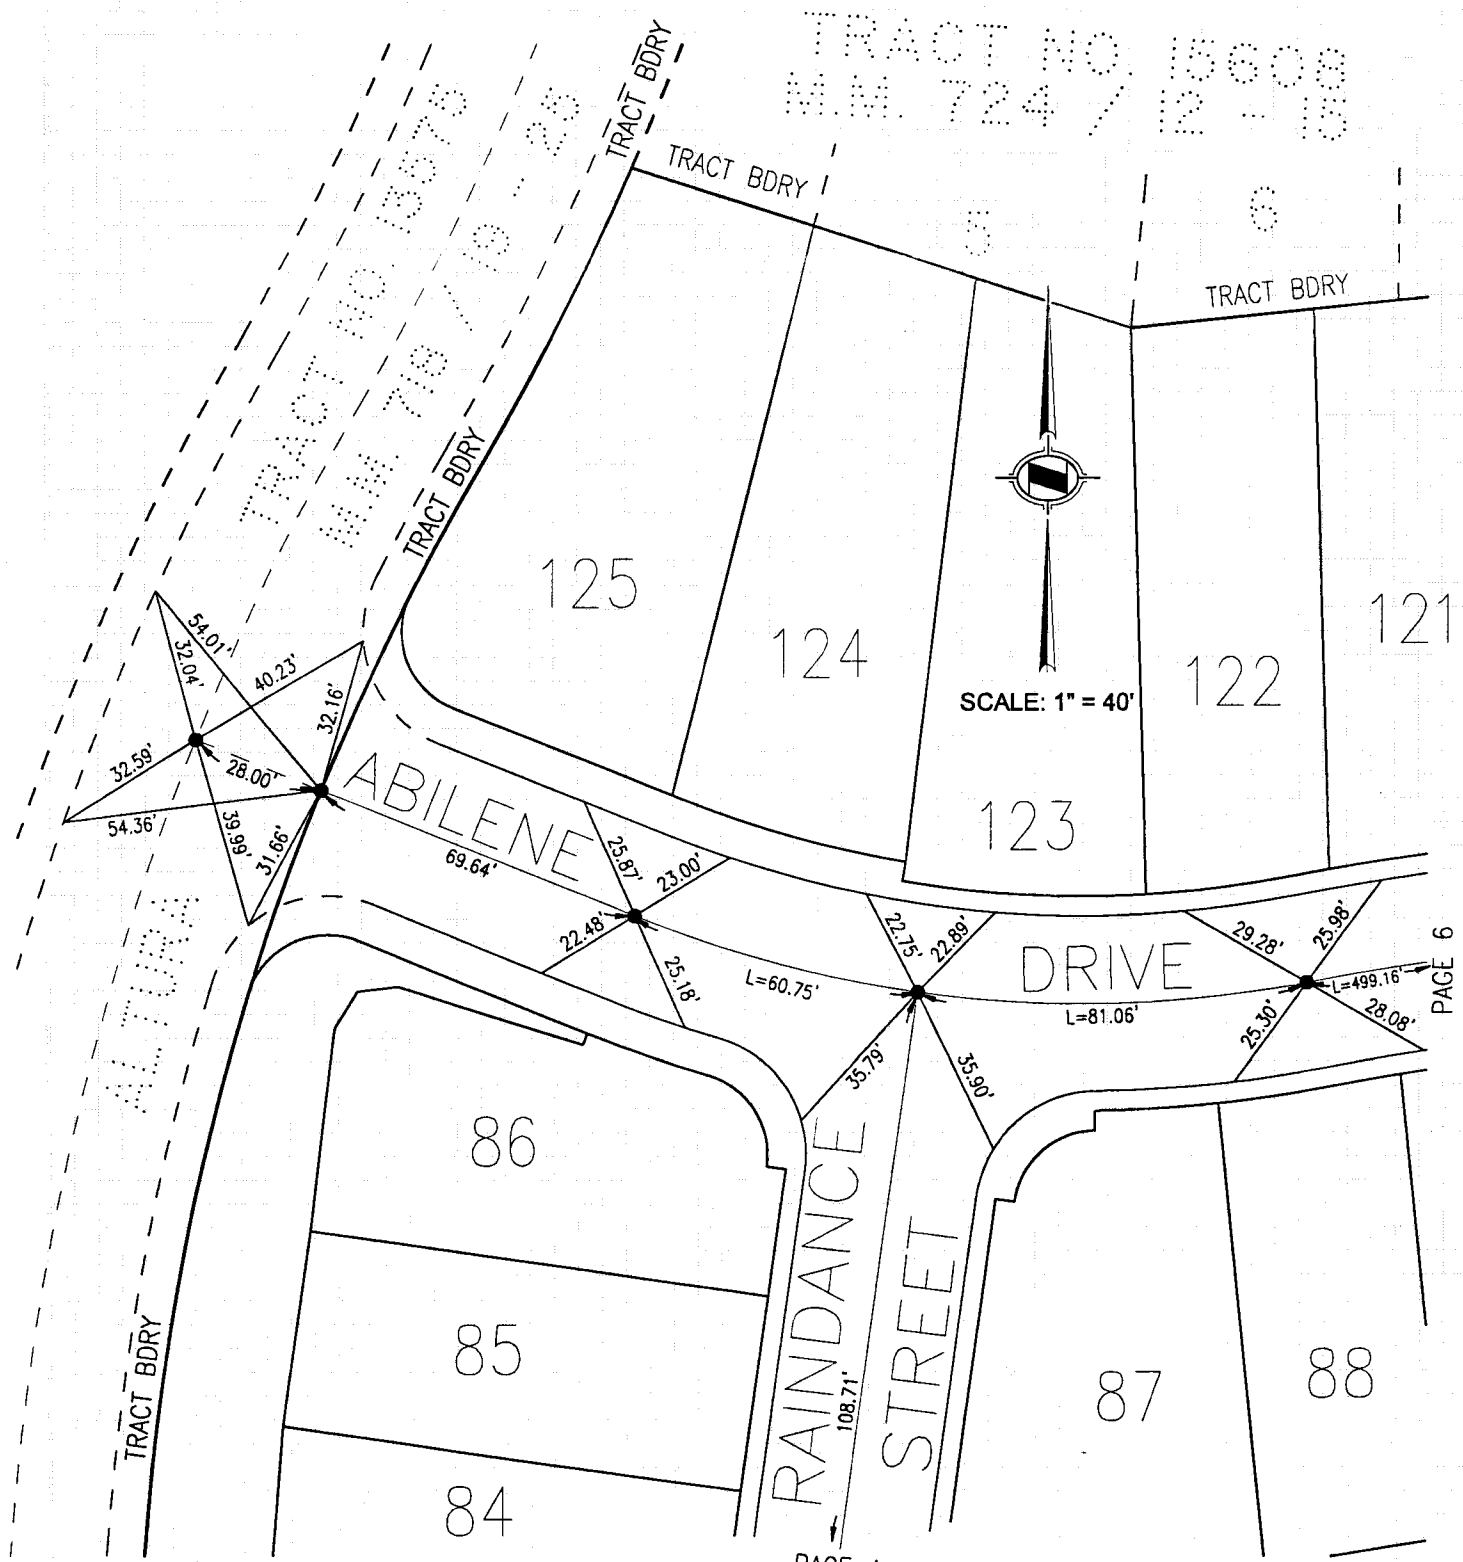

HUNSAKER & ASSOCIATES, INC.

FEBRUARY 13, 1998

LAND SURVEYOR: TOM R. McGANNON, R.C.E. 23956


GRANGE COUNTY SURVEYOR

NOTE

ALL TIE POINTS ARE
L & T TAGGED R.C.E. 23956
SET IN TOP OF CURB
UNLESS OTHERWISE NOTED.

LEGEND

● INDICATES SET 8" SPIKE &
WASHER STAMPED R.C.E. 23956
UNLESS OTHERWISE NOTED.

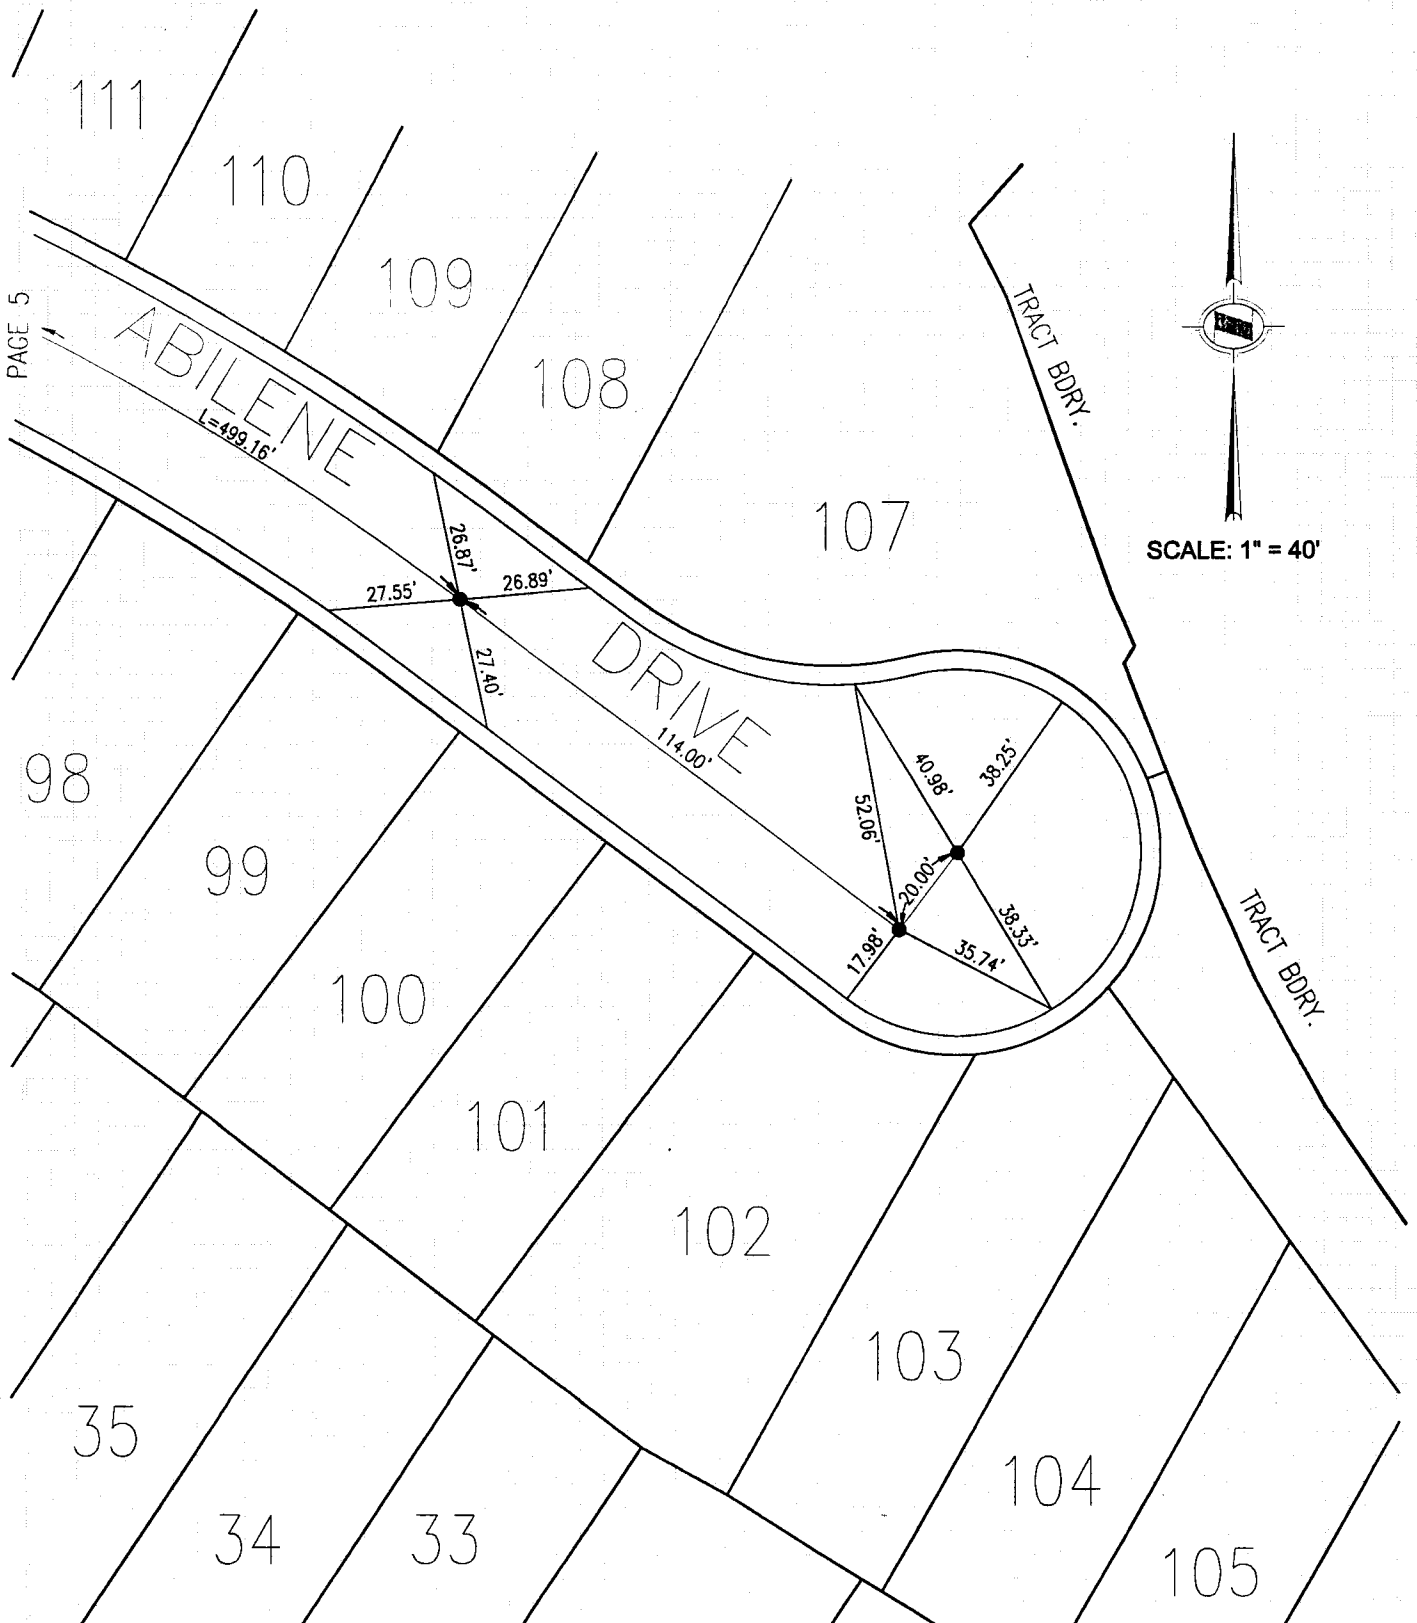


NOTE

ALL TIE POINTS ARE
 L & T TAGGED R.C.E. 23956
 SET IN TOP OF CURB
 UNLESS OTHERWISE NOTED.

LAND SURVEYOR: TOM R. McGANNON, R.C.E. 23956

LEGEND

● INDICATES SET 8" SPIKE &
 WASHER STAMPED R.C.E. 23956
 UNLESS OTHERWISE NOTED.

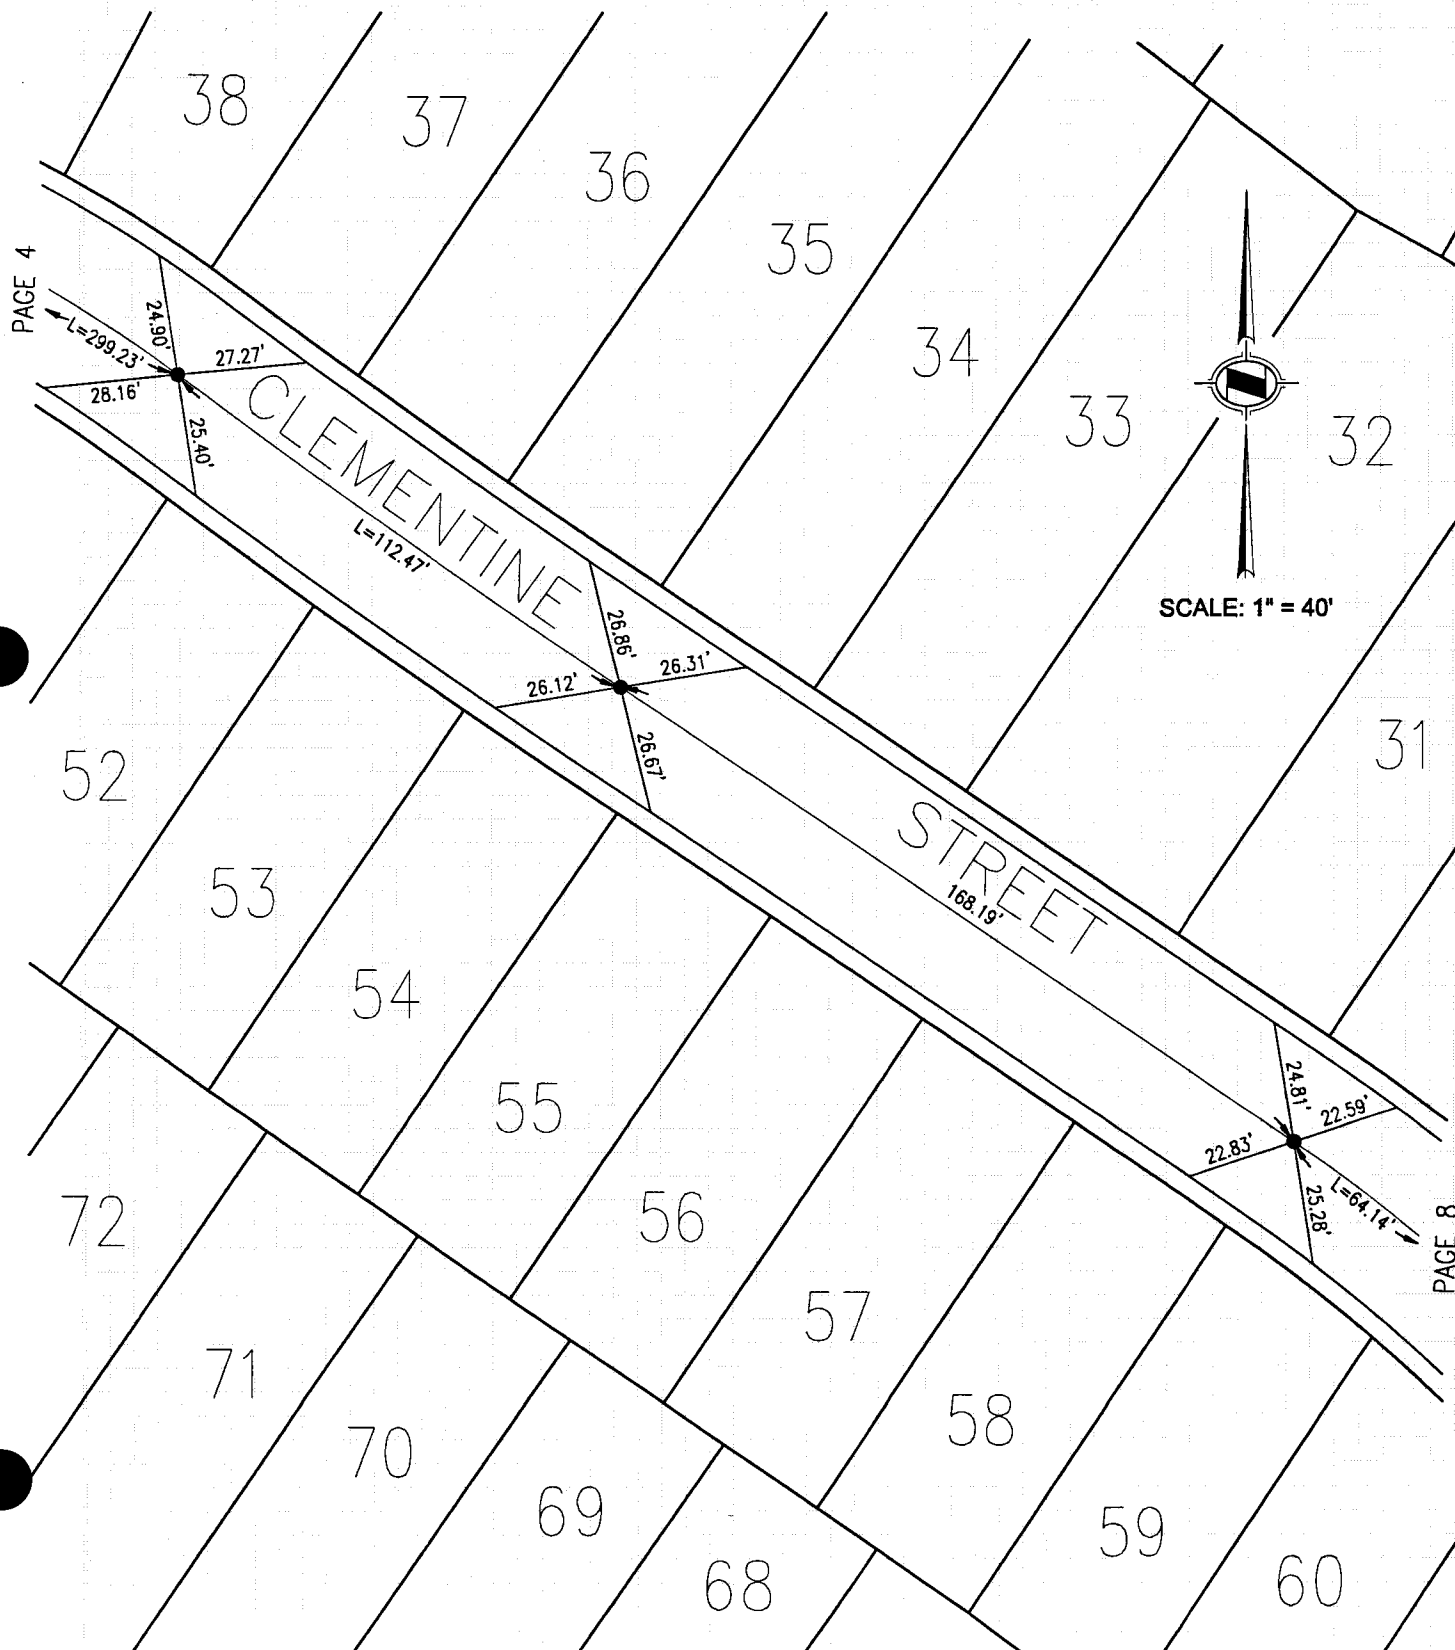

SURVEYED BY HUNSAKER & ASSOCIATES, INC. DATE FEBRUARY 13, 1998 ORANGE COUNTY SURVEYOR


NOTE

ALL TIE POINTS ARE
L & T TAGGED R.C.E. 23956
SET IN TOP OF CURB
UNLESS OTHERWISE NOTED.

LAND SURVEYOR: TOM R. McGANNON, R.C.E. 23956

LEGEND

● INDICATES SET 8" SPIKE &
WASHER STAMPED R.C.E. 23956
UNLESS OTHERWISE NOTED.

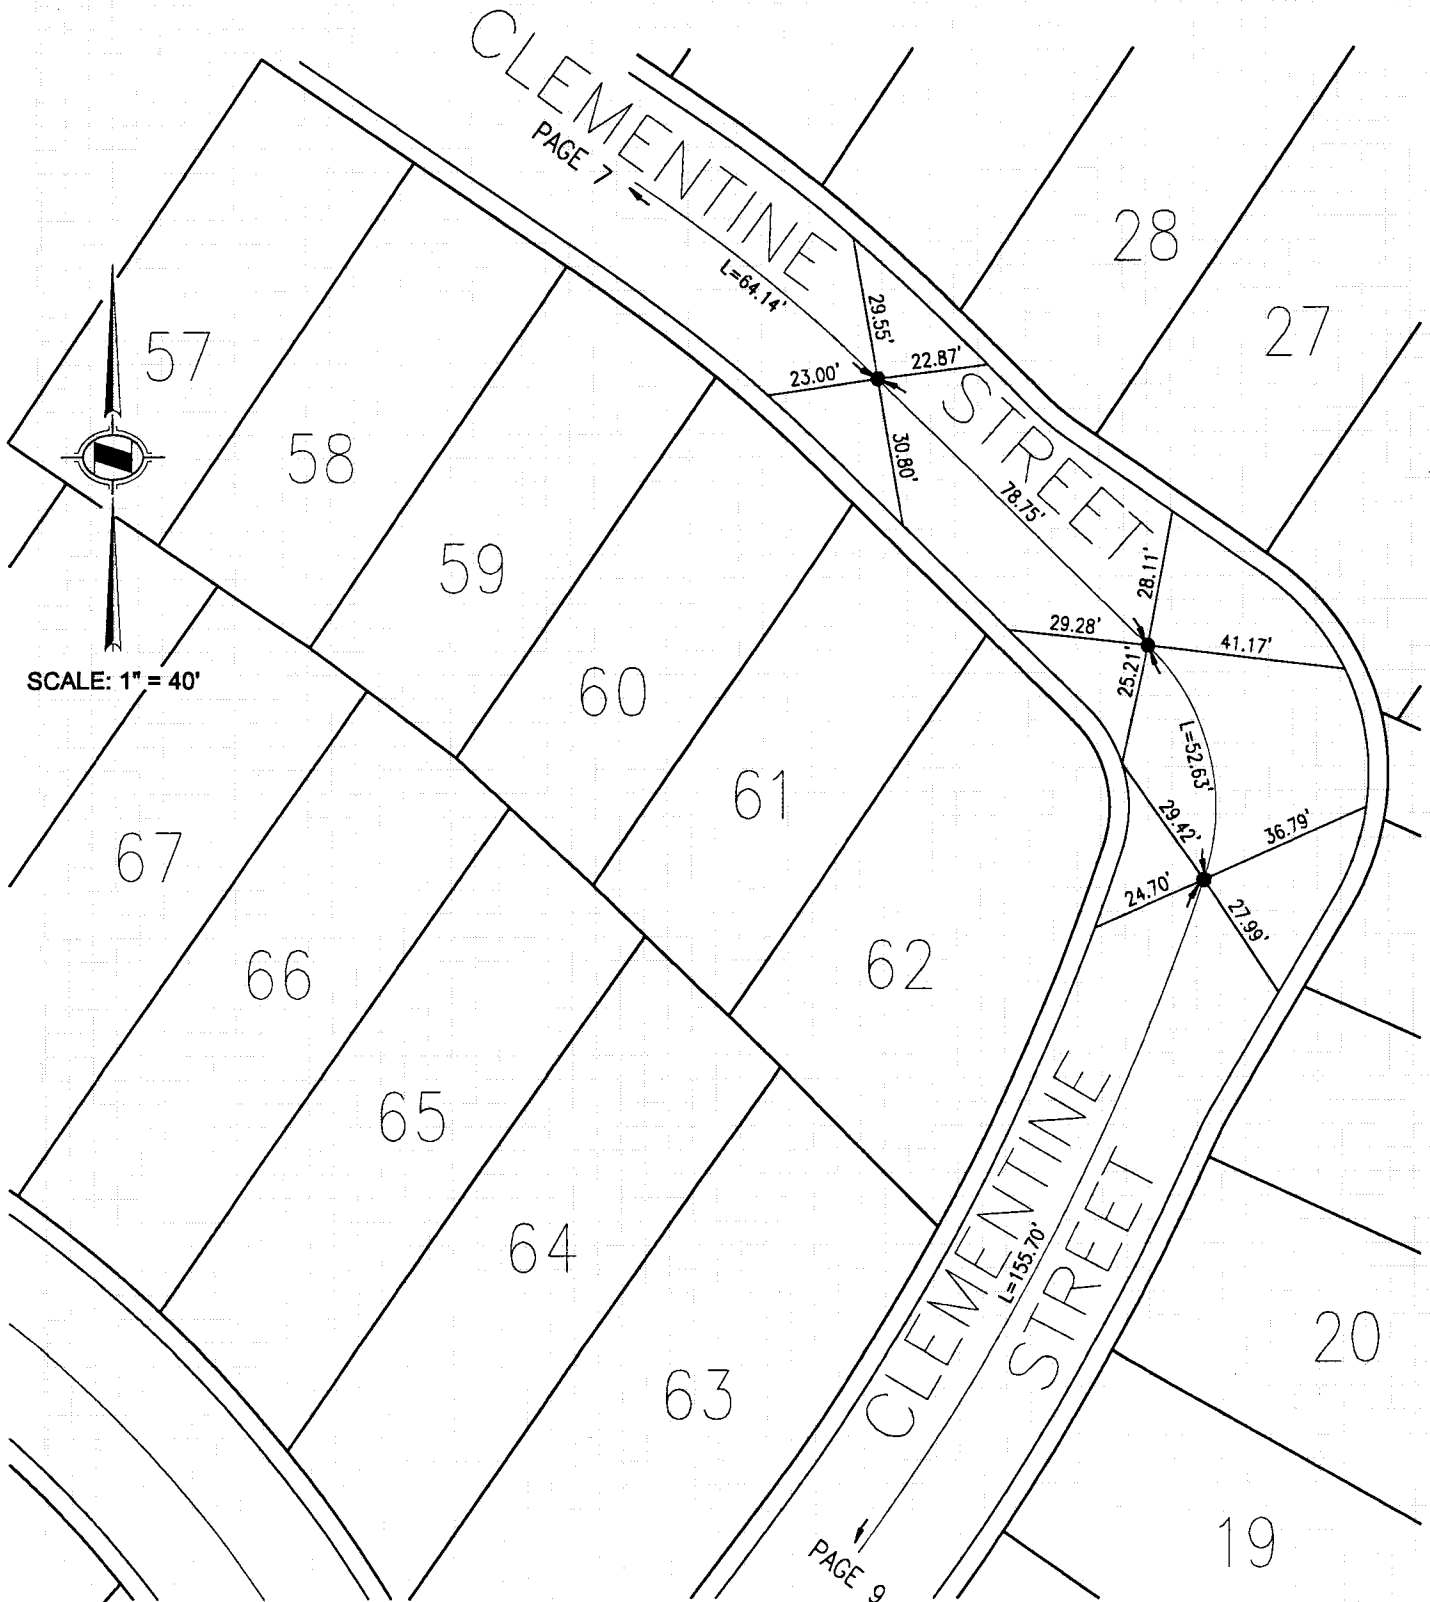

SURVEYED BY HUNSAKER & ASSOCIATES, INC.

FEBRUARY 13, 1998

ORANGE COUNTY SURVEYOR


NOTE

ALL TIE POINTS ARE
L & T TAGGED R.C.E. 23956
SET IN TOP OF CURB
UNLESS OTHERWISE NOTED.

LAND SURVEYOR: TOM R. McGANNON, R.C.E. 23956

LEGEND

● INDICATES SET 8" SPIKE &
WASHER STAMPED R.C.E. 23956
UNLESS OTHERWISE NOTED.

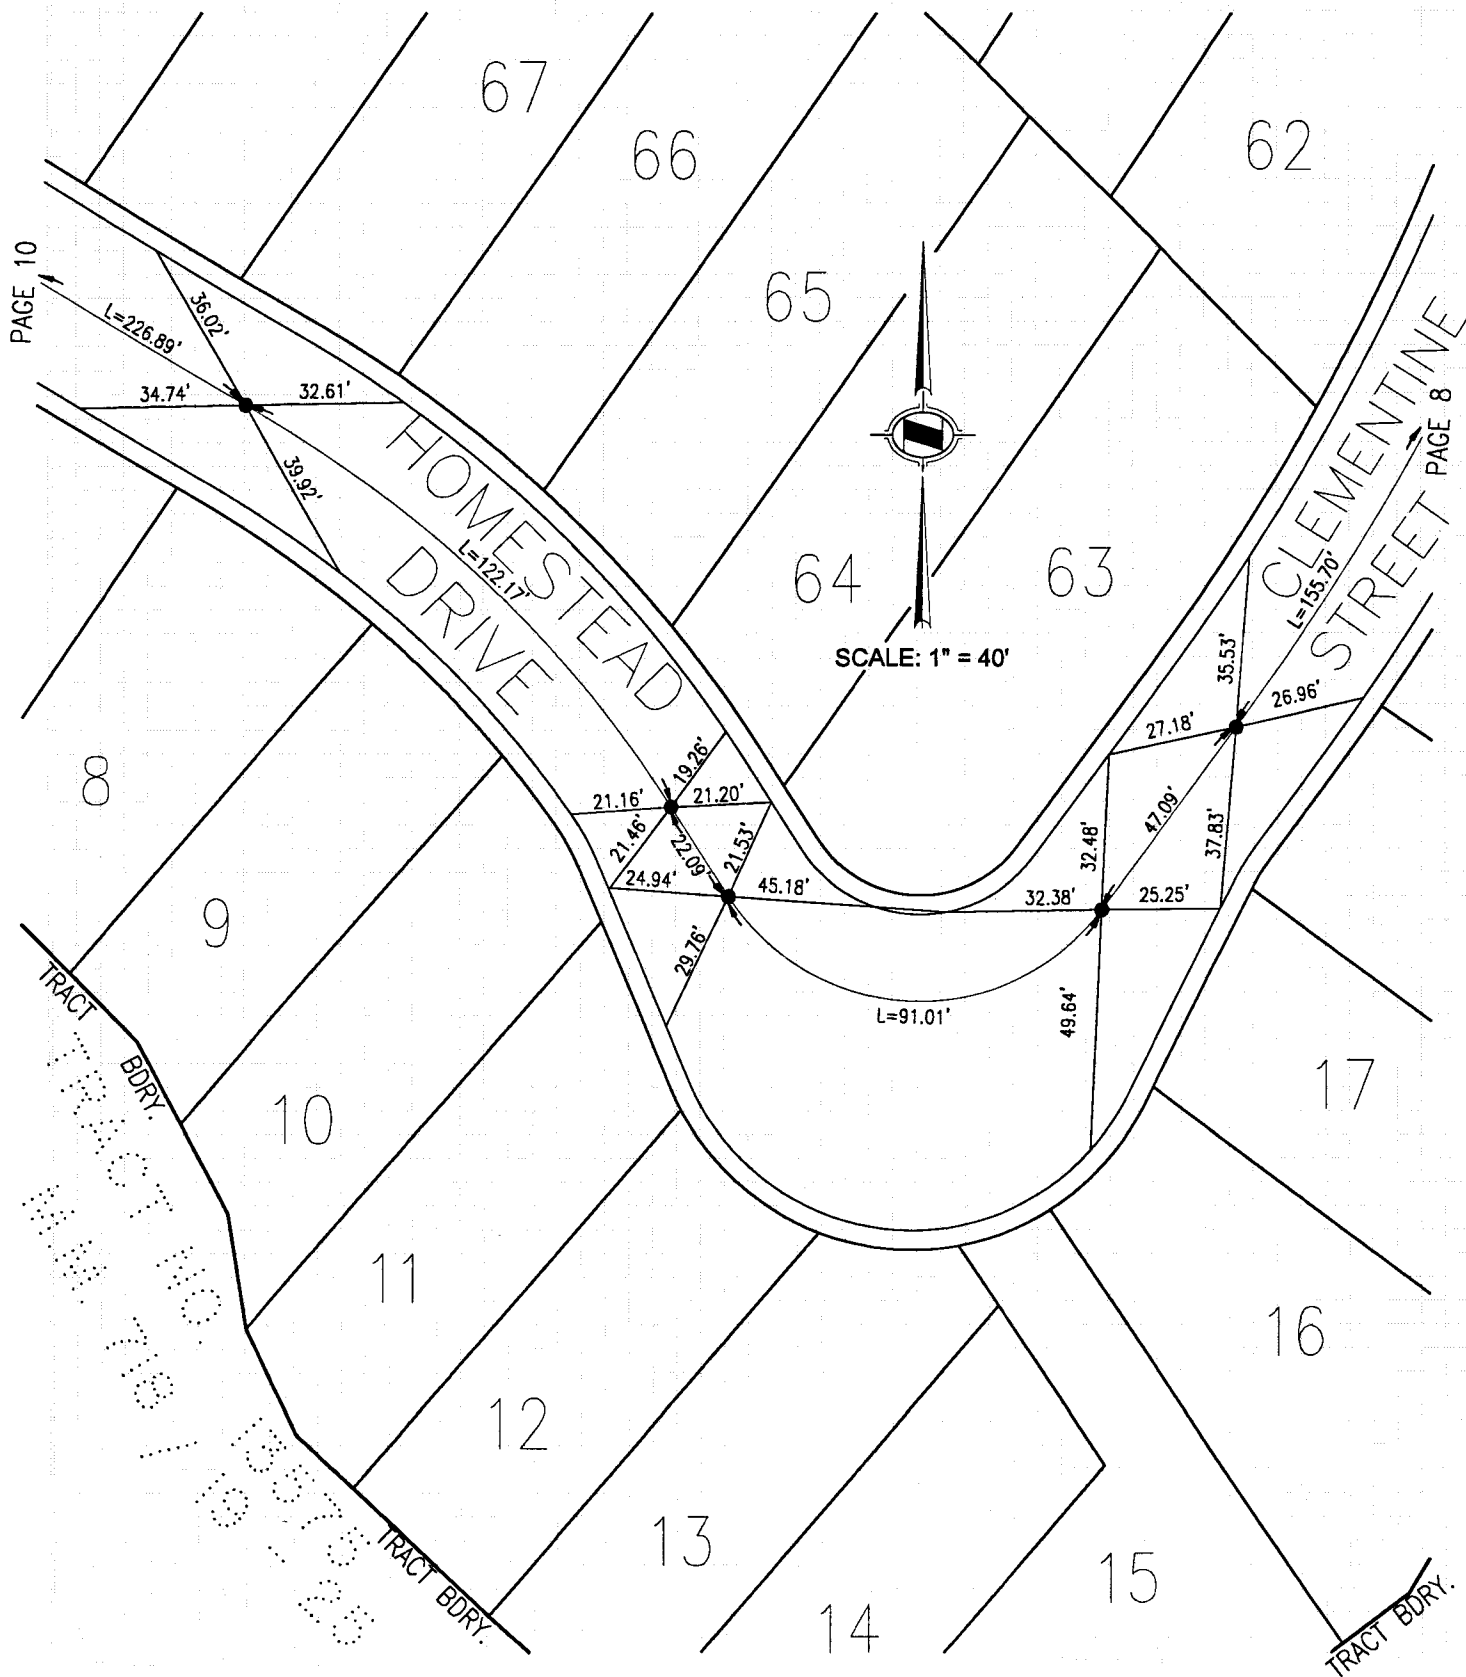

NOTE

LAND SURVEYOR: TOM R. McGANNON, R.C.E. 23956

ALL TIE POINTS ARE
L & T TAGGED R.C.E. 23956
SET IN TOP OF CURB
UNLESS OTHERWISE NOTED.

LEGEND

● INDICATES SET 8" SPIKE &
WASHER STAMPED R.C.E. 23956
UNLESS OTHERWISE NOTED.

