

Block: 5258, Module: 19, 29
CORNER RECORD


WM 40E

Document Number 98-463

City of UNINCORPORATED

County of ORANGE, California

Brief Legal Description TIES FOR 15065

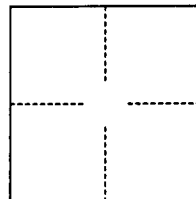

CORNER TYPE

Government Corner ☐ Control ☐
Meander ☐ Property ☒
Rancho ☐ Other ☐
Date of Survey SEPTEMBER 16, 1998

COORDINATES
(Optional)

N. _____
E. _____
Zone _____ Datum _____
Elev. _____

Corner — Left as found ☐ Found and tagged ☐ Established ☒ Reestablished ☐ Rebuilt ☐

Identification and type of corner found: Evidence used to identify or procedure used to establish or reestablish the corner:

SET SPIKE AND WASHER, R.C.E. 23956 AT THE CENTERLINE OF THE STREETS IN THIS TRACT
ON APACHE DRIVE, DROVER COURT, BRONCO STREET, STAMPEDE STREET AND JUNCTION
COURT.

A description of the physical condition of the monument as found and as set or reset: _____

SURVEYOR'S STATEMENT

This Corner Record was prepared by me or under my direction in conformance with the
Land Surveyors' Act on NOVEMBER 3RD, 19 98.


Signed Tom R. McGannon L.S. or R.C.E. Number 23956



COUNTY SURVEYOR'S STATEMENT

This Corner Record was received Dec. 23 19 98 and examined
and filed January 14th 19 99.

Signed Robert Jelinek Title DEPUTY COUNTY SURVEYOR

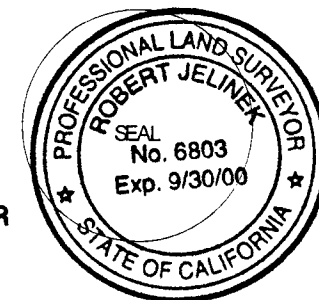

County Surveyor's Comment _____

HUNSAKER & ASSOCIATES, INC.

SEPTEMBER 16, 1998



LAND SURVEYOR: TOM R. McGANNON, R.C.E. 23956

NOTE

ALL TIE POINTS ARE
L & T TAGGED R.C.E. 23956
SET IN TOP OF CURB
UNLESS OTHERWISE NOTED.

LEGEND

● INDICATES SET 8" SPIKE &
WASHER STAMPED R.C.E. 23956
UNLESS OTHERWISE NOTED.

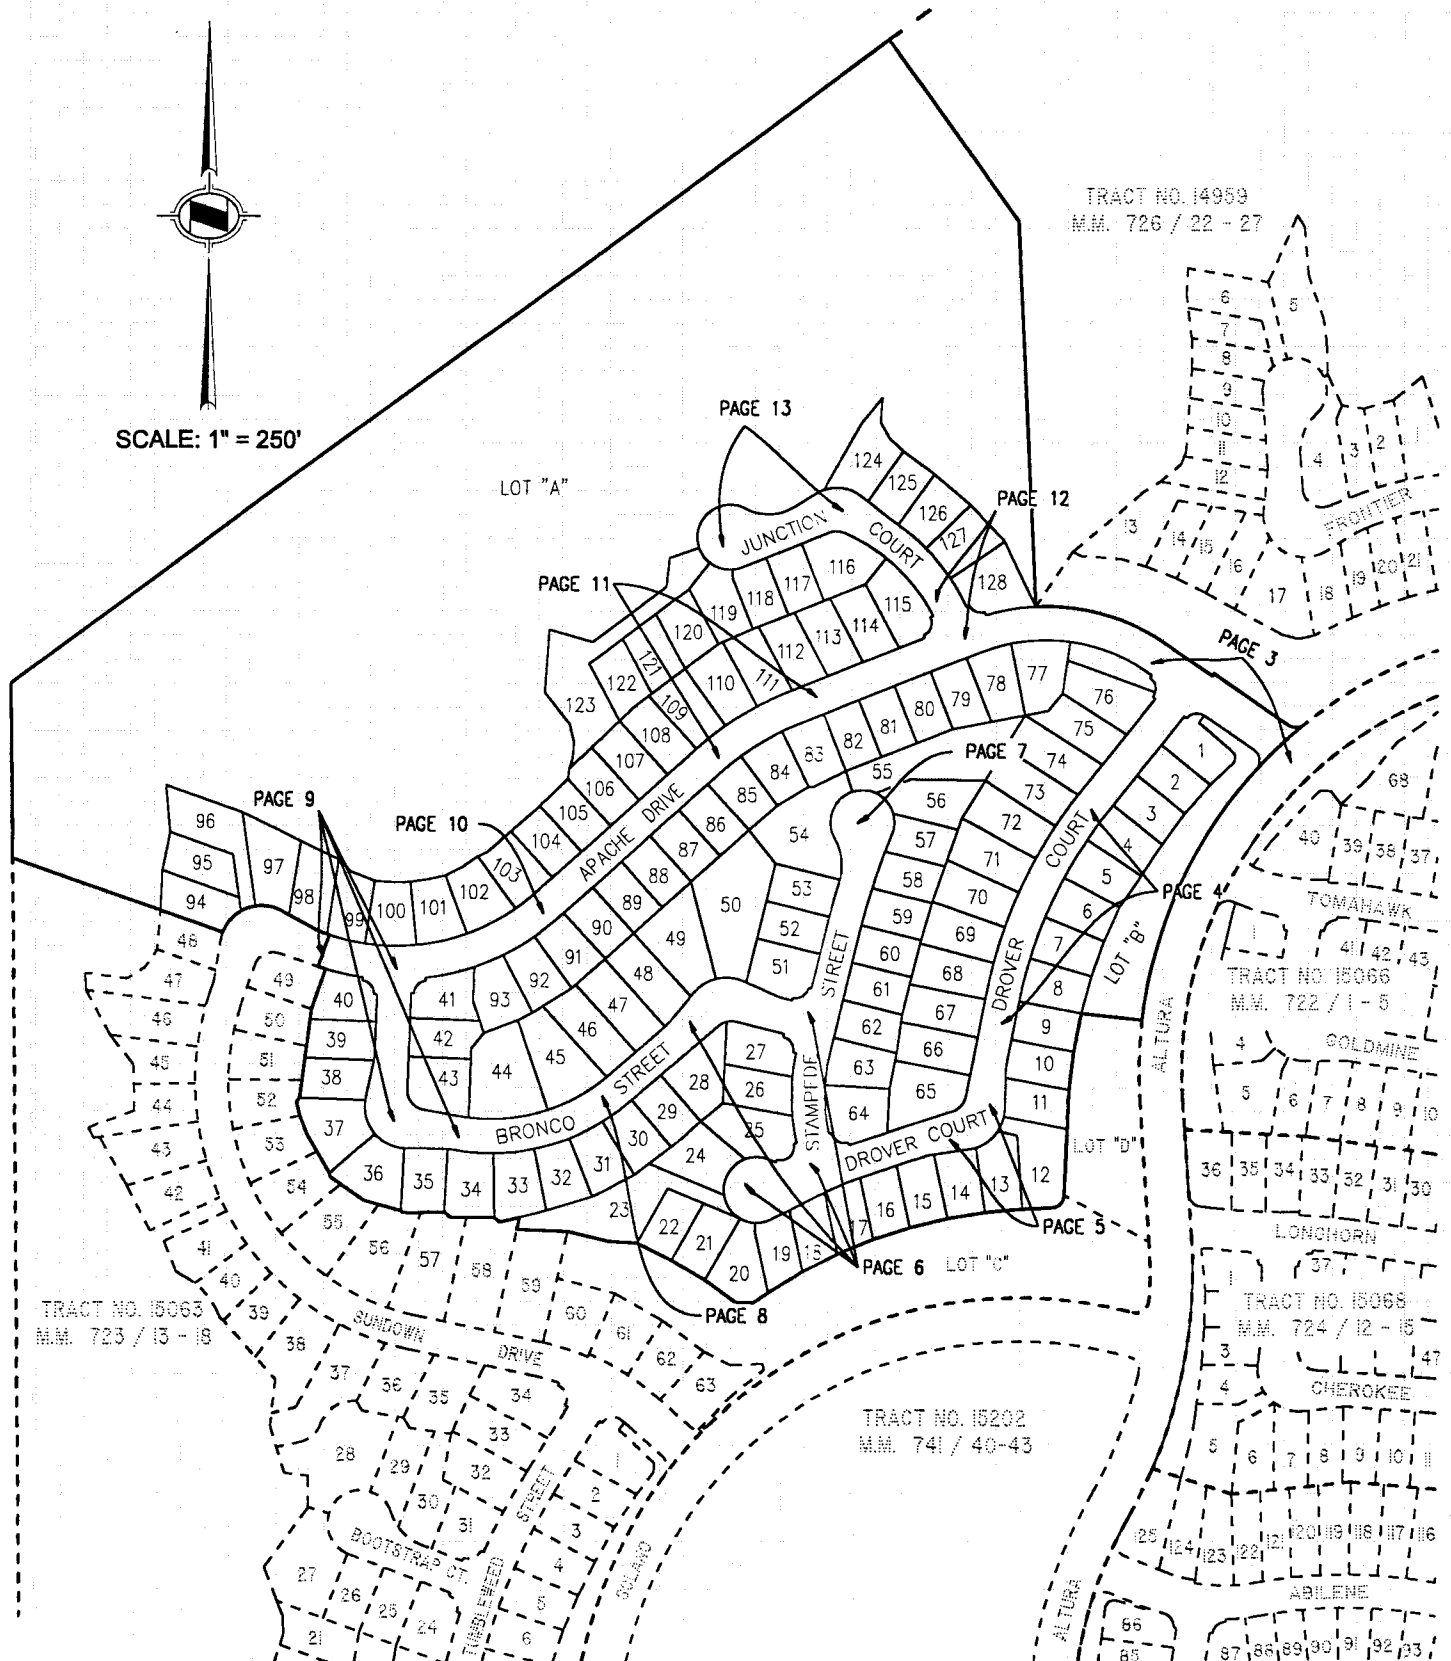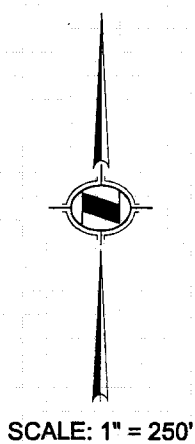

SURVEYED BY

HUNSAKER & ASSOCIATES, INC.

SEPTEMBER 16, 1998

GRANGE COUNTY SURVEYOR


NOTE

ALL TIE POINTS ARE
L & T TAGGED R.C.E. 23956
SET IN TOP OF CURB
UNLESS OTHERWISE NOTED.

LAND SURVEYOR: TOM R. McGANNON, R.C.E. 23956

LEGEND

● INDICATES SET 8" SPIKE &
WASHER STAMPED R.C.E. 23956
UNLESS OTHERWISE NOTED.

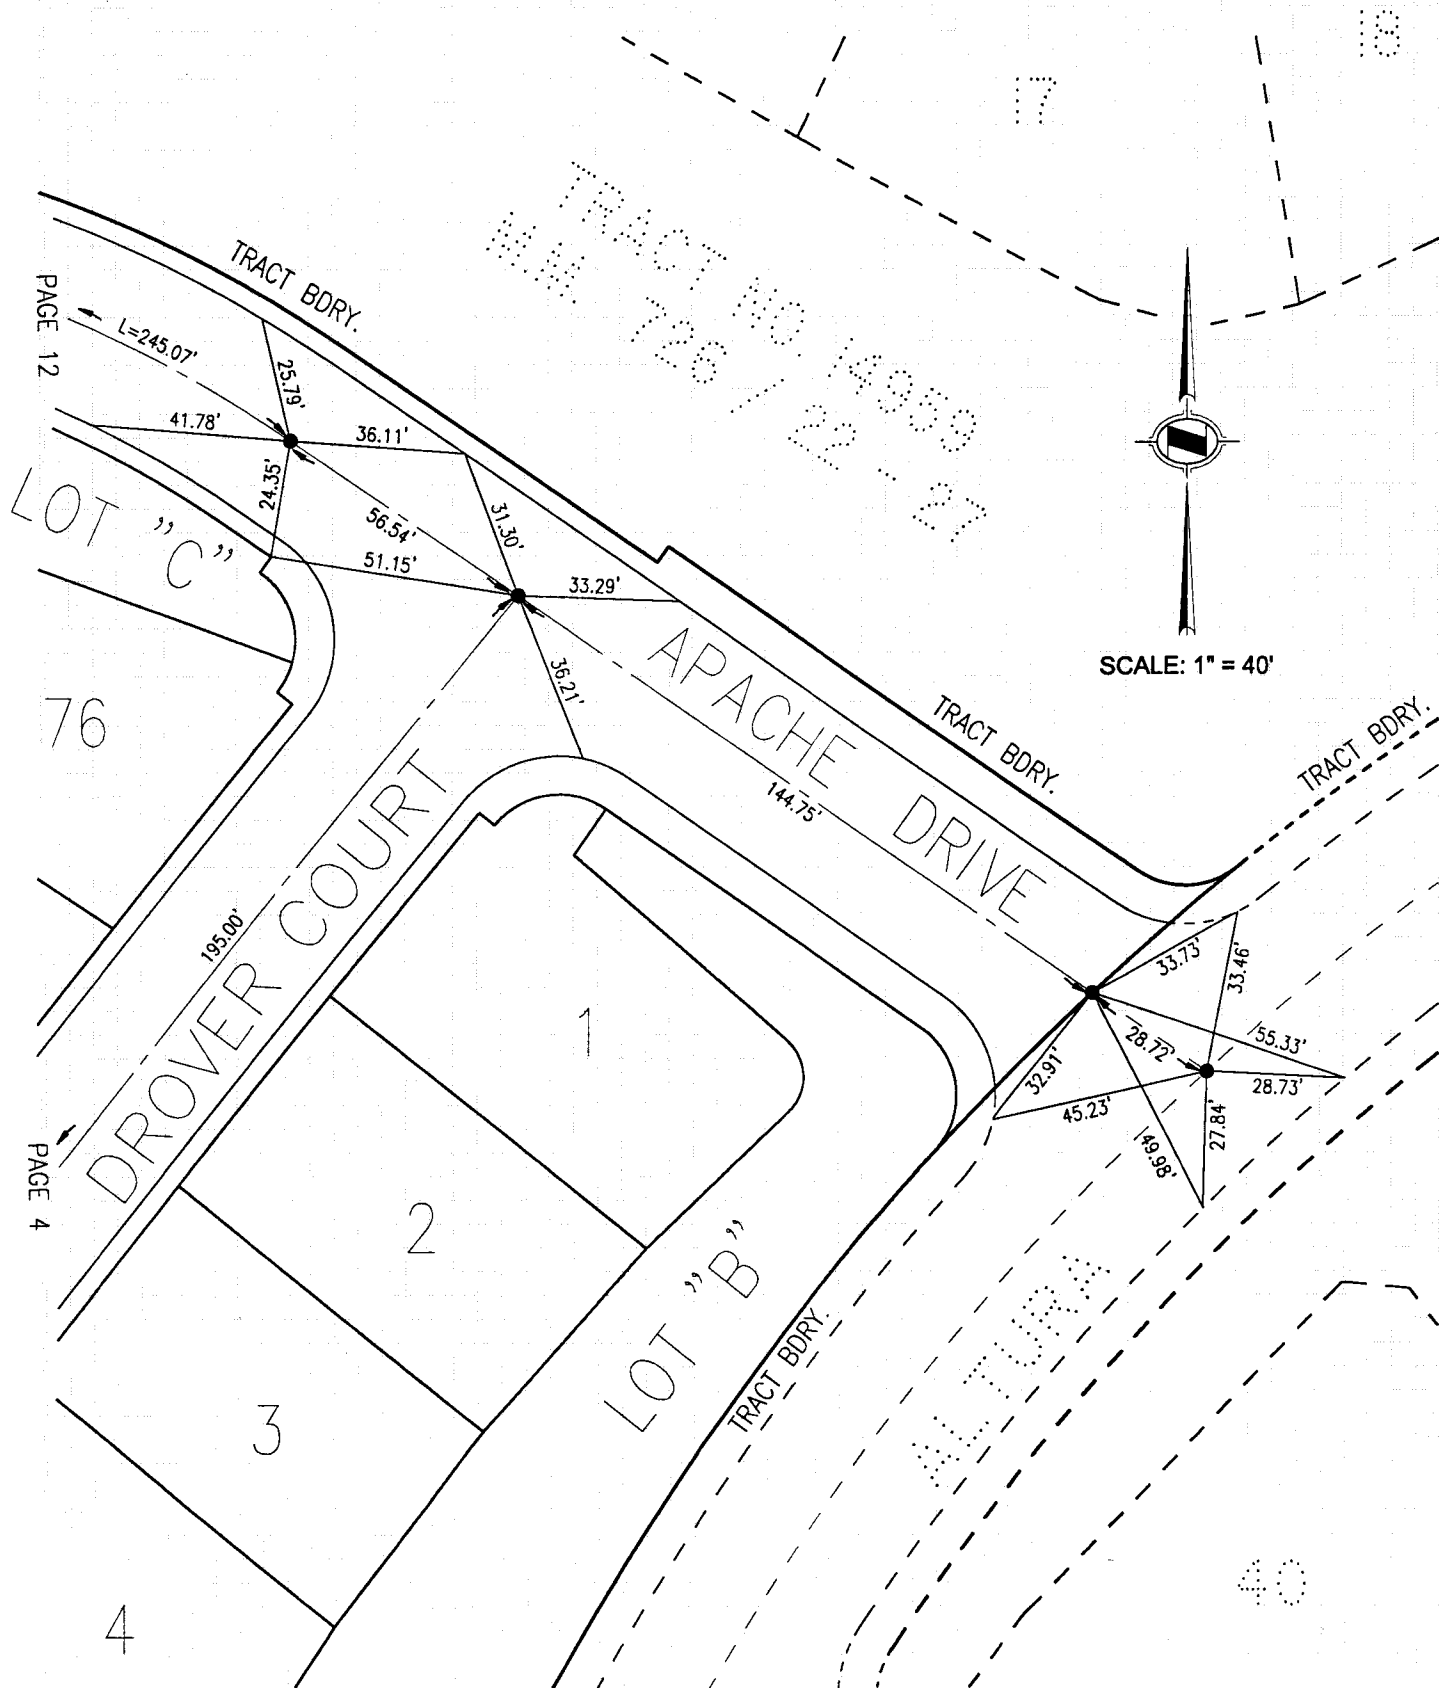


NOTE

ALL TIE POINTS ARE
L & T TAGGED R.C.E. 23956
SET IN TOP OF CURB
UNLESS OTHERWISE NOTED.

LAND SURVEYOR: TOM R. MCGANNON, R.C.E. 23956

LEGEND

● INDICATES SET 8" SPIKE &
WASHER STAMPED R.C.E. 23956
UNLESS OTHERWISE NOTED.

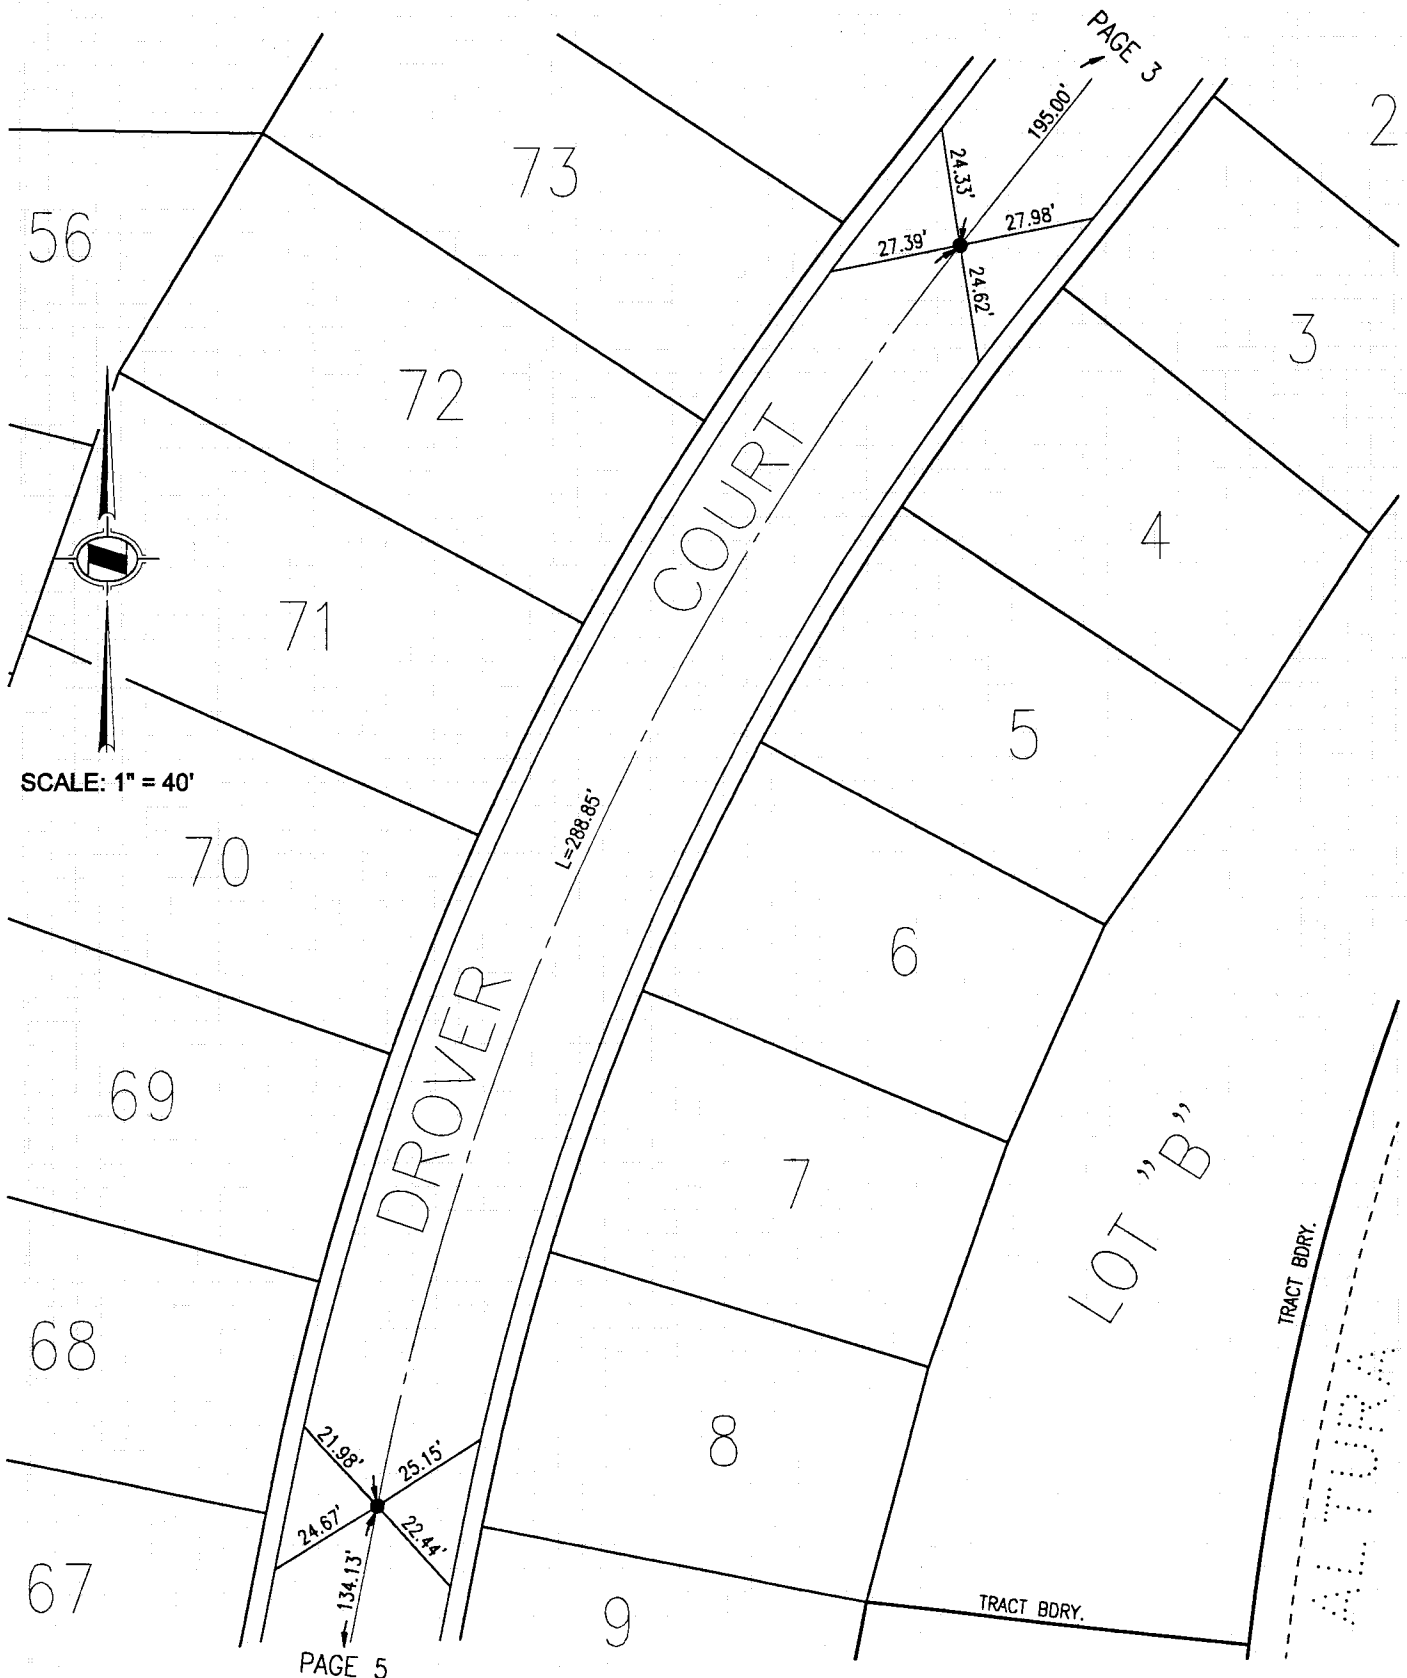

SURVEY OF

HUNSAKER & ASSOCIATES, INC.

SEPTEMBER 16, 1998


NOTE

ALL TIE POINTS ARE
L & T TAGGED R.C.E. 23956
SET IN TOP OF CURB
UNLESS OTHERWISE NOTED.

LAND SURVEYOR: TOM R. MCGANNON, R.C.E. 23956

LEGEND

● INDICATES SET 8" SPIKE &
WASHER STAMPED R.C.E. 23956
UNLESS OTHERWISE NOTED.

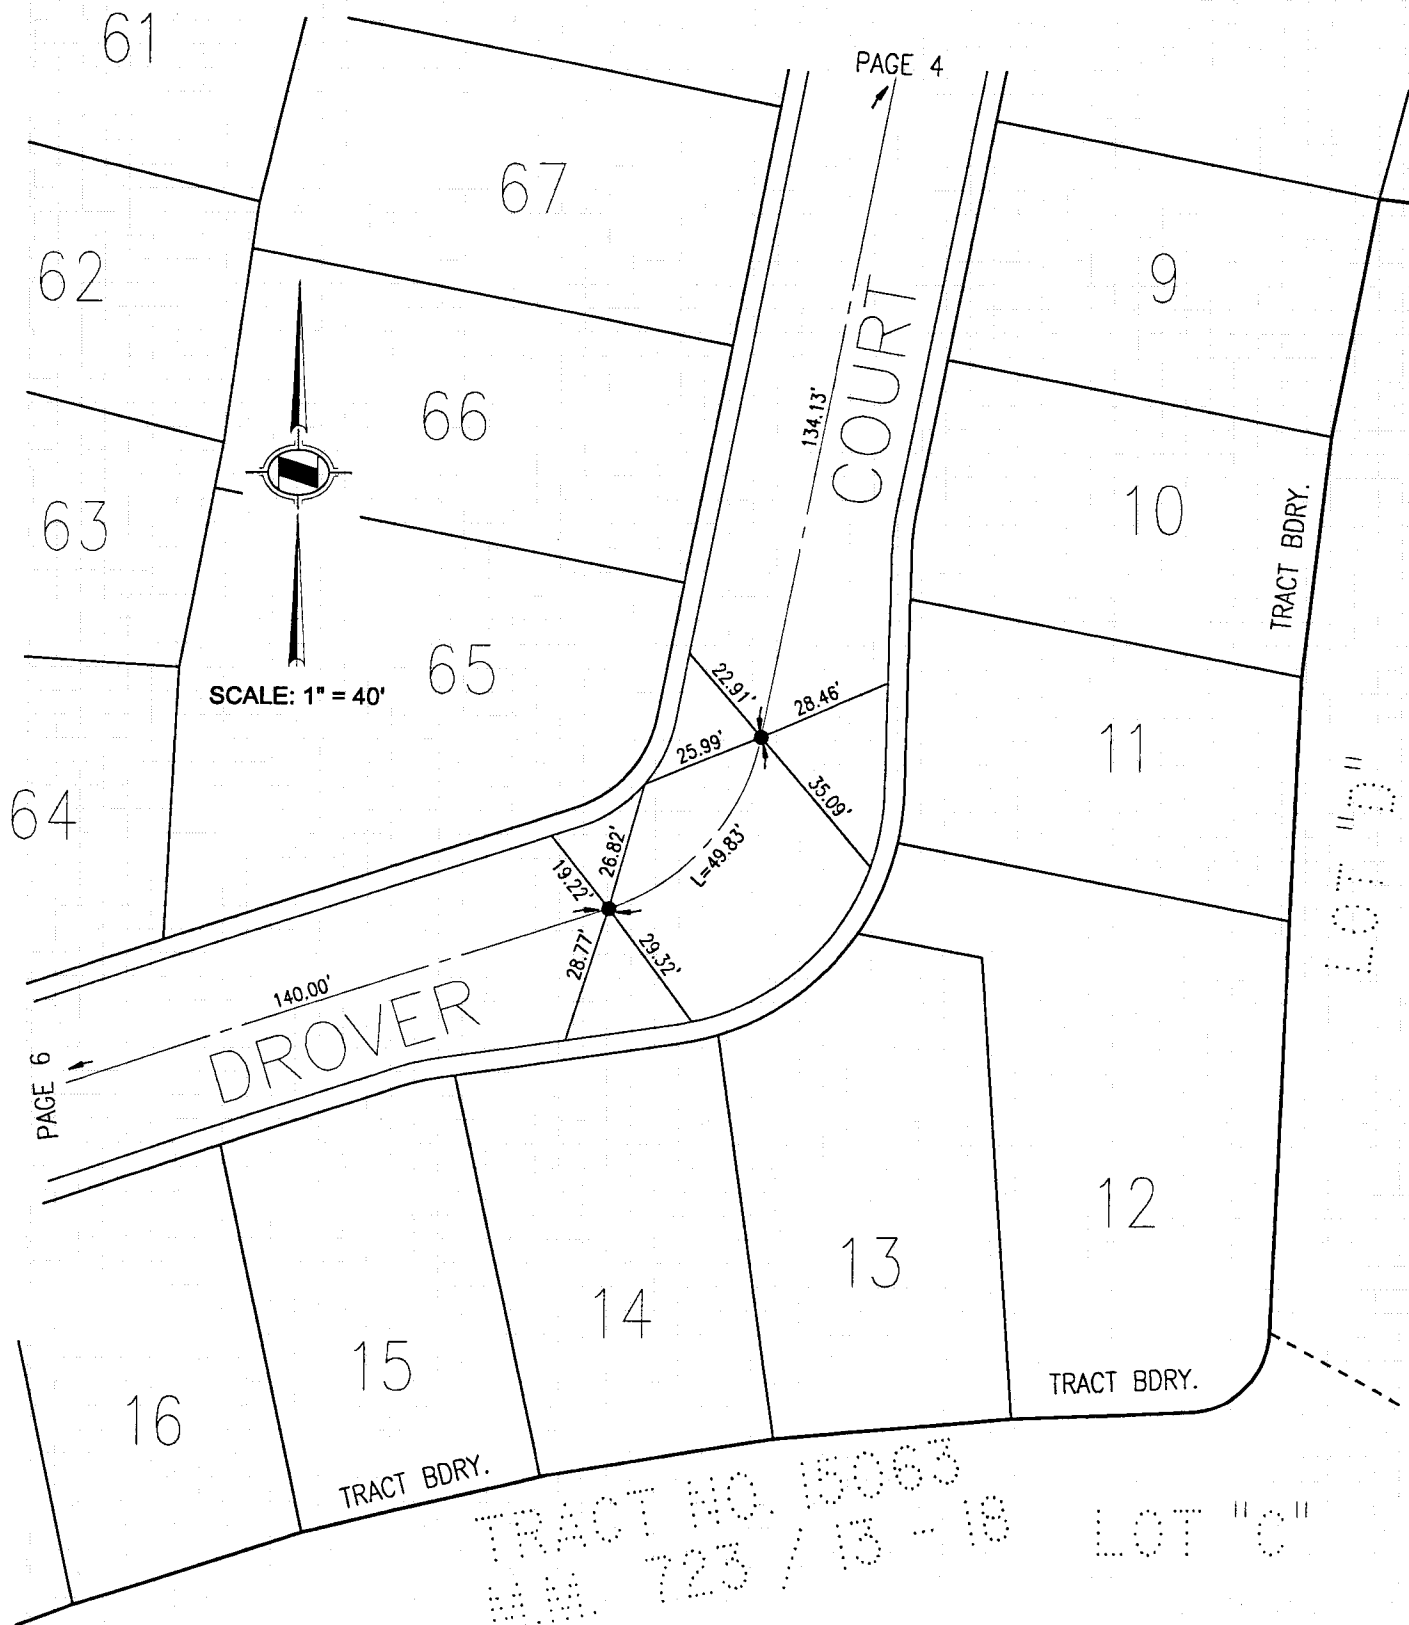

SURVEY OF

HUNSAKER & ASSOCIATES, INC.

SEPTEMBER 16, 1998


NOTE

LAND SURVEYOR: TOM R. MCGANNON, R.C.E. 23956

ALL TIE POINTS ARE
L & T TAGGED R.C.E. 23956
SET IN TOP OF CURB
UNLESS OTHERWISE NOTED.

LEGEND

● INDICATES SET 8" SPIKE &
WASHER STAMPED R.C.E. 23956
UNLESS OTHERWISE NOTED.

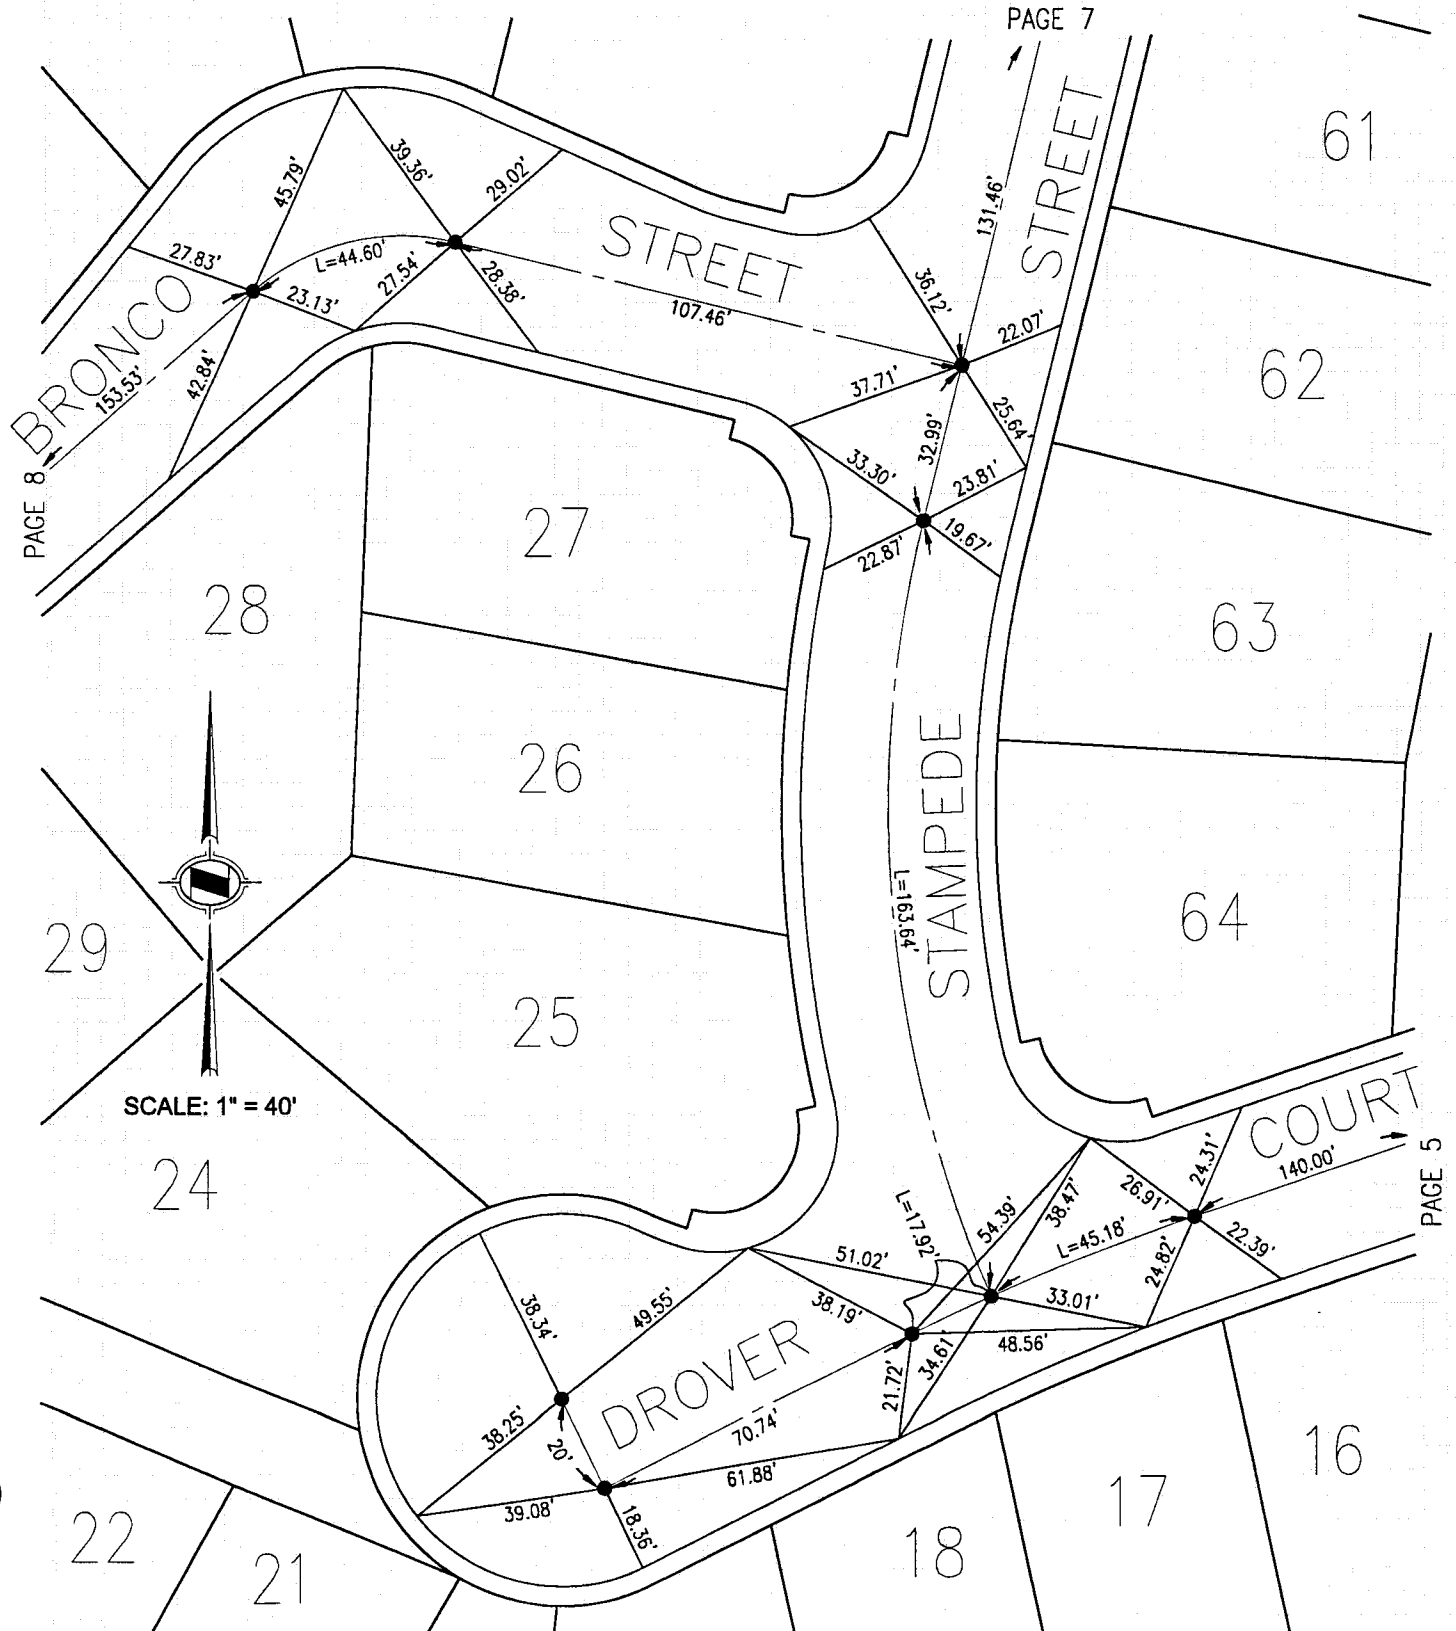

SURVEYED BY

HUNSAKER & ASSOCIATES, INC.

SEPTEMBER 16, 1998

INDEX

PAGE

NOTE


ALL TIE POINTS ARE
L & T TAGGED R.C.E. 23956
SET IN TOP OF CURB
UNLESS OTHERWISE NOTED.

LAND SURVEYOR: TOM R. MCGANNON, R.C.E. 23956

GRAPHIC SCALE SURVEYOR

LEGEND

● INDICATES SET 8" SPIKE &
WASHER STAMPED R.C.E. 23956
UNLESS OTHERWISE NOTED.

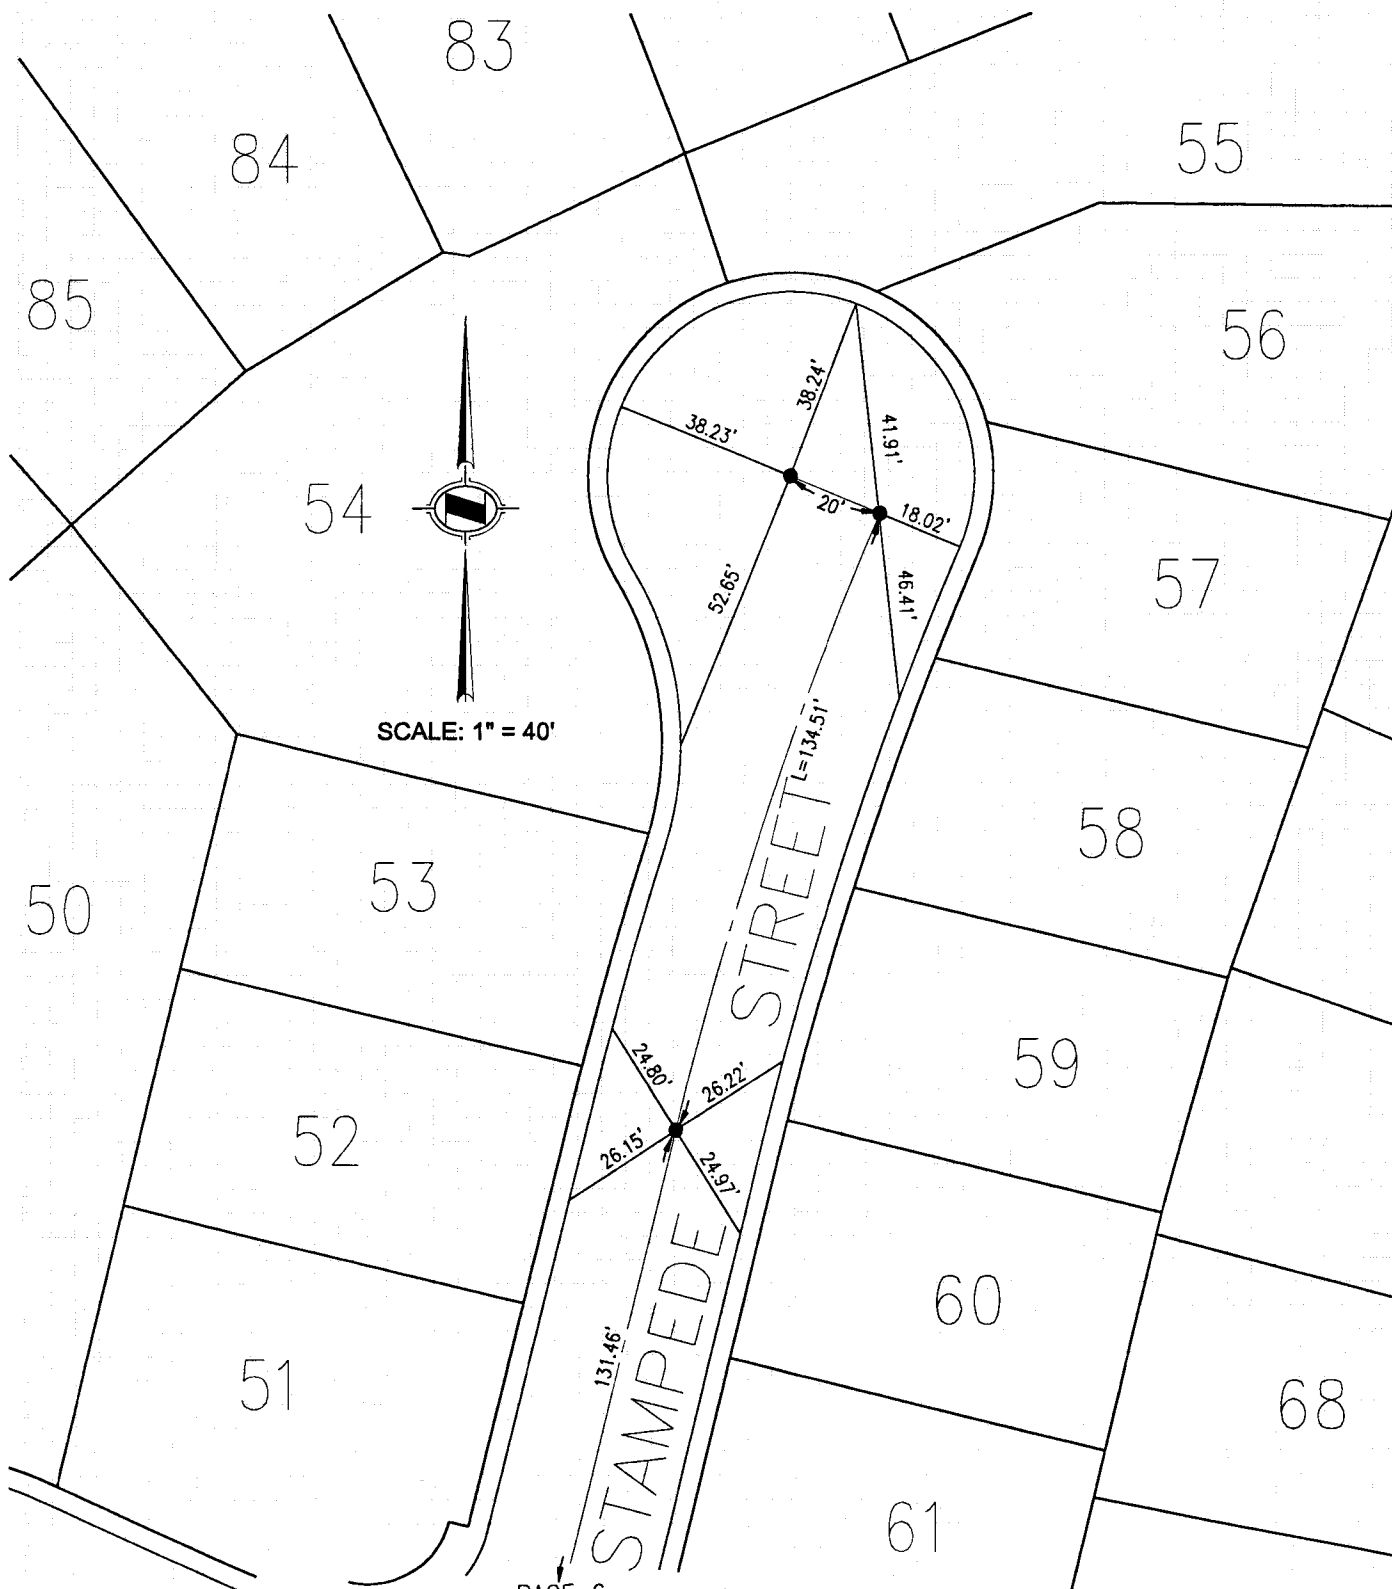

HUNSAKER & ASSOCIATES, INC.

SEPTEMBER 16, 1998

LAND SURVEYOR: TOM R. McGANNON, R.C.E. 23956


NOTE

ALL TIE POINTS ARE
L & T TAGGED R.C.E. 23956
SET IN TOP OF CURB
UNLESS OTHERWISE NOTED.

LEGEND

● INDICATES SET 8" SPIKE &
WASHER STAMPED R.C.E. 23956
UNLESS OTHERWISE NOTED.

■ INDICATES SPIKE & WASHER
SET PER TRACT 15063

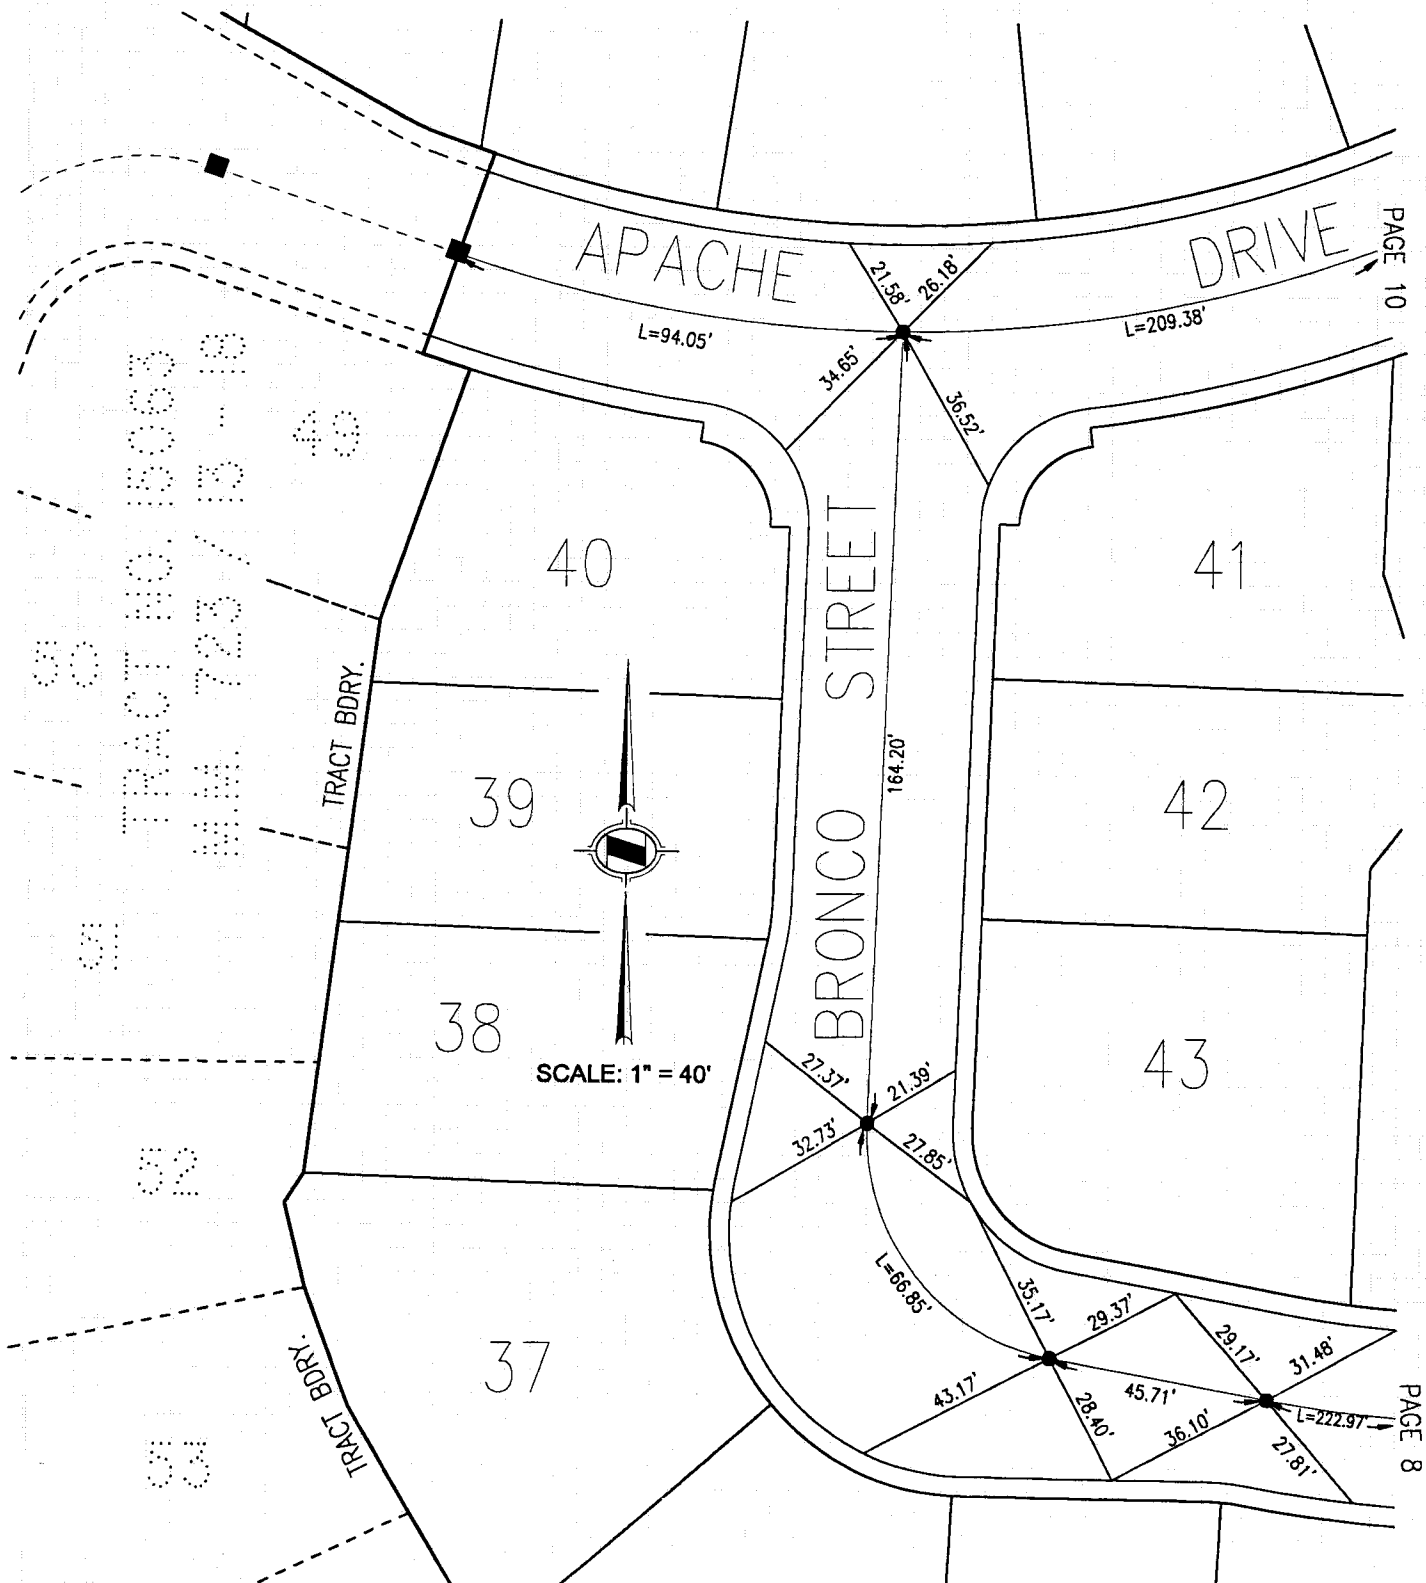

HUNSAKER & ASSOCIATES, INC.

SEPTEMBER 16, 1998

ORANGE COUNTY SURVEYOR

SURVEYED BY


LAND SURVEYOR: TOM R. McGANNON, R.C.E. 23956

NOTE

ALL TIE POINTS ARE
L & T TAGGED R.C.E. 23956
SET IN TOP OF CURB
UNLESS OTHERWISE NOTED.

LEGEND

● INDICATES SET 8" SPIKE &
WASHER STAMPED R.C.E. 23956
UNLESS OTHERWISE NOTED.

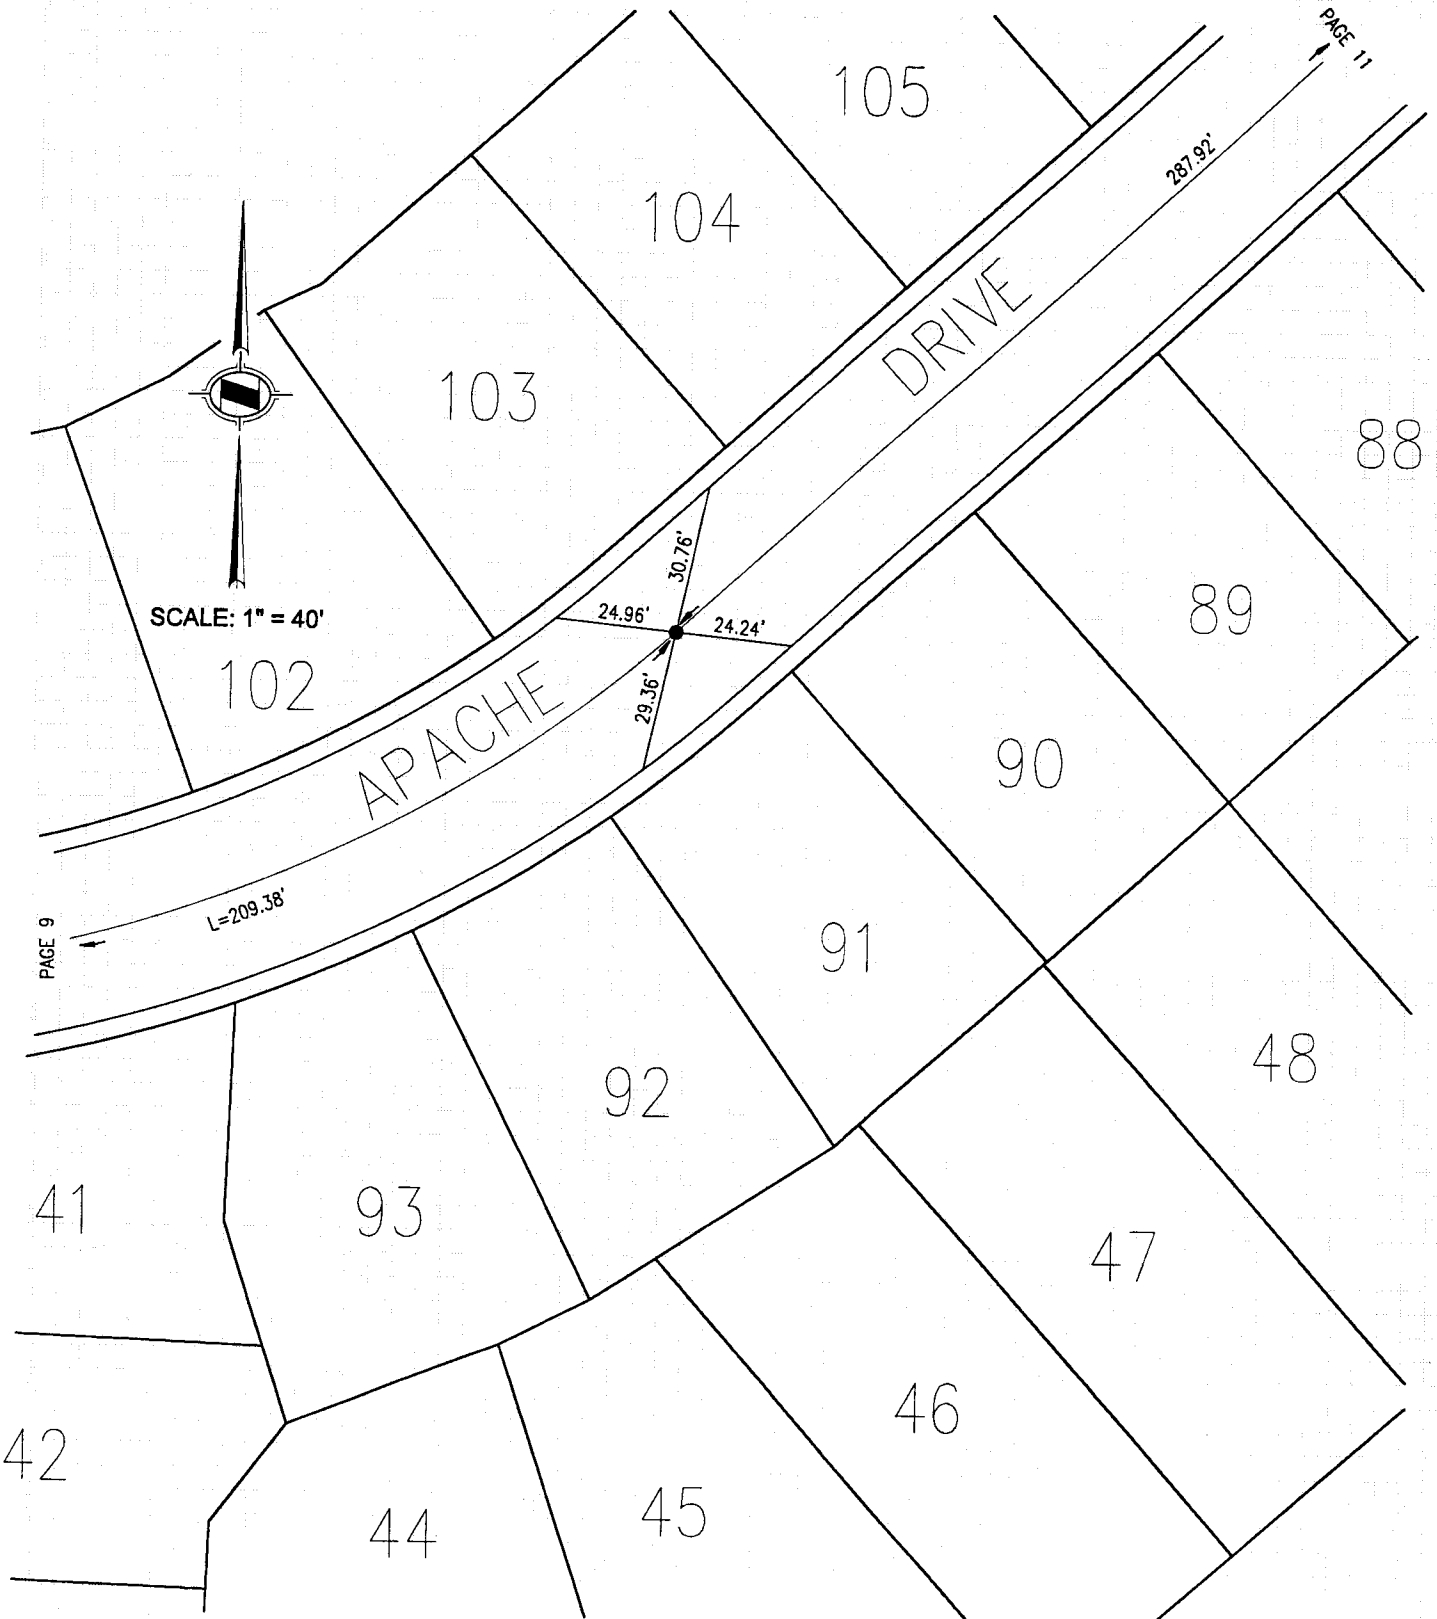


NOTE

ALL TIE POINTS ARE
L & T TAGGED R.C.E. 23956
SET IN TOP OF CURB
UNLESS OTHERWISE NOTED.

LAND SURVEYOR: TOM R. McGANNON, R.C.E. 23956

LEGEND

● INDICATES SET 8" SPIKE &
WASHER STAMPED R.C.E. 23956
UNLESS OTHERWISE NOTED.

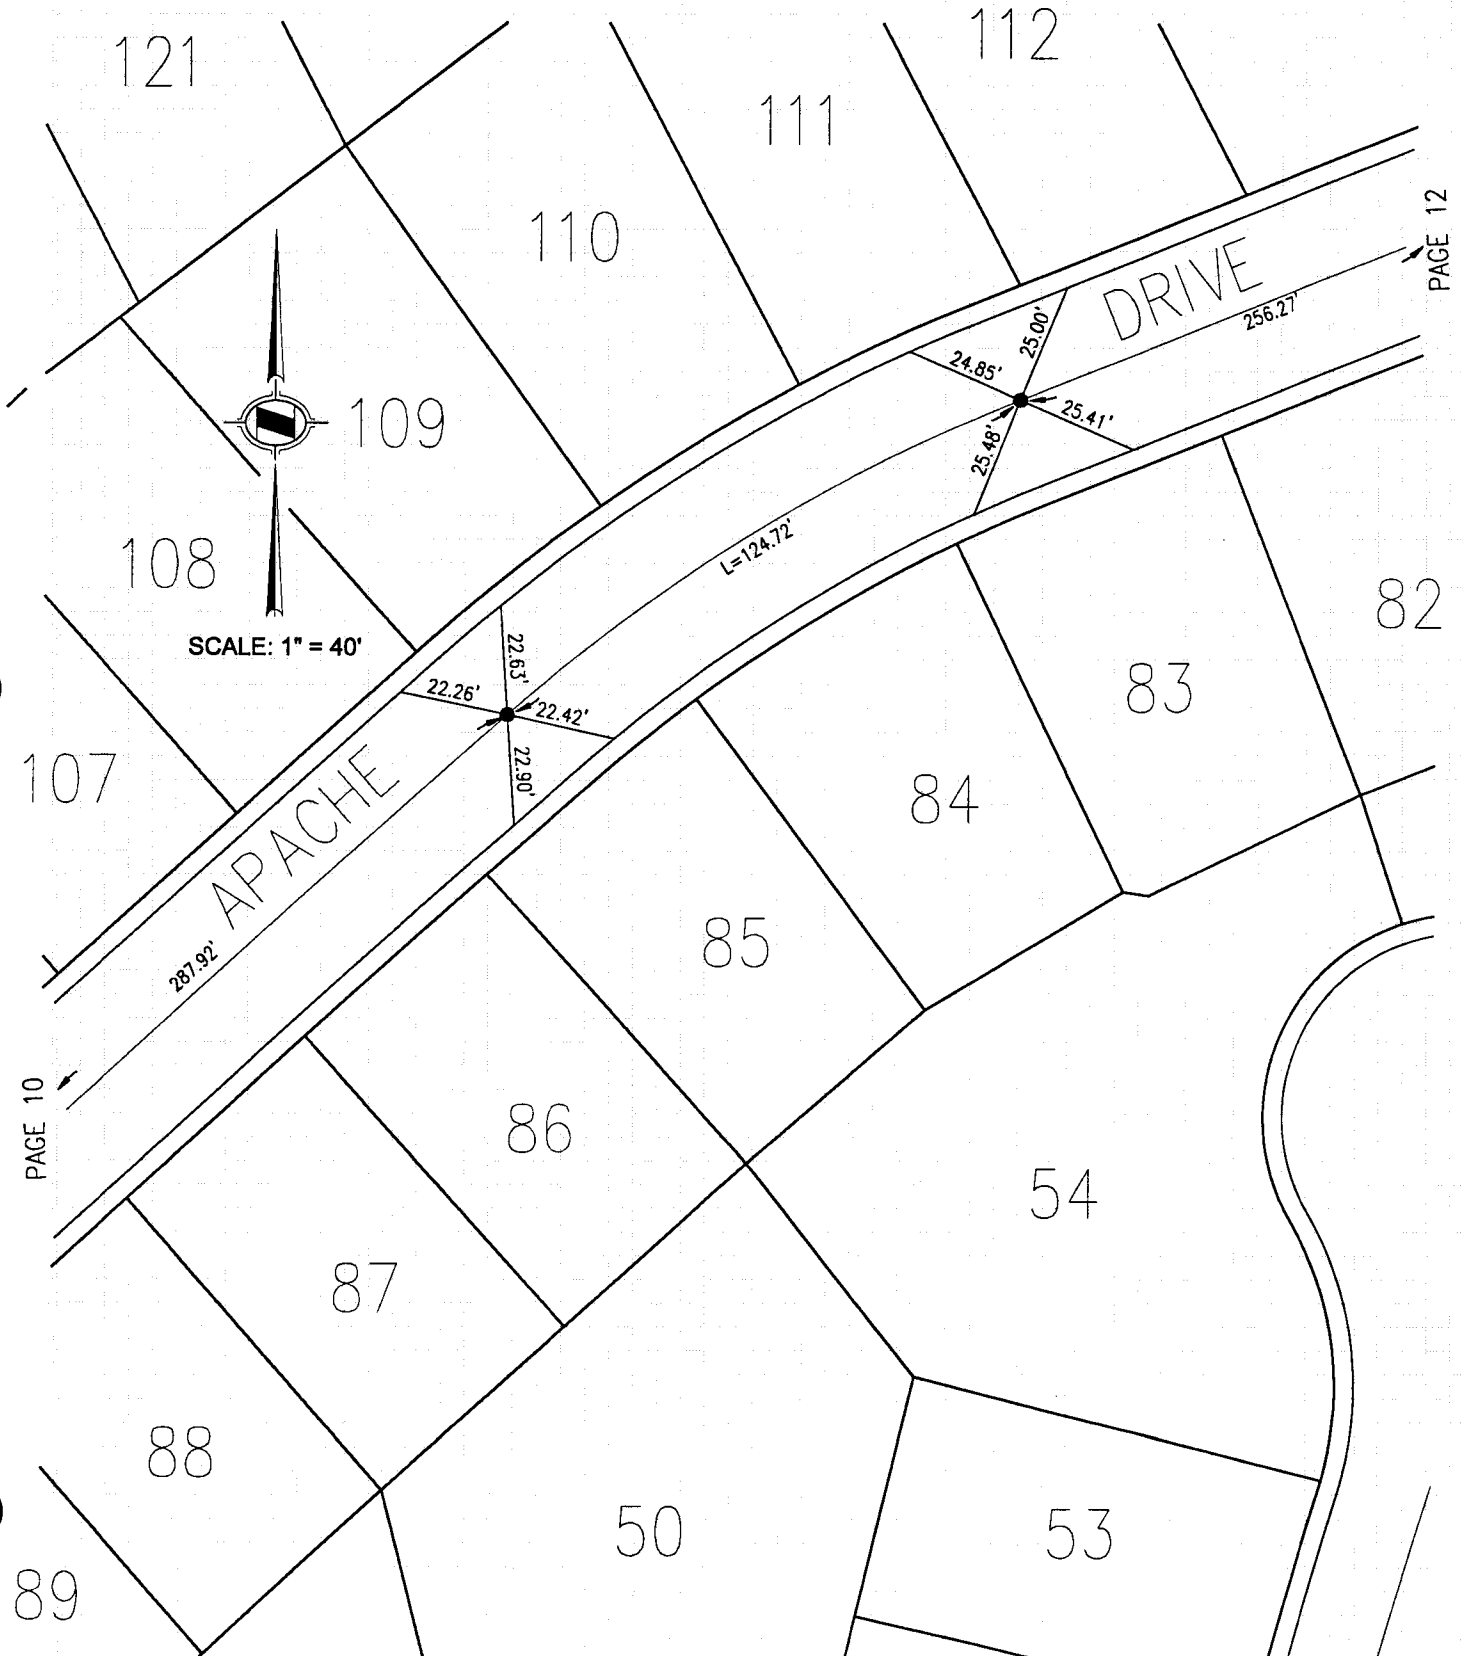

SURVEY OF

INDEX

PAGE 2

HUNSAKER & ASSOCIATES, INC.

SEPTEMBER 16, 1998


NOTE

ALL TIE POINTS ARE
L & T TAGGED R.C.E. 23956
SET IN TOP OF CURB
UNLESS OTHERWISE NOTED.

LAND SURVEYOR: TOM R. McGANNON, R.C.E. 23956

LEGEND

● INDICATES SET 8" SPIKE &
WASHER STAMPED R.C.E. 23956
UNLESS OTHERWISE NOTED.

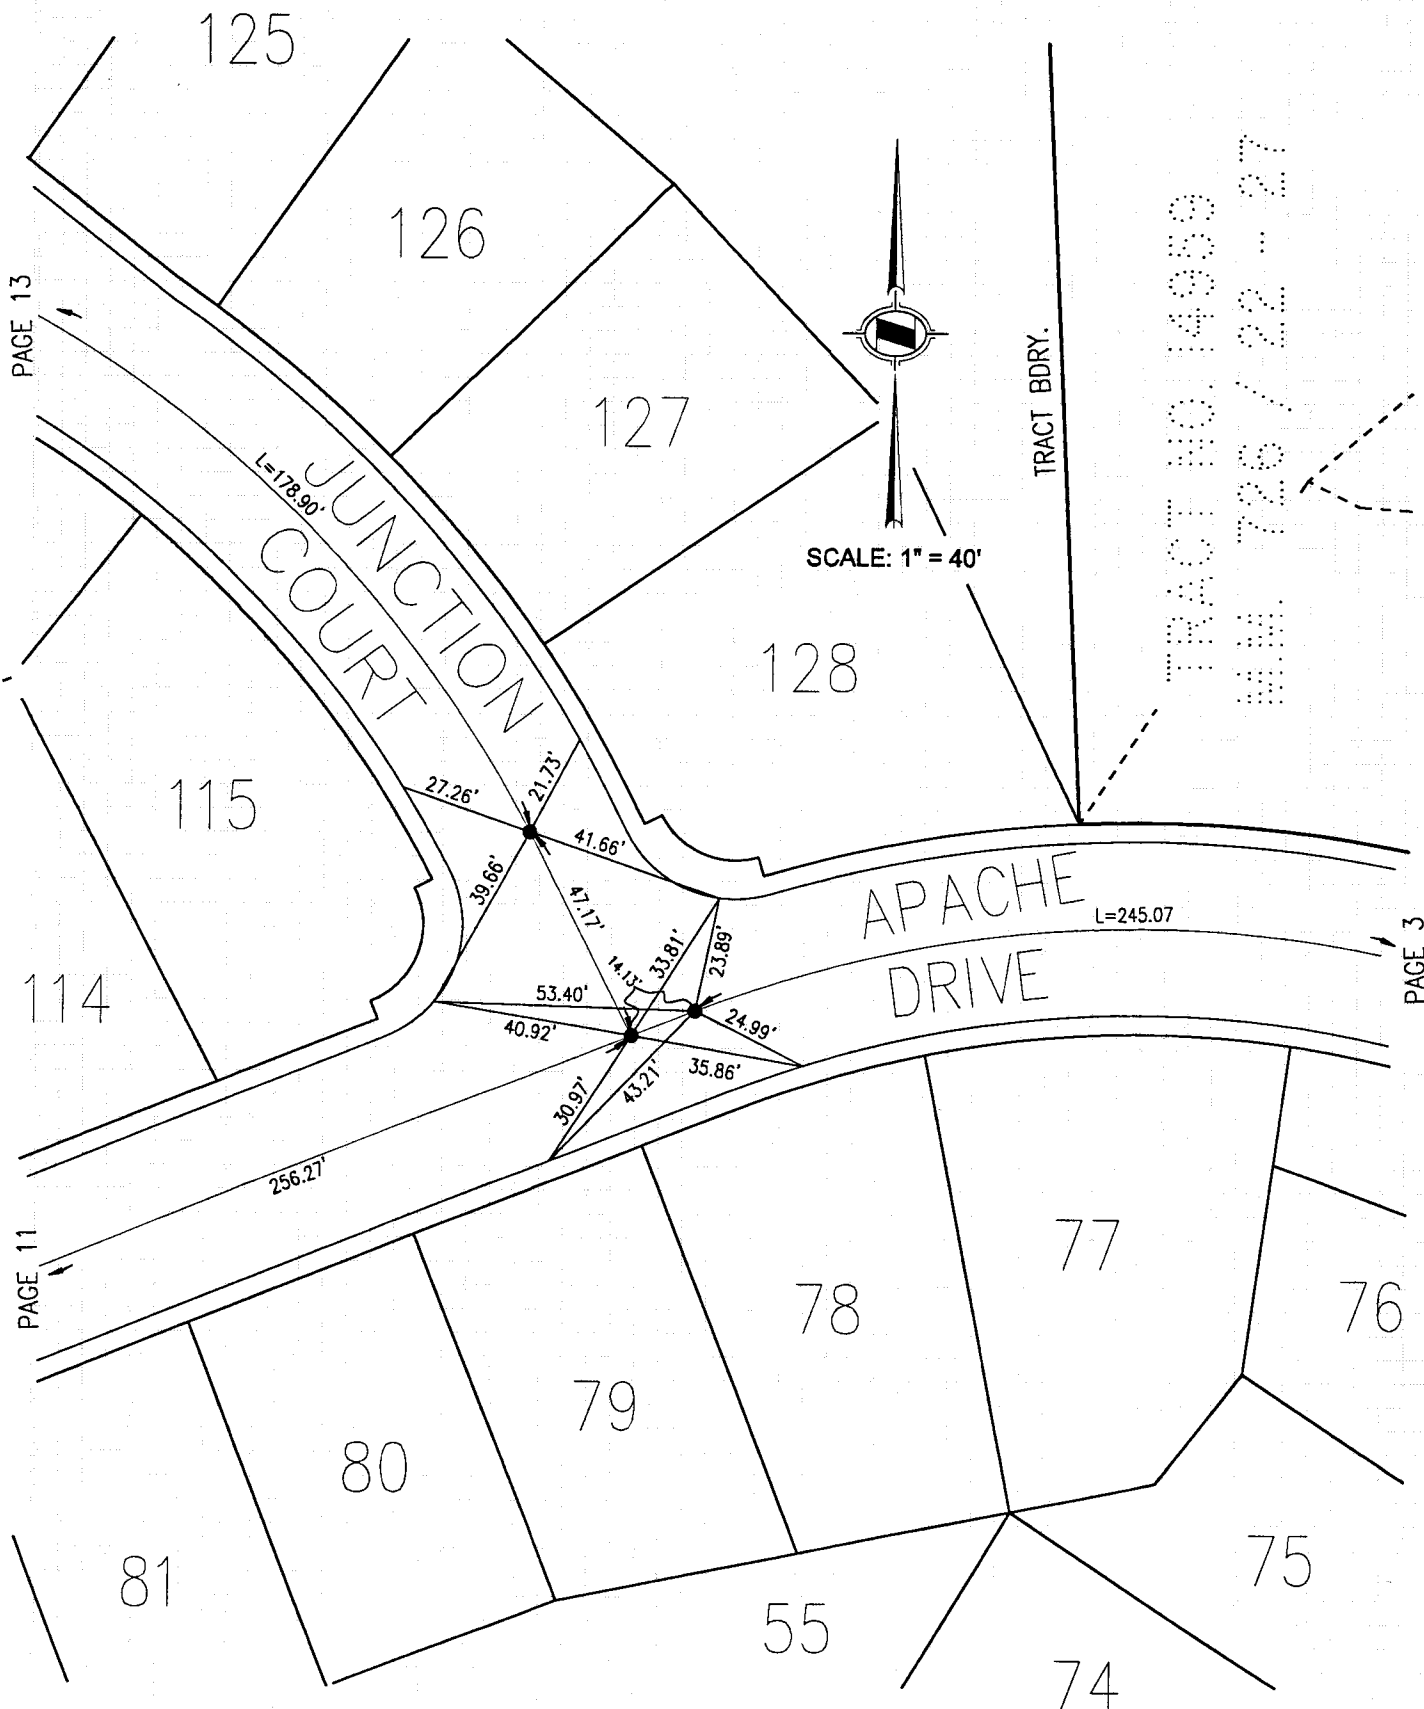

HUNSAKER & ASSOCIATES, INC.

SEPTEMBER 16, 1998


LAND SURVEYOR: TOM R. MCGANNON, R.C.E. 23956

NOTE

ALL TIE POINTS ARE
L & T TAGGED R.C.E. 23956
SET IN TOP OF CURB
UNLESS OTHERWISE NOTED.

LEGEND

● INDICATES SET 8" SPIKE &
WASHER STAMPED R.C.E. 23956
UNLESS OTHERWISE NOTED.

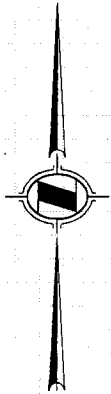

SCALE: 1" = 40'

