


CORNER RECORD

Block: 5259, Module: 10, 11, 20, 21
 City of UNINCORPORATED Document Number 98-464
 County of ORANGE, California
 Brief Legal Description TIES FOR 15066

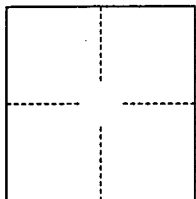

CORNER TYPE

Government Corner ☐ Control ☐
 Meander ☐ Property ☒
 Rancho ☐ Other ☐
 Date of Survey MARCH 31, 1998

COORDINATES (Optional)

N. _____
 E. _____
 Zone _____ Datum _____
 Elev. _____

Corner — Left as found ☐ Found and tagged ☐ Established ☒ Reestablished ☐ Rebuilt ☐

Identification and type of corner found: Evidence used to identify or procedure used to establish or reestablish the corner:

SET SPIKE AND WASHER, R.C.E. 23956 AT THE CENTERLINE OF THE STREETS IN THIS TRACT ON
ALTURA, TOMAHAWK STREET, GOLDMINE STREET AND DUSTY TRAIL.

A description of the physical condition of the monument as found and as set or reset: _____

SURVEYOR'S STATEMENT

This Corner Record was prepared by me or under my direction in conformance with the
 Land Surveyors' Act on NOVEMBER 3RD, 1998.


Signed Tom R. McGannon L.S. or R.C.E. Number 23956



COUNTY SURVEYOR'S STATEMENT

This Corner Record was received Dec. 23 1998 and examined
 and filed January 5th, 1999

Signed Robert Jelinek Title DEPUTY COUNTY SURVEYOR

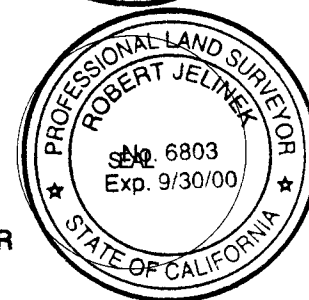

County Surveyor's Comment _____

HUNSAKER & ASSOCIATES, INC.

MARCH 31, 1998

ORANGE COUNTY SURVEYOR

SURVEYED BY


LAND SURVEYOR: TOM R. McGANNON, R.C.E. 23956

NOTE

ALL TIE POINTS ARE
L & T TAGGED R.C.E. 23956
SET IN TOP OF CURB
UNLESS OTHERWISE NOTED.

LEGEND

● INDICATES SET 8" SPIKE &
WASHER STAMPED R.C.E. 23956
UNLESS OTHERWISE NOTED.

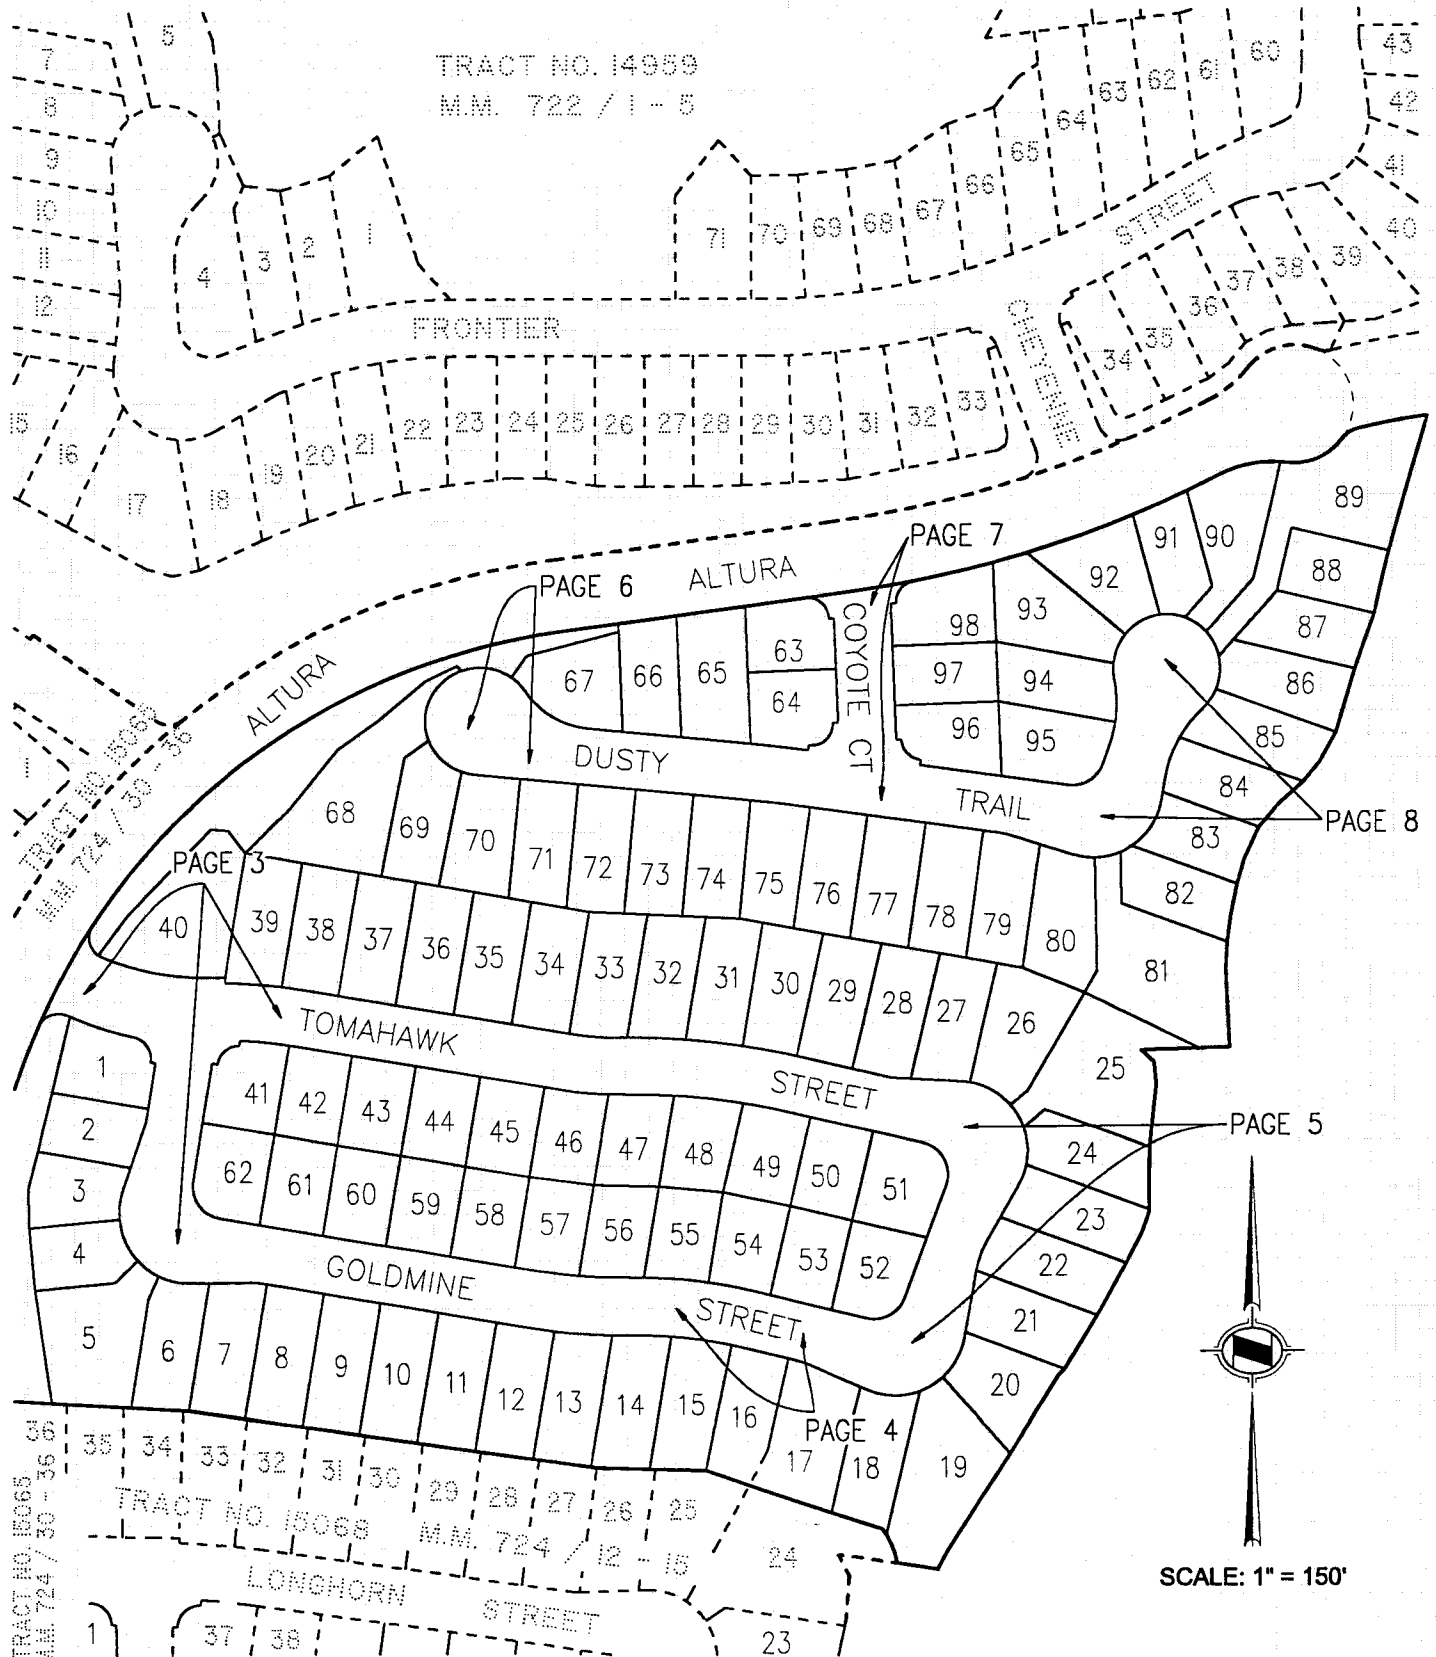

HUNSAKER & ASSOCIATES, INC.

MARCH 31, 1998


LAND SURVEYOR: TOM R. MCGANNON, R.C.E. 23956

NOTE

ALL TIE POINTS ARE
L & T TAGGED R.C.E. 23956
SET IN TOP OF CURB
UNLESS OTHERWISE NOTED.

LEGEND

● INDICATES SET 8" SPIKE &
WASHER STAMPED R.C.E. 23956
UNLESS OTHERWISE NOTED.

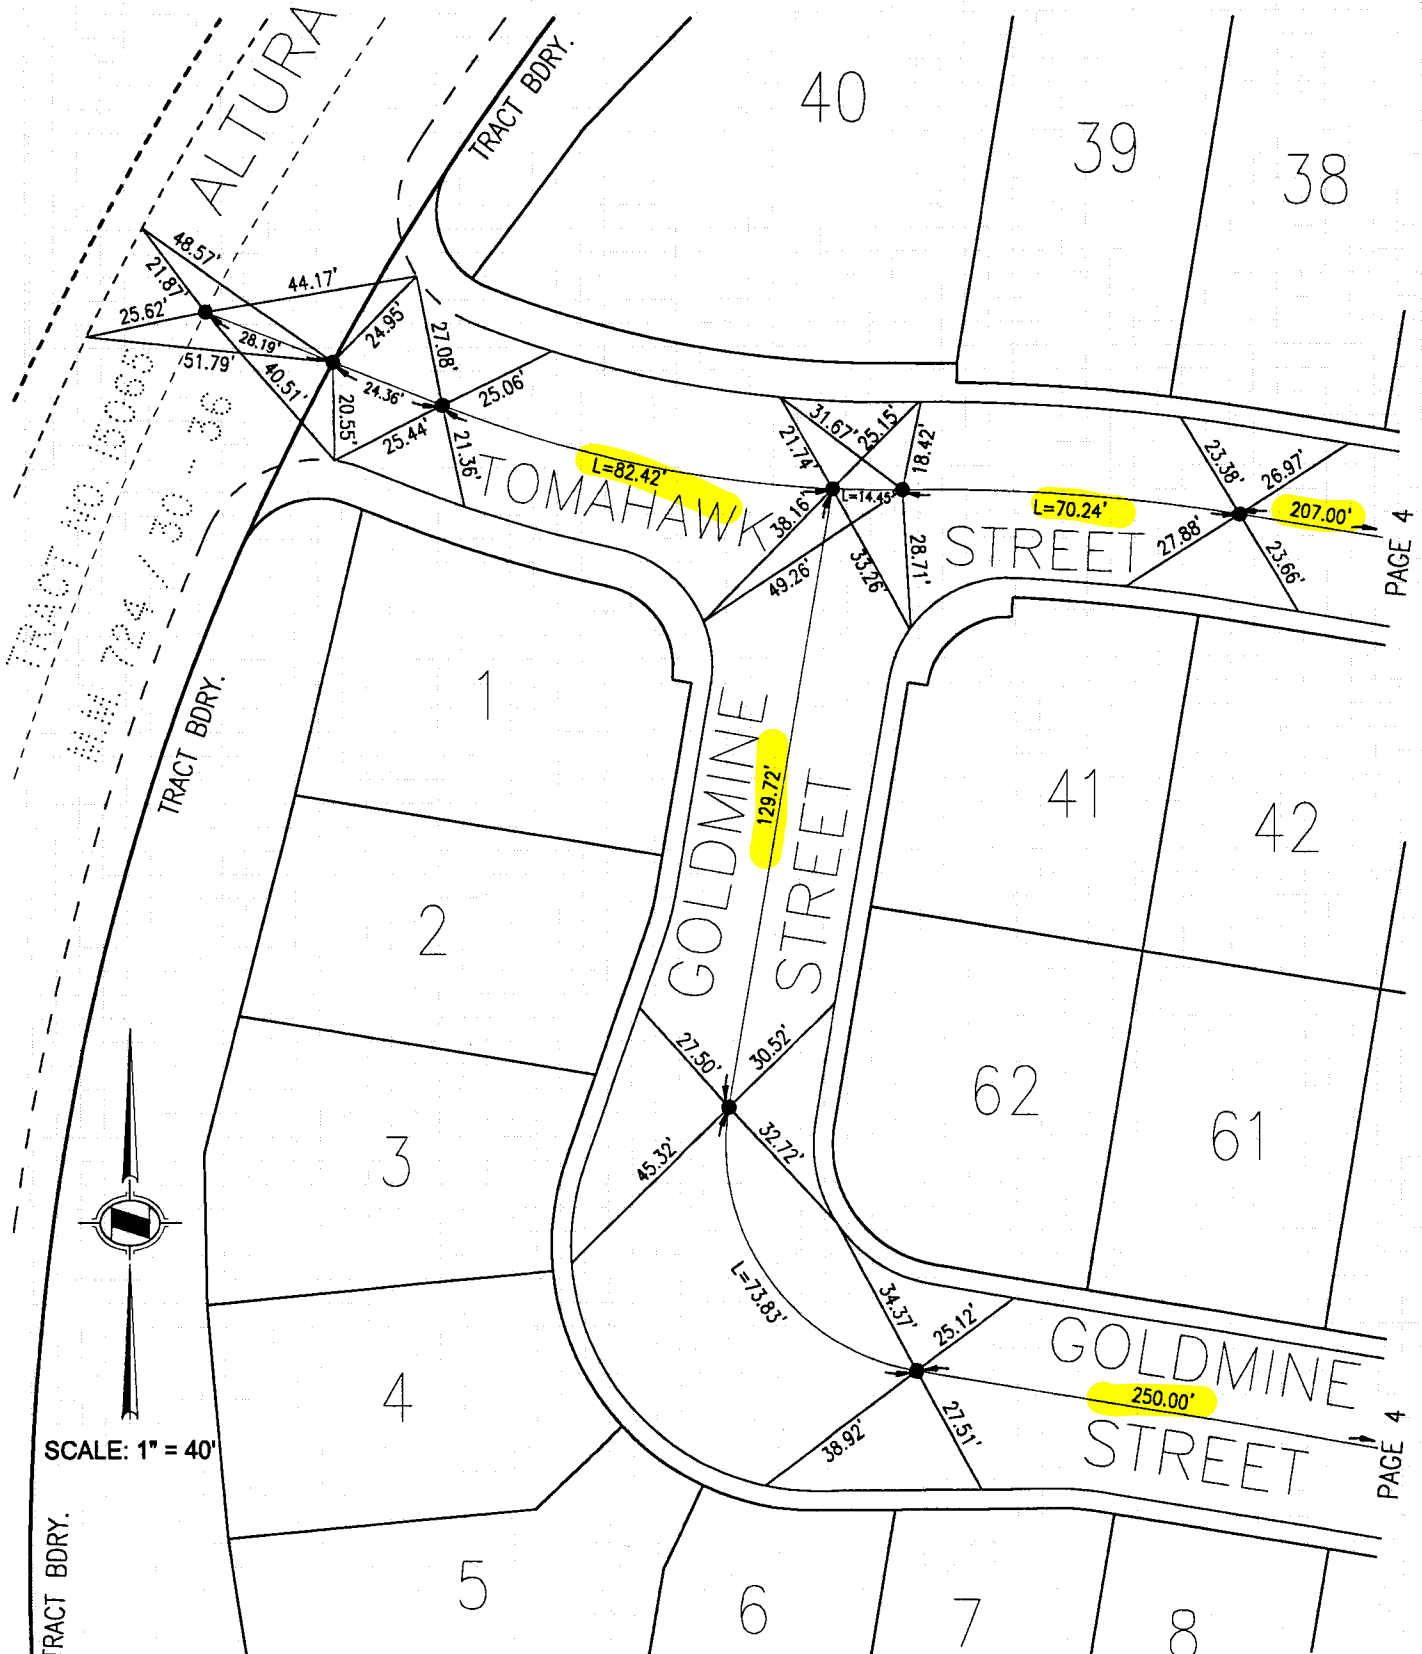

SURVEYED BY

HUNSAKER & ASSOCIATES, INC.

MARCH 31, 1998

PAGE


NOTE

ALL TIE POINTS ARE
L & T TAGGED R.C.E. 23956
SET IN TOP OF CURB
UNLESS OTHERWISE NOTED.

LAND SURVEYOR: TOM R. MCGANNON, R.C.E. 23956

LEGEND

● INDICATES SET 8" SPIKE &
WASHER STAMPED R.C.E. 23956
UNLESS OTHERWISE NOTED.

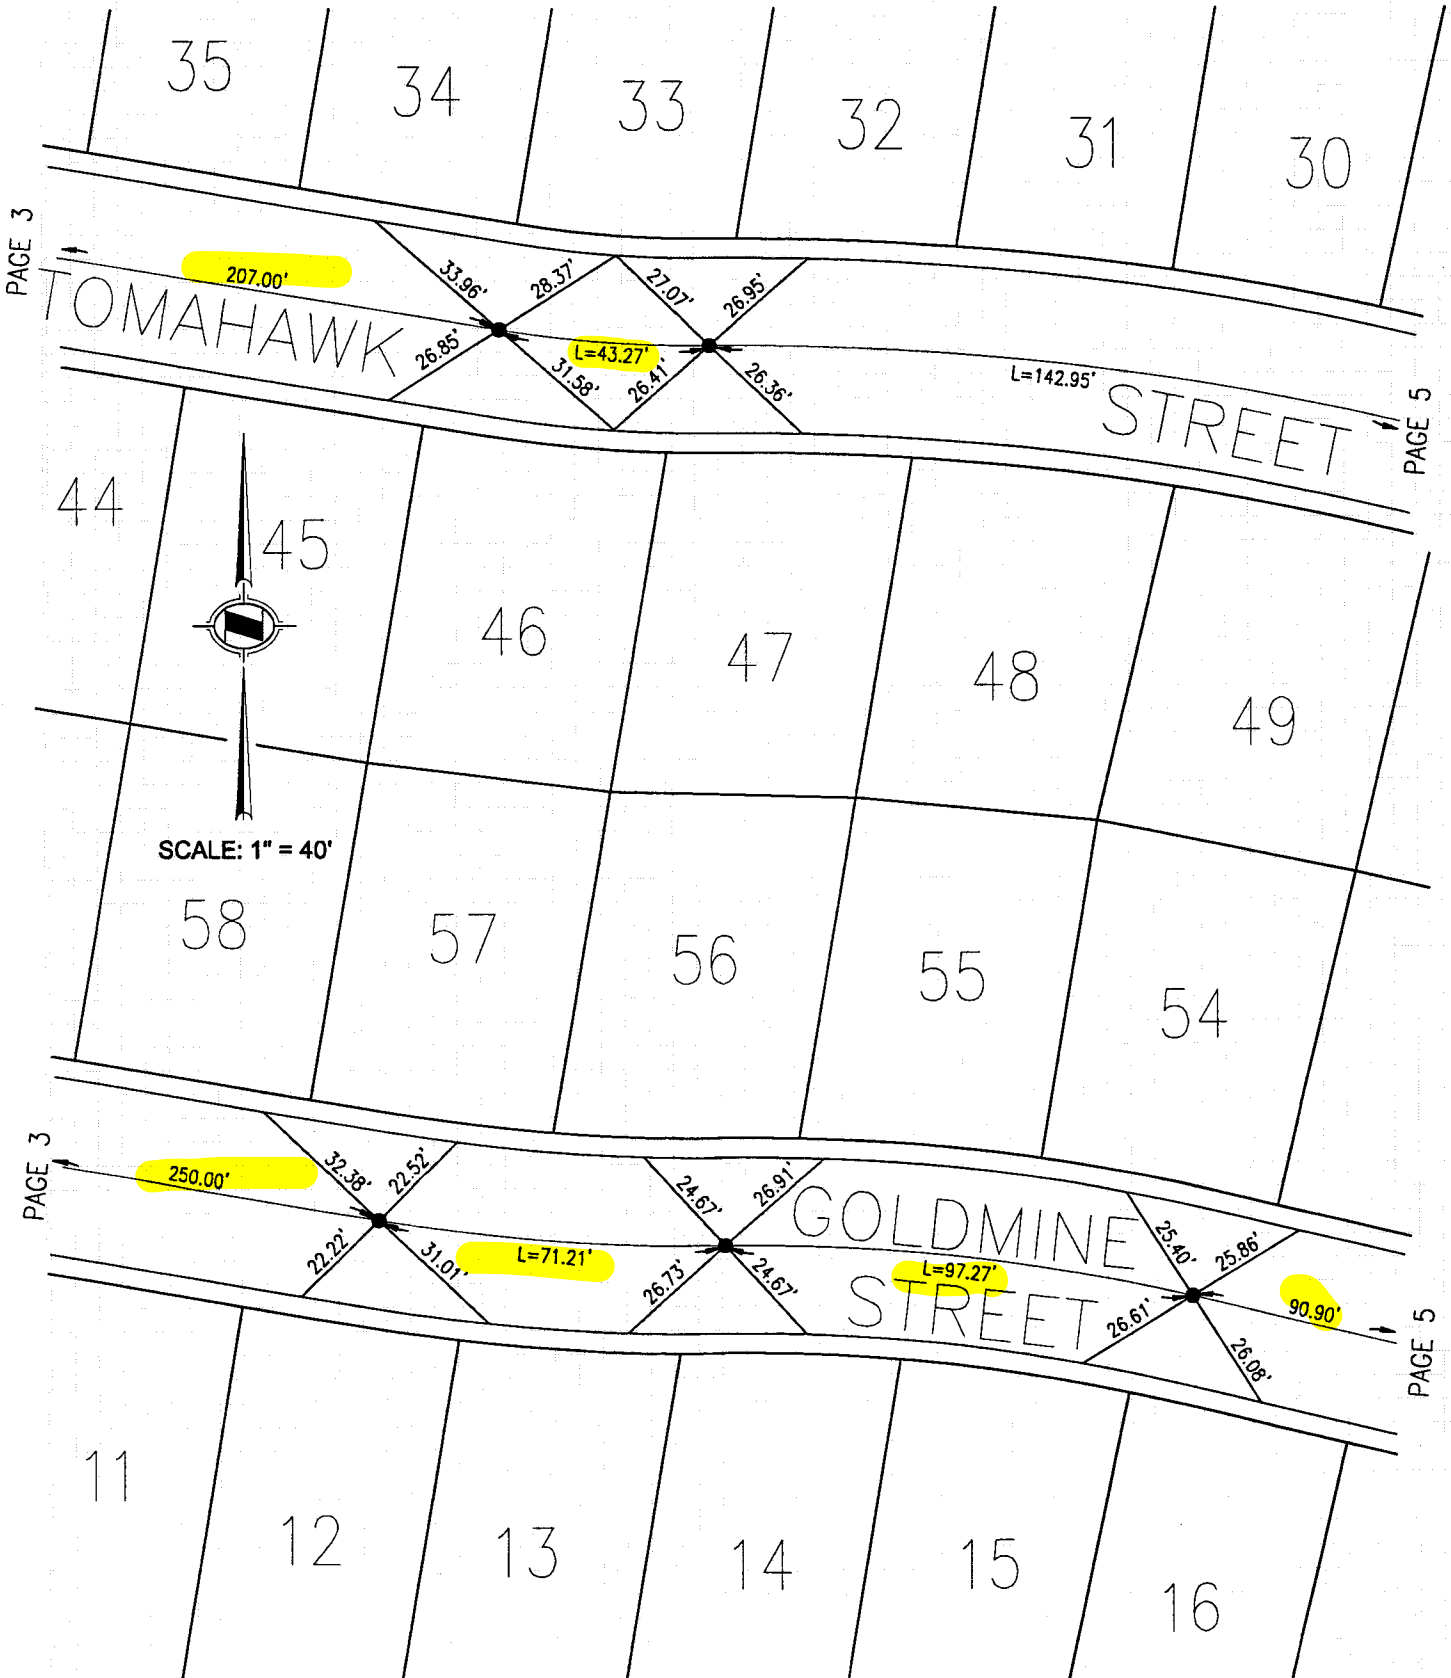

HUNSAKER & ASSOCIATES, INC.

MARCH 31, 1998

GRANGE COUNTY SURVEYOR


NOTE

LAND SURVEYOR: TOM R. MCGANNON, R.C.E. 23956

ALL TIE POINTS ARE
L & T TAGGED R.C.E. 23956
SET IN TOP OF CURB
UNLESS OTHERWISE NOTED.

LEGEND

● INDICATES SET 8" SPIKE &
WASHER STAMPED R.C.E. 23956
UNLESS OTHERWISE NOTED.

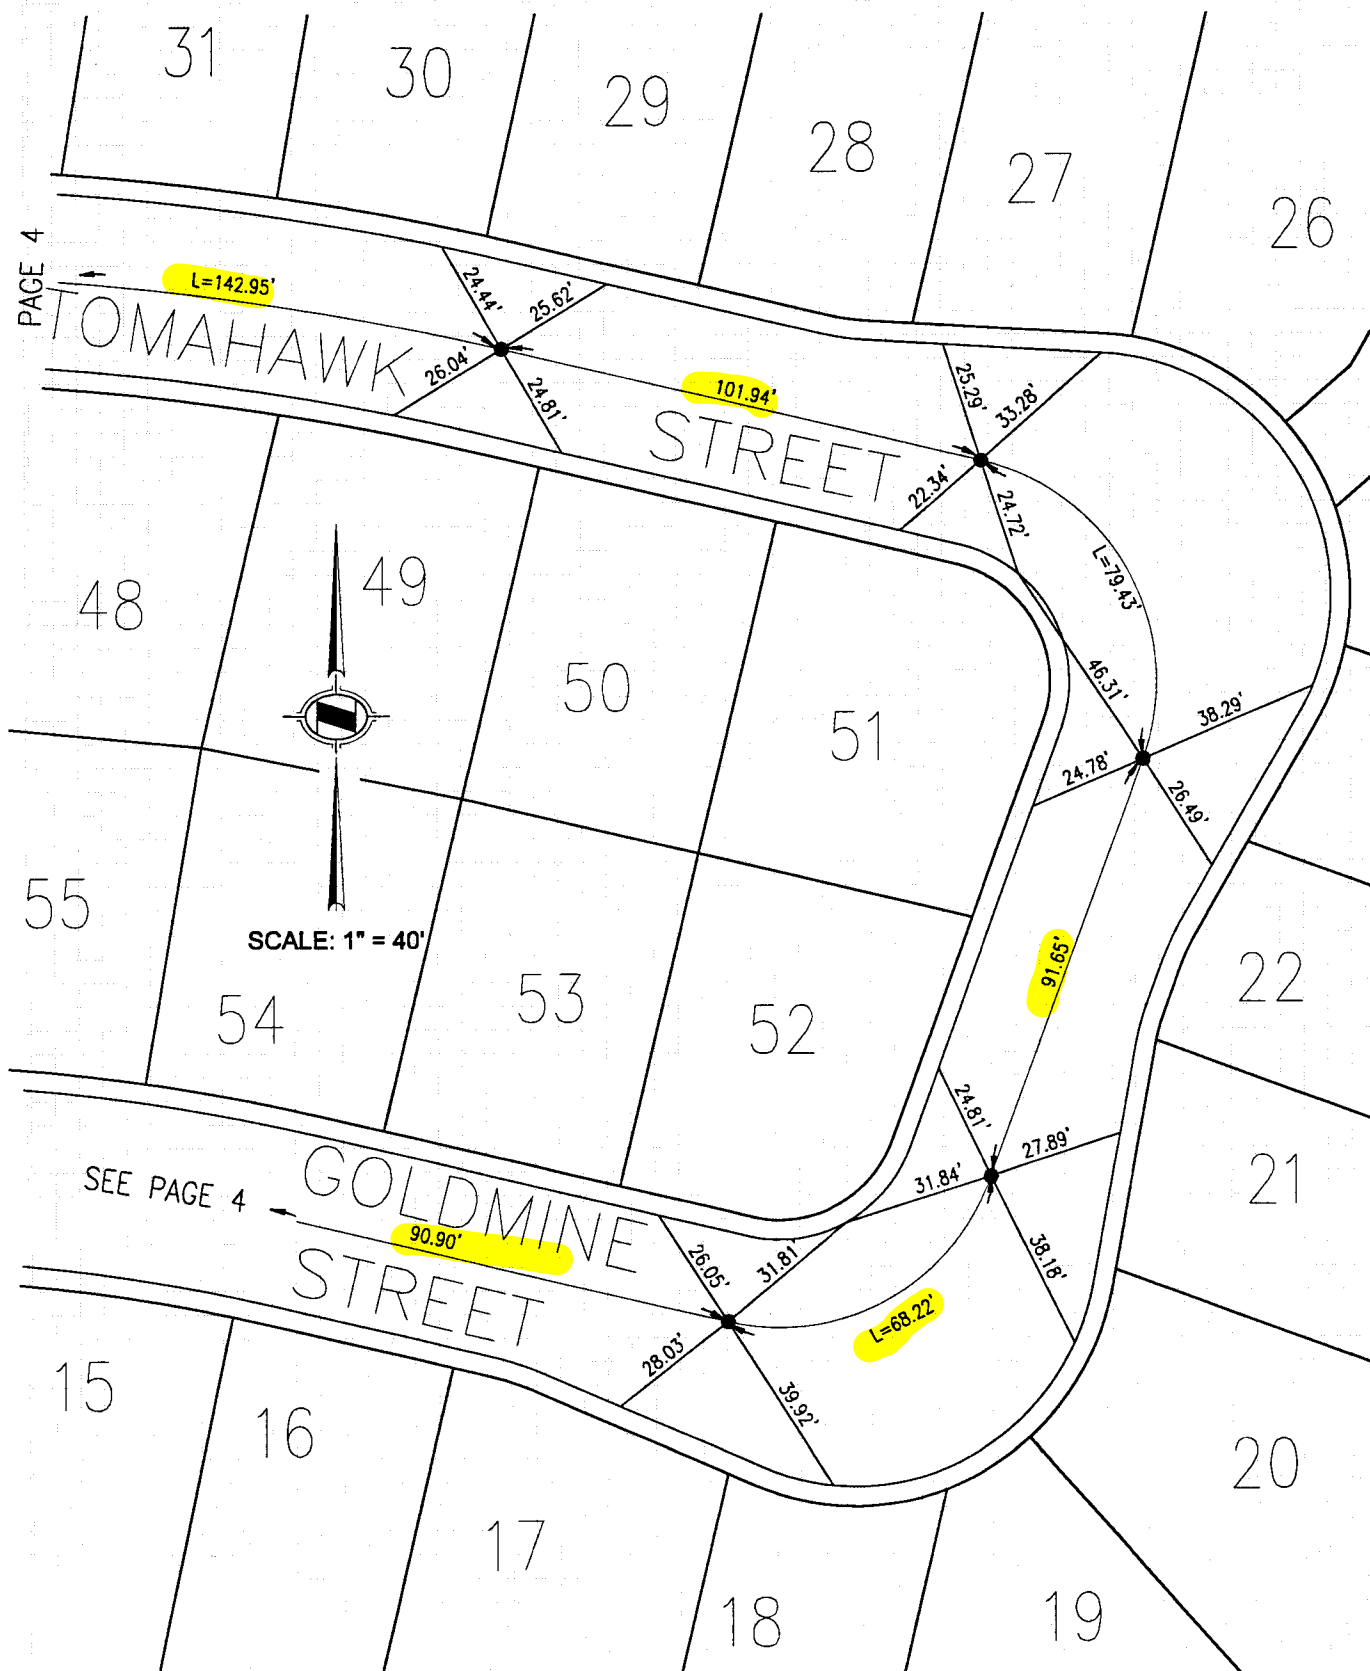


NOTE

ALL TIE POINTS ARE
L & T TAGGED R.C.E. 23956
SET IN TOP OF CURB
UNLESS OTHERWISE NOTED.

LEGEND

- INDICATES SET 8" SPIKE & WASHER STAMPED R.C.E. 23956 UNLESS OTHERWISE NOTED.
- ▲ INDICATES SPIKE & WASHER SET PER TRACT 13575

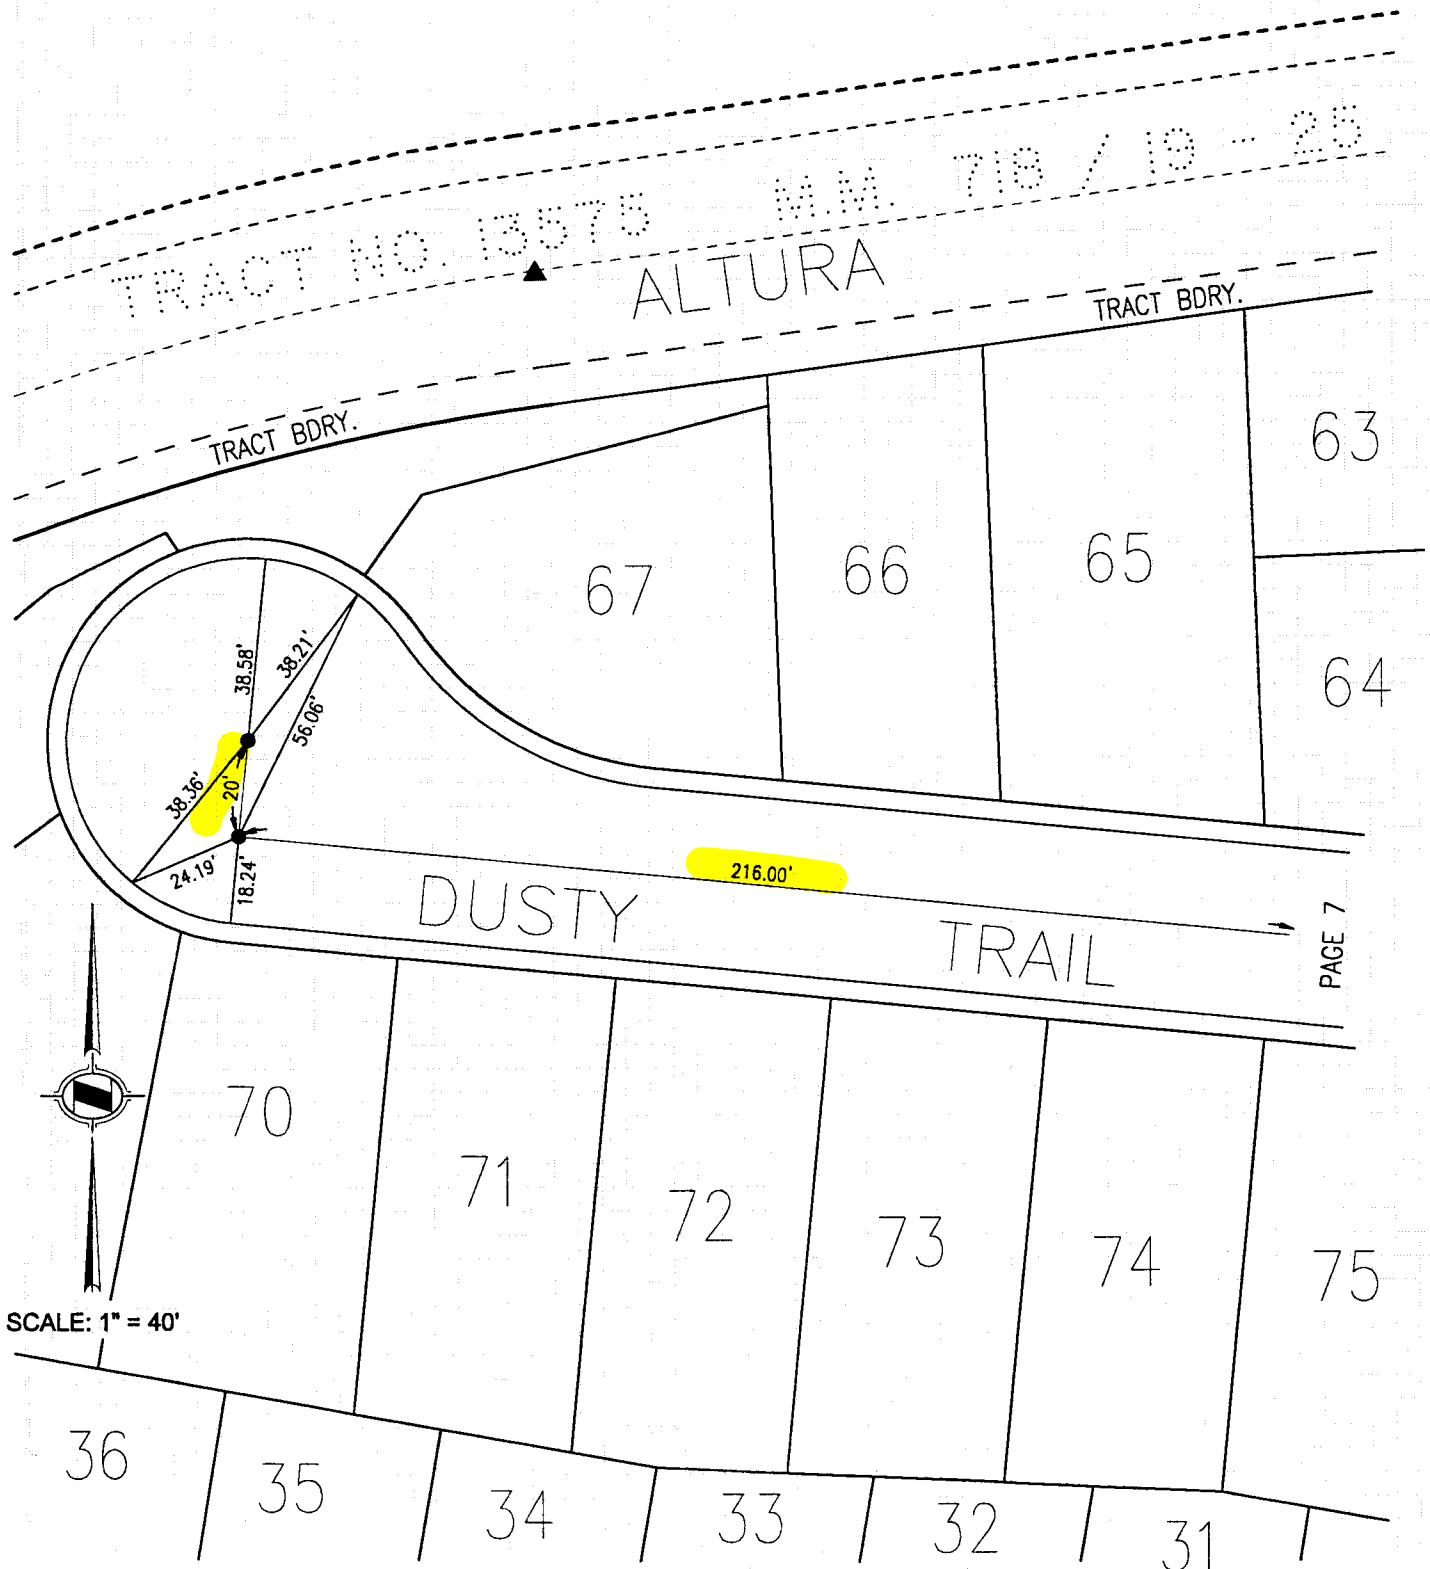

HUNSAKER & ASSOCIATES, INC.

MARCH 31, 1998

GRANGE COUNTY SURVEYOR

SURVEYED BY

LAND SURVEYOR: TOM R. McGANNON, R.C.E. 23956


NOTE

ALL TIE POINTS ARE
L & T TAGGED R.C.E. 23956
SET IN TOP OF CURB
UNLESS OTHERWISE NOTED.

LEGEND

● INDICATES SET 8" SPIKE &
WASHER STAMPED R.C.E. 23956
UNLESS OTHERWISE NOTED.

▲ INDICATES SPIKE & WASHER
SET PER TRACT 13575

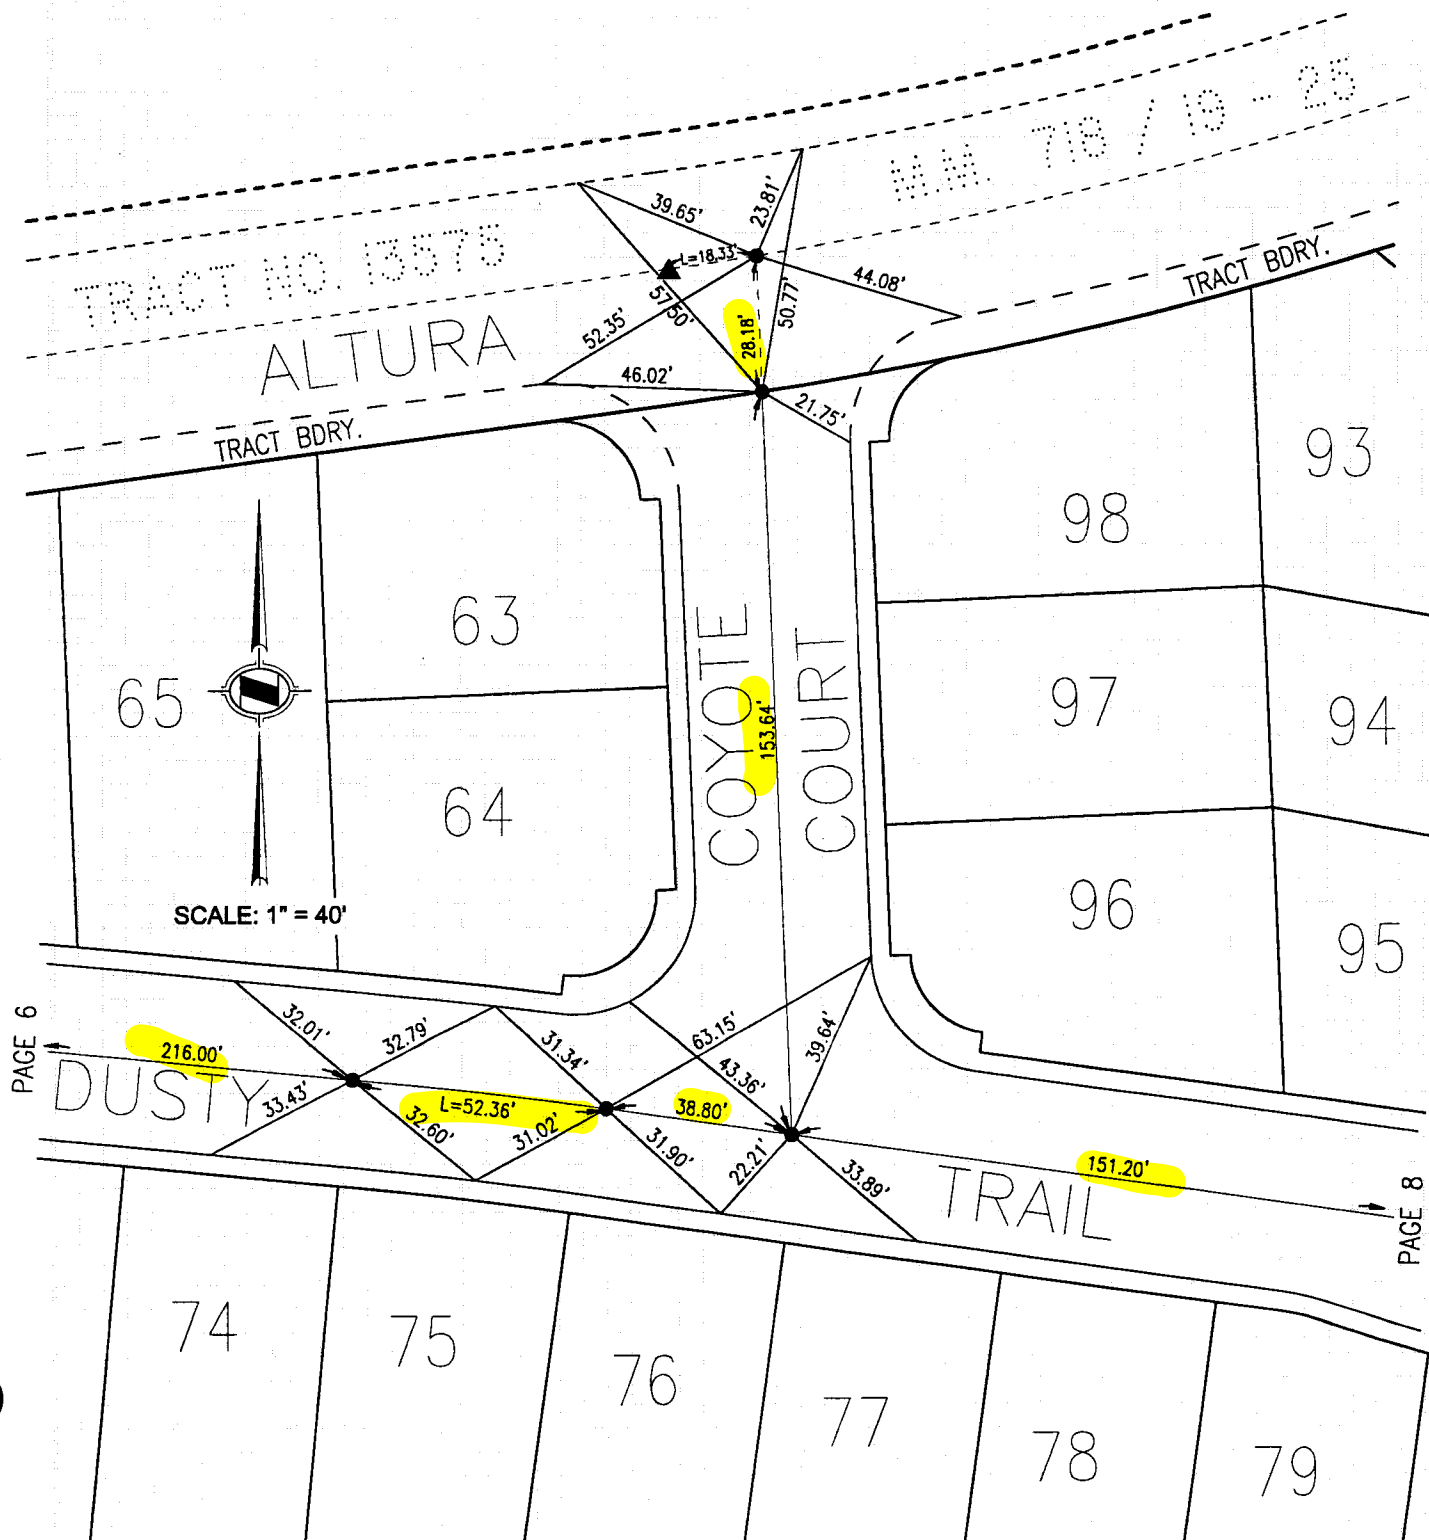

NOTE

ALL TIE POINTS ARE
L & T TAGGED R.C.E. 23956
SET IN TOP OF CURB
UNLESS OTHERWISE NOTED.

LAND SURVEYOR: TOM R. McGANNON, R.C.E. 23956

LEGEND

● INDICATES SET 8" SPIKE &
WASHER STAMPED R.C.E. 23956
UNLESS OTHERWISE NOTED.

