

**BLOCK: 5258 MODULE: 19**  
**CORNER RECORD**


WM 44E

Document Number 2000-90

City of UNINCORPORATED

County of ORANGE, California

Brief Legal Description CENTERLINE TIE NOTES FOR TRACT 15202

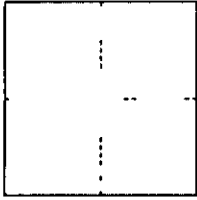

**CORNER TYPE**

Government Corner ☐ Control ☐  
Meander ☐ Property ☒  
Rancho ☐ Other ☐  
Date of Survey 1/20/00

**COORDINATES  
(Optional)**

N \_\_\_\_\_  
E \_\_\_\_\_  
Zone \_\_\_\_\_ Datum \_\_\_\_\_  
Elev \_\_\_\_\_

Corner — Left as found ☐ Found and tagged ☐ Established ☒ Reestablished ☐ Rebuilt ☐

Identification and type of corner found Evidence used to identify or procedure used to establish or reestablish the corner  
INDEX MAP FOR TRACT 15202

A description of the physical condition of the monument as found and as set or reset \_\_\_\_\_

**SURVEYOR'S STATEMENT**

This Corner Record was prepared by me or under my direction in conformance with the  
Land Surveyors' Act on JANUARY 20, 2000

Signed Tom R McGannon L.S. or R.C.E. Number 23956




**COUNTY SURVEYOR'S STATEMENT**

This Corner Record was received 3/9/ 2000 and examined

and filed March 22nd, 2000

Signed Robert Jelnick Title DEPUTY COUNTY SURVEYOR

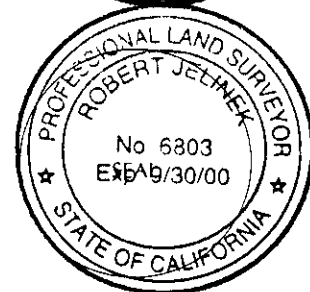

County Surveyor's Comment \_\_\_\_\_

MONUMENT NOTES

- SET SPIKE & WASHER  
STAMPED R C E 23956,  
UNLESS OTHERWISE NOTED

ALL TIE POINTS ARE LEAD &  
TACK TAGGED R C E 23956  
IN TOP OF CURB

ALL INTERIOR STREETS OF  
TRACT 15202 ARE PRIVATE



SCALE 1" = 100'

