## BLOCK: 5259 MODULE: 00

WM44E

COKNER RECORD	Document Number 20	00-102
City of <u>UNINCORPERATED</u>	County of ORANGE	, California
Brief Legal Description CENTERLINE TIE NOTES FOR TRA	ACT 15201	
Government Corner	Control         N	COORDINATES (Optional) Datum
Corner — Left as found ☐ Found and tagged ☐	Established 🛭 Reestablished	I ☐ Rebuilt ☐
A PORTION OF CENTERLINE TIE NOTE'S FOR THE ABO  A description of the physical condition of the monument as for	VE MENTIONED TRACT	
SURVEYOR'S STATEMENT  This Corner Record was prepared by me or under my direction of Surveyors' Act on MANUARY 20		No 23956
Signed Ton R 12mc Hannetsor RCE N	<del></del>	Exp <sup>SE</sup> 12/31/01
and filed March 27nd, to 2000	and examined  Title DEPUTY COUNTY SURVEYOR	SAM 6803 Exp 9/30/00

Page 1 of Z

**HUNSAKER & ASSOCIATES, INC.** LAND SURVEYOR TOMR McGANNON, R C E 23956

DATE 1/21/00


OTHER SHEETS ARE ON SEPARATE CORNER RECORDS

## MONUMENT NOTES

 SET SPIKE & WASHER STAMPEDRCE 23956, **UNLESS OTHERWISE NOTED** 

**ALL TIE POINTS ARE LEAD &** TACK TAGGED R C E 23956 IN TOP OF CURB

ALL INTERIOR STREETS OF

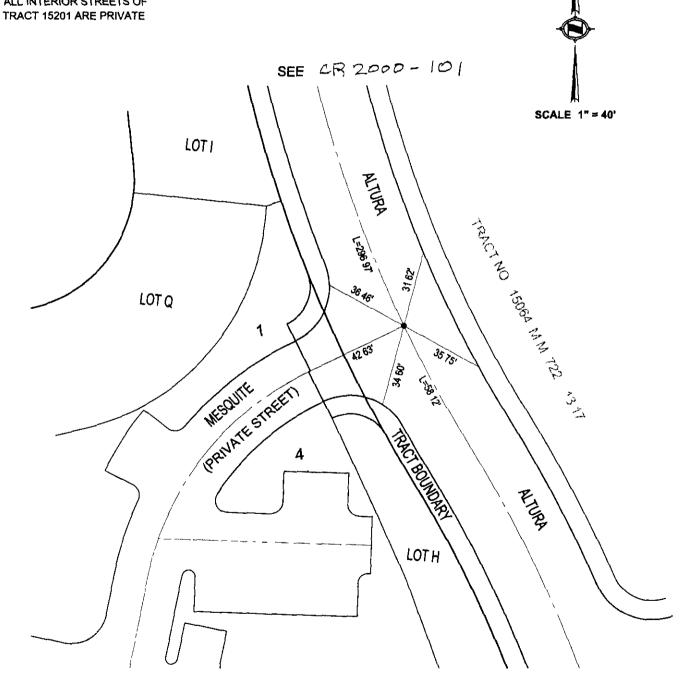

Page 2 of 2