


# CORNER RECORD

Document Number 2001-1575  
 City of UNINCORPORATED County of ORANGE, California

Brief Legal Description TIES FOR TRACT 14955

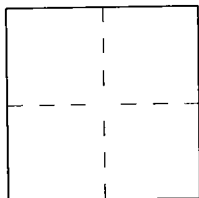

## CORNER TYPE

Government Corner ☐ Control ☐  
 Meander ☐ Property ☒  
 Rancho ☐ Other ☐

Date of Survey AUGUST 22, 2001

## COORDINATES (Optional)

N. \_\_\_\_\_  
 E. \_\_\_\_\_  
 Zone \_\_\_\_\_ NAD27 ☐ NAD83 ☐  
 NAD83 Epoch \_\_\_\_\_  
 Elev. \_\_\_\_\_  
 Vert. Datum: NGVD29 ☐ NAVD88 ☐  
 Meas. Units: Metric ☐ Imperial ☐  
 U.S. Survey foot ☐

Corner — Left as found ☐ Found and tagged ☐ Established ☒ Reestablished ☐ Rebuilt ☐

Identification and type of corner found; Evidence used to identify or procedure used to establish or reestablish the corner:

FOUND SPIKE AND WASHER, R.C.E. 23956 OR SET SPIKE AND WASHER, L.S. 6654

AT THE CENTERLINE OF THE STREETS IN THIS TRACT ON OSO PARKWAY,

BRIDLE PATH, GINGHAM STREET, PROSPECTOR COURT, WRANGLER COURT,

AND CALICO COURT, PER TRACT NO. 14955, MM 728/42-48, AS CORRECTED


BY CERTIFICATE OF CORRECTION, INST. NO. 20010079973, O.R.

A description of the physical condition of the monument as found and as set or reset: \_\_\_\_\_

## SURVEYOR'S STATEMENT

This Corner Record was prepared by me or under my direction in conformance with  
 the Land Surveyor's Act on SEPTEMBER 18, 2001

Signed Rory S. Williams L.S. or R.C.E. No. 6654

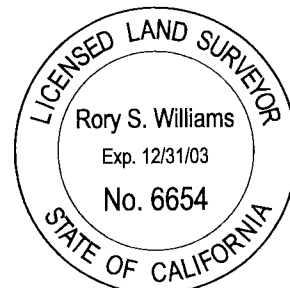


## COUNTY SURVEYOR'S STATEMENT

This Corner Record was received JAN 3, 2002  
 and examined and filed FEB 08 2002

Signed Robert Jelinek L.S. or R.C.E. No. 6803

Title DEPUTY COUNTY SURVEYOR

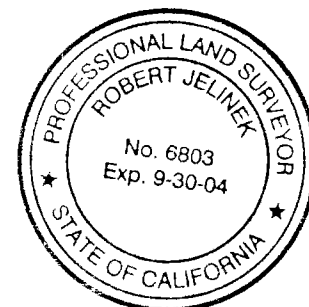

County Surveyor's Comment \_\_\_\_\_

HUNSAKER &amp; ASSOCIATES, INC.

SEPTEMBER 18, 2001

NOTE

● TIE POINTS ARE L & T  
TAGGED R.C.E. 23956 SET  
IN TOP OF CURB UNLESS  
OTHERWISE NOTED.

■ TIE POINTS ARE L & T  
TAGGED L.S. 6654 SET  
IN TOP OF CURB UNLESS  
OTHERWISE NOTED.

LAND SURVEYOR: RORY WILLIAMS L.S. 6654

LEGEND

○ INDICATES FOUND 8" SPIKE &  
WASHER STAMPED R.C.E. 23956  
UNLESS OTHERWISE NOTED.

□ INDICATES FOUND 8" SPIKE &  
WASHER STAMPED L.S. 6654 UNLESS  
OTHERWISE NOTED, PER CERTIFICATE  
OF CORRECTION, INST. NO.  
20010079973, O.R.

