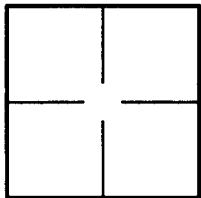


CORNER RECORD

Document Number 2014-2999-BCity of UNINCORPORATED AREA OF County of ORANGE, CaliforniaBrief Legal Description FRONTIER STREET CUL-DE-SAC; NW'LY OF CHEYENNE STREET

CORNER TYPE

Government Corner ☐ Control ☒
Meander ☐ Property ☐
Rancho ☐ Other ☐

Date of Survey 10/16/2014

COORDINATES (Optional)

N. _____
E. _____
Zone _____ NAD27 ☐ NAD83 ☐
NAD83 Epoch _____
Elevation _____
Vertical Datum: NGVD29 ☐ NAVD88 ☐
Units: Metric ☐ Imperial ☐ U.S. Survey ☒

Corner — Left as found ☒ Found and tagged ☐ Established ☐ Reestablished ☐ Rebuilt ☐

Identification and type of corner found; Evidence used to identify or procedure used to establish or reestablish corner:
Found as described on the reverse of this sheet.

A description of the physical condition of the monument as found and as set or reset: _____

See Page 2

SURVEYOR'S STATEMENT

This Corner Record was prepared by me or under my direction in conformance with
the Professional Land Surveyors' Act on 11/05/2014

Signed [Signature] P.L.S. or R.C.E. No. L.S. 5411




COUNTY SURVEYOR'S STATEMENT

This Corner Record was received NOV 06 2014

examined and filed NOV 13 2014


Signed [Signature] P.L.S. or R.C.E. No. 6131

Title Chief Deputy Surveyor

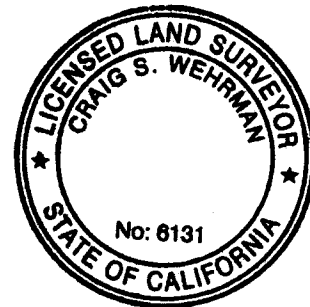

County Surveyor's Comment _____

R-1 = COUNTY OF ORANGE CORNER RECORD 2014-1601 A
 [] = RECORD & MEASURED DISTANCE PER R-1

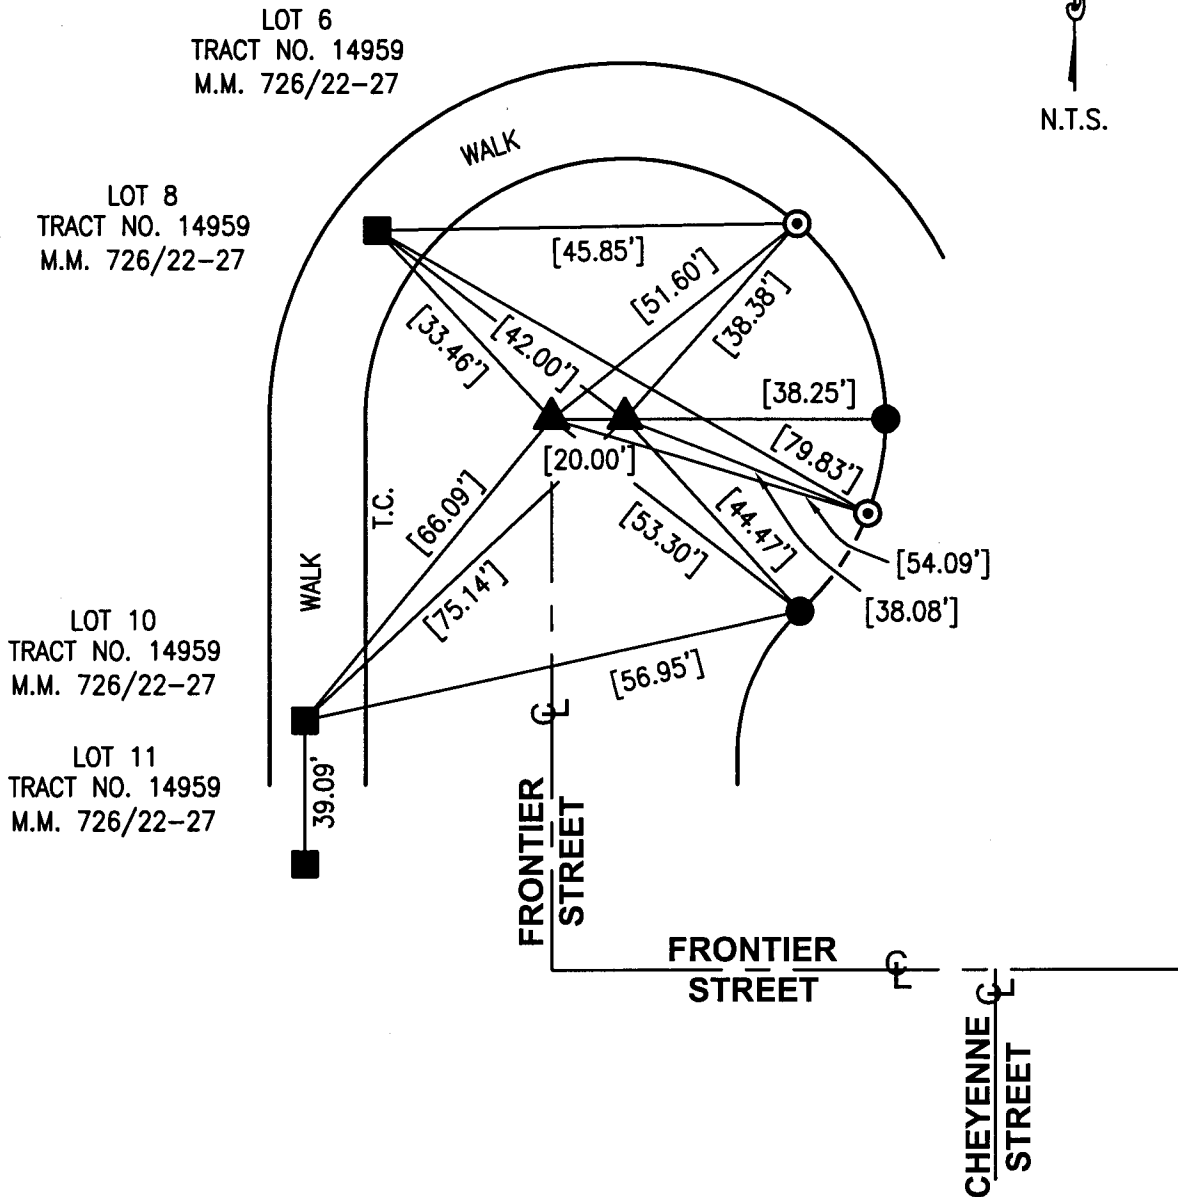

- ▲ FD GEAR SPK & W, STAMPED "RCE 23956" PER R-1, FLUSH, AFTER CONSTRUCTION.
- FD L, T & T "RCE 23956" POSSIBLY PROP. LINE PROD. PER R-1, FLUSH IN WALK, AFTER CONSTRUCTION.
- FD L, T & T "RCE 23956" IN T.C. PER R-1.
- ⊙ FS L, T & T "LS 5411" IN T.C. PER R-1.

THE PURPOSE OF THIS RECORD IS TO DOCUMENT THE PERPETUATION OF FOUND MONUMENT(S) PURSUANT TO THE PLS ACT SECTION 8771. NO CLAIM IS MADE REGARDING THE CORRECTNESS OF THE POSITION(S) OF SAID MONUMENT(S), NOR THE DIMENSIONAL RELATIONSHIP TO STREET CENTERLINES OR PROPERTY BOUNDARIES.

14-RJN-512