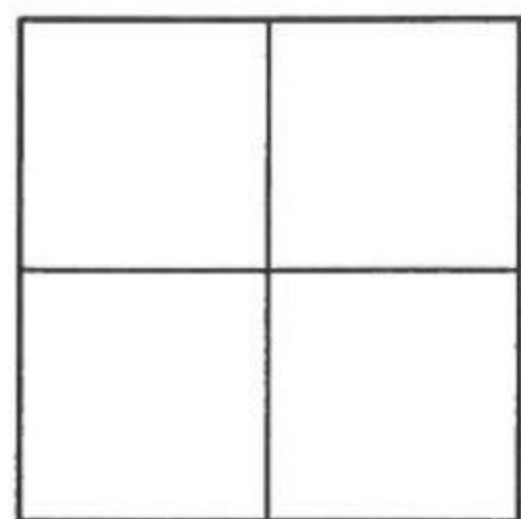


# CORNER RECORD

Agency Index

Document Number

**2017-1411A**City of UNINCORPORATED TERRITORYCounty of ORANGE, CaliforniaBrief Legal Description APPARENT RADIUS POINT OF CUL-DE-SAC ON CALICO COURT**CORNER TYPE**

Government Corner ☐ Control ☐  
Meander ☐ Property ☐  
Rancho ☐ Other ☒

Date of Survey MAY, 2017**COORDINATES (Optional)**

N. \_\_\_\_\_ E. \_\_\_\_\_  
Elevation \_\_\_\_\_  
Units Metric ☐ U.S. Survey Foot ☒  
Horizontal Datum \_\_\_\_\_  
Zone \_\_\_\_\_ Epoch Date \_\_\_\_\_  
Vertical Datum \_\_\_\_\_

☐ Complies with Public Resources Code §§8801-8819  
☐ Complies with Public Resources Code §§8890-8902

PLS Act Ref: ☐ 8765(d) ☒ 8771 ☐ 8773 ☐ Other:  
Corner/Monument: ☒ Left as found ☐ Established ☐ Rebuilt ☒ Pre-Construction  
☐ Found and tagged ☐ Reestablished ☐ Referenced ☐ Post-Construction

Narrative of corner identified and monument as found, set, reset, replaced, or removed:

☒ See sheet #2 for description (s):**SURVEYOR'S STATEMENT**


This Corner Record was prepared by me or under my direction in conformance with  
the Professional Land Surveyors' Act on 1-8-18

Signed Jesom Moreno (P.L.S.) or R.C.E. No. 8478**COUNTY SURVEYOR'S STATEMENT**This Corner Record was received JUL 20 2017and examined and filed OCT 21 2019Signed Kevin R. Hills (P.L.S.) or R.C.E. No. 6617Title COUNTY SURVEYOR

County Surveyor's Comment \_\_\_\_\_



## PRE-CONSTRUCTION C.R.

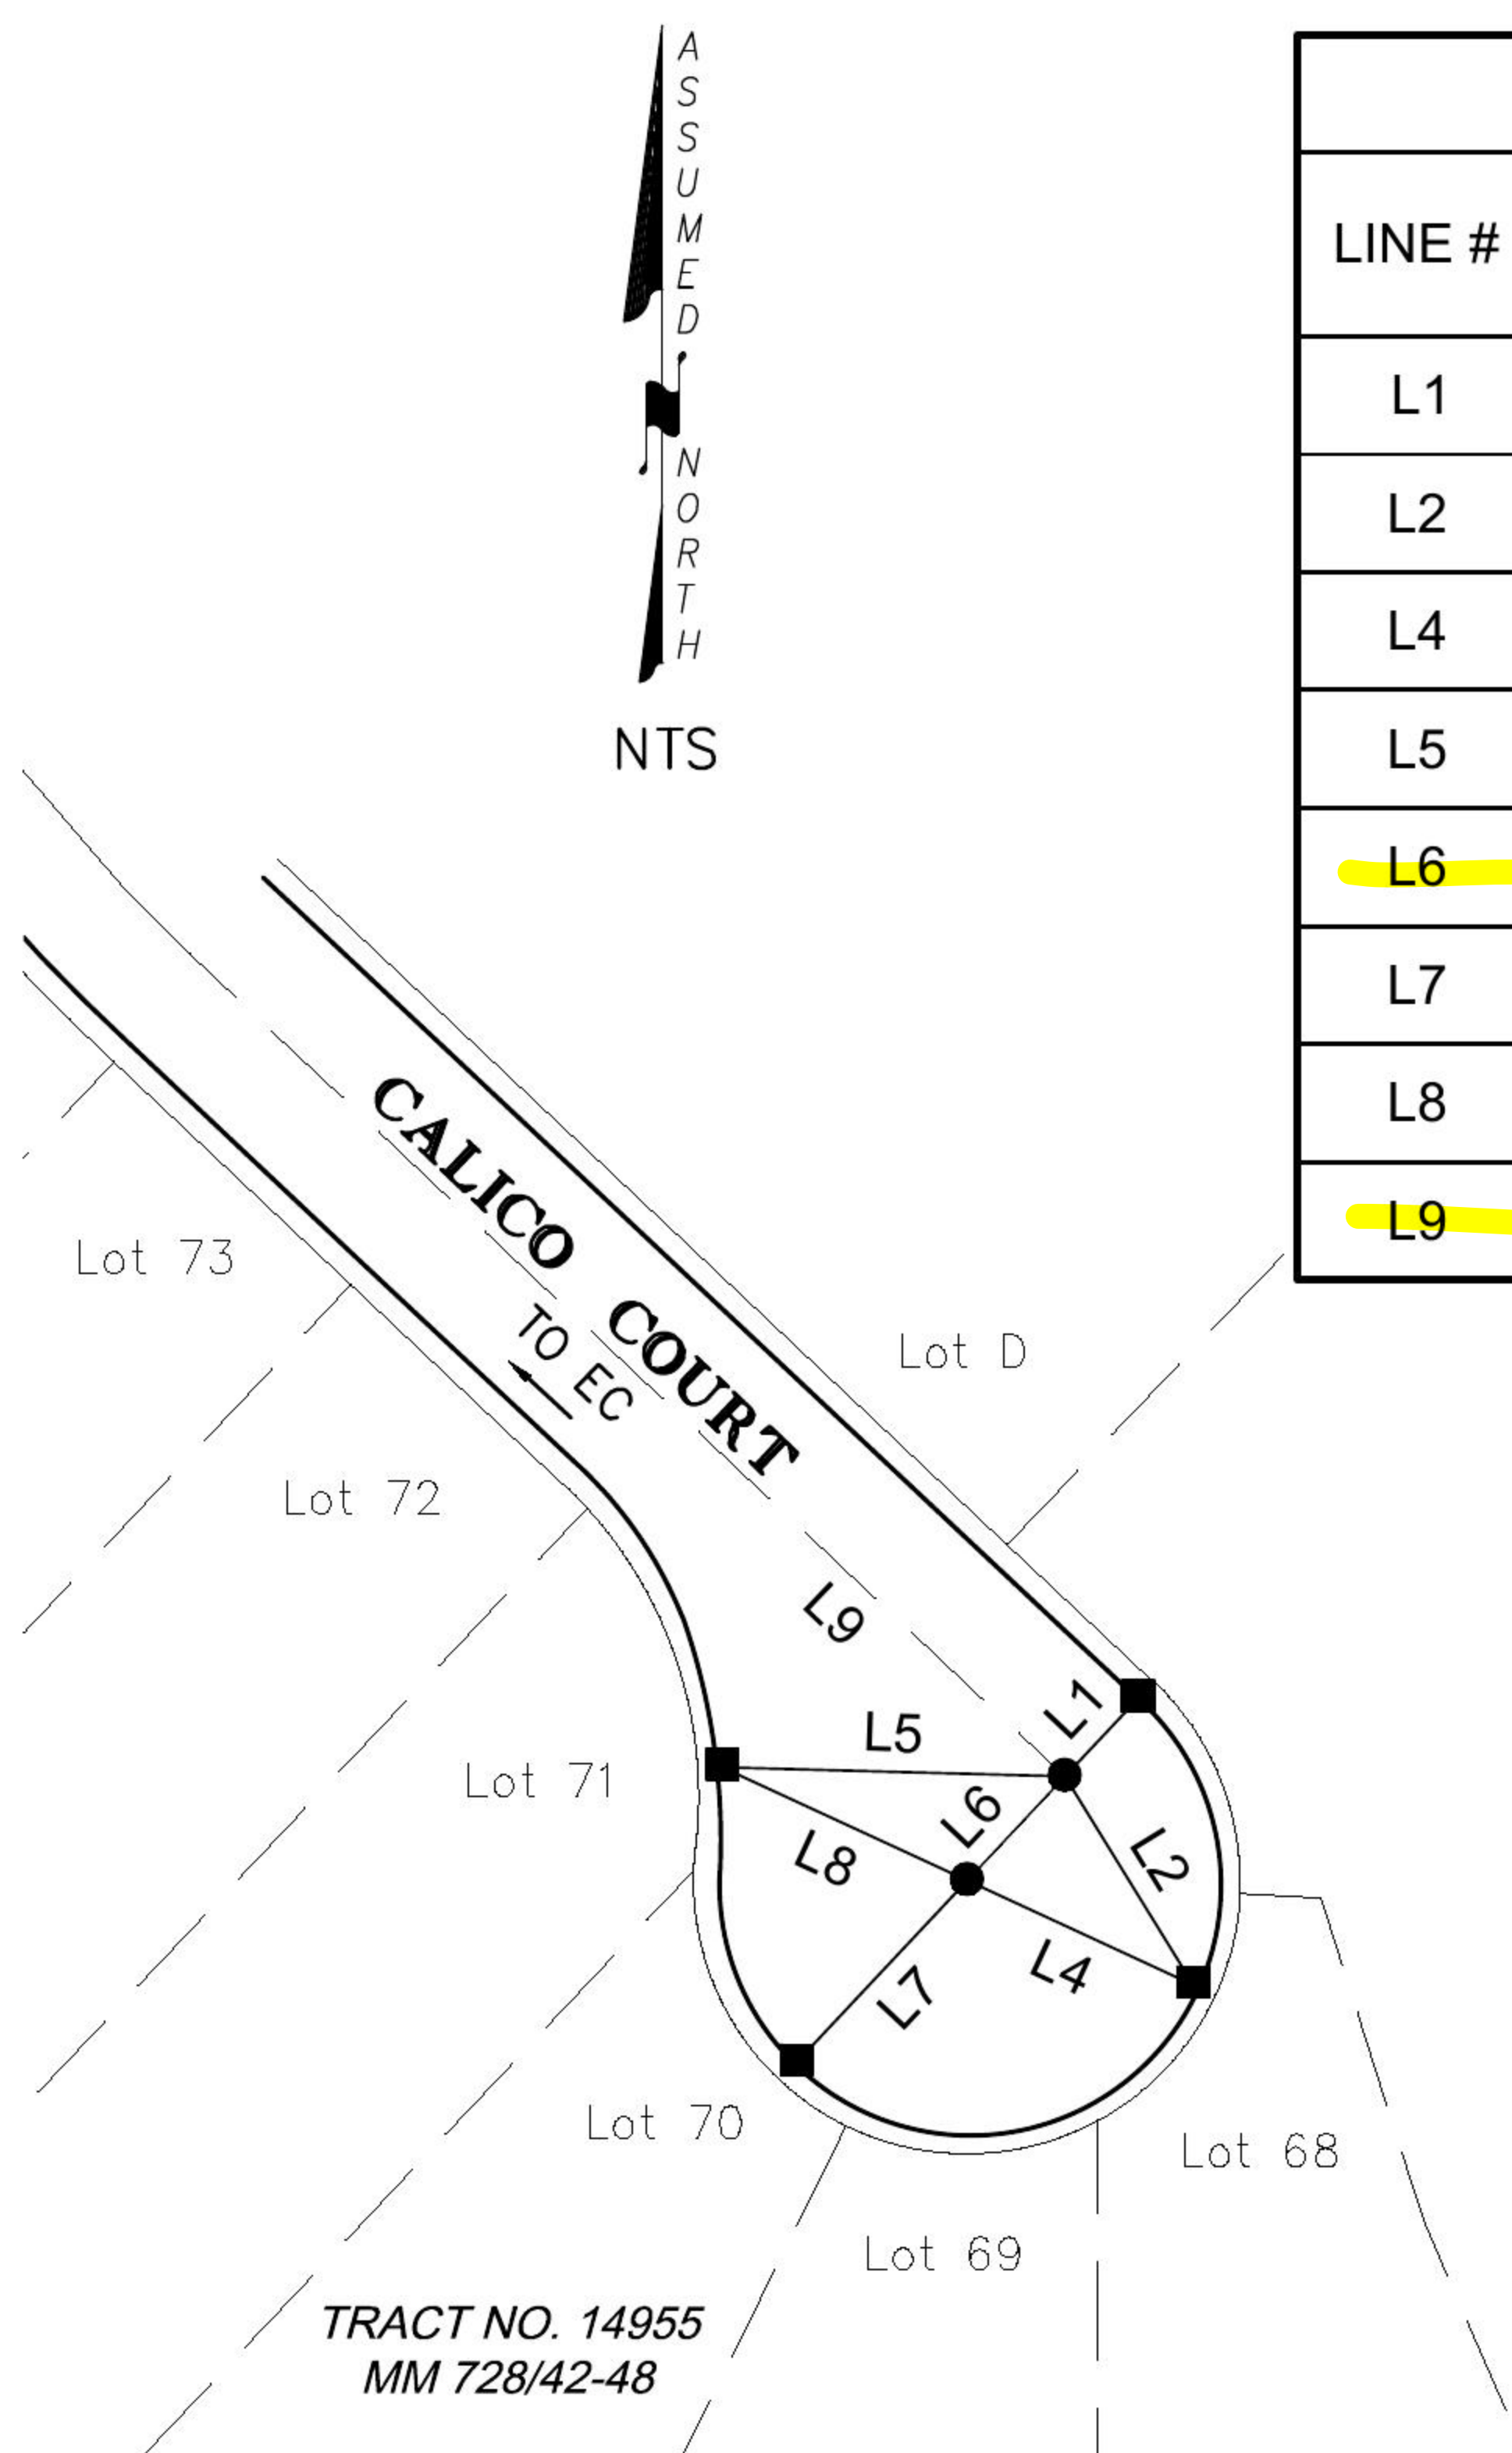

LINE TABLE			
LINE #	BEARING	MEASURED DISTANCE	RECORD DISTANCE
L1	N43°13'09"E	16.28'	(16.28')
L2	N31°27'07"W	37.59'	(37.56')
L4	N65°10'40"W	38.20'	(38.18')
L5	N88°31'52"W	52.76' *	(52.81')
L6	N43°13'06"E	22.00'	(22.00')
L7	N43°07'48"E	38.42' *	(38.38')
L8	N65°10'54"W	41.50' *	(41.57')
L9	N46°46'54"W	184.64'	(184.64')

LEGEND:

\* DISTANCE MEASURED  
VERIFIED IN FIELD

RECORD REFERENCES:

(R1) ORANGE COUNTY CORNER RECORD 2001-1582

MONUMENT NOTES:

- FOUND LEAD & TACK, TAGGED "RCE 23956" ON TC.
- FOUND GEAR SPIKE & WASHER, STAMPED "RCE 23956", FLUSH PER R1.

NOTES:

- BEARINGS SHOWN HEREON ARE ASSUMED AND ARE DISPLAYED FOR ANGULAR RELATIONSHIP ONLY.
- PARCEL LINES SHOWN HEREON ARE FOR GRAPHICAL REPRESENTATION ONLY.