
COR	NER RI	FCORI	Ager	ıcy Index		
COIL			Docu	ıment Number	2020-:	2693
City of <u>UNI</u>	NCORPORATED TE	RRITORY	Cou	nty of <u>ORAN</u>	NGE	, California
Brief Legal Des	cription <u>APPAREN</u>		JS & RADII	JS PT OF DRO	OVER CT. CU	L-DE-SAC, +/- 89'
	SWILYOF	STAMPEDE ST CORNER	TYPE		COORDIN	ATES (Optional)
		2 2 7 11 12 1		N		E
		<u>-</u>	ontrol	Elevation	Matria 🔲	U.S. Survey Foot
	Meande	_	roperty	Units		, —
	Rancho	⊠ c	ther		atum	Date
	Date of Surve	y_AUGUST 14, 202	20			
				_		rces Code §§8801-8819
						rces Code §§8890-8902
PLS Act Ref:	☐ 8765(d)	⊠ 8771	□ 8	773		Other:
Corner/	Left as found	Established	□R	ebuilt		Pre-Construction
Monument:	☐ Found and tagge	d 🛚 Reestablished	d \square R	eferenced		Post-Construction
THE PURPOSE OF SECTION 8771. LOCATIONS. RIG DISPLAYED FOR MEASURED DIST 1.00007120. RECORD DISTAN GROUND, AS PE	NO CLAIM IS MADE A CHT OF WAY, PARCEL, CRAPHICAL REPRESE WN HEREON ARE ASSUTANCES SHOWN HEREON ER SAID RECORD.	S TO THE RELATIONS OR LOT LINES, OR A NTATION ONLY. IMED AND ARE DISPL IN ARE GRID DISTANG ARE AS THEY APPEA RVEYOR'S STATE! red by me or under	SHIP OF THE ANY OTHER .AYED FOR .CES. TO OBTAIN THE MENT my direction	POINTS SHOWN DATA RELATED ANGULAR RELAT TAIN A GROUND DOCUMENT OF F	I HEREON TO TO TO DELINEATIONSHIP ONLY. DISTANCE, MURECORD. DISTA	RSUANT TO THE PLS ACT TRUE BOUNDARY N OF PROPERTY RIGHTS AR LTIPLY A GRID DISTANCE BY NCES MAY BE EITHER GRID SED LAND SUAL ON MORELY OR
	Juga Manen		P.L.S. or R	.C.E. No. 84 ⁷	78	NO. 8478 WATE OF CALIFORN OF
This Corne	er Record was receiv			21		SED LIN R. A.
	ined and filed		ARY 23, 20			W Cop
	ined and med					
Signed	per K. M.	<u></u>	P.L.S.)or R	.C.E. No. 661		NO. 6617 NO.
Title	COUNTY SURVEYO	DR				NO. 6617 NO. 6617 NO. 6617 NO. 6617
•	urveyor's Comment _1 D_PRE-CONSTRUCTION					

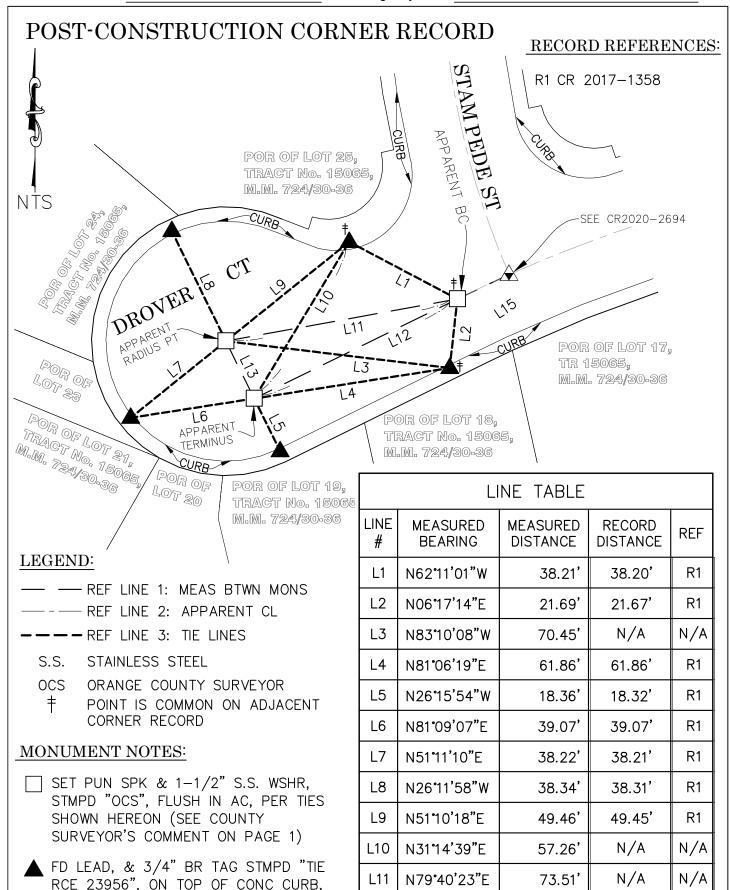

L12

L13

N63°53'14"E

N26°11'55"W

70.71

20.00

70.71

20.00

R1

R1

PER R1

FD MONUMENT AS DESCRIBED ON

ADJACENT CORNER RECORD