•		CORD	Document Number	2020-2703
•	NCORPORATED TER	RITORY	County of ORAN	
nei Legai Des	cription <u>APPARENT</u> PROSPECTO	BC & EC ALONG GII	-	
	Governme  Meander  Rancho	CORNER TYPI	N	-
	Date of Survey_	AUGUST 14, 2020	_ Vertical Datui ☐ Complies with	Epoch Date m Public Resources Code §§8801-8819 Public Resources Code §§8890-8902
LS Act Ref:	☐ 8765(d)	<b>⊠</b> 8771	□ 8773	Other:
orner/ lonument:	☐ Left as found☐ Found and tagged	☐ Established ☐ Reestablished	Rebuilt Referenced	☐ Pre-Construction ☐ Post-Construction
THE PURPOSE SECTION 8771. LOCATIONS. RIG	NO CLAIM IS MADE AS	TO THE RELATIONSHIP R LOT LINES, OR ANY	OF THE POINTS SHOWN	NUMENT(S) PURSUANT TO THE PLS ACT HEREON TO TRUE BOUNDARY TO DELINEATION OF PROPERTY RIGHTS A
MEASURED DIST .00006558. RECORD DISTAN	NCES SHOWN HEREON AF ER SAID RECORD.	ARE GRID DISTANCES. RE AS THEY APPEAR O	TO OBTAIN A GROUND  N THE DOCUMENT OF R	DISTANCE, MULTIPLY A GRID DISTANCE ECORD. DISTANCES MAY BE EITHER GRID
MEASURED DIST .00006558. RECORD DISTAN BROUND, AS PE	TANCES SHOWN HEREON NCES SHOWN HEREON AF ER SAID RECORD.	ARE GRID DISTANCES.  RE AS THEY APPEAR O  /EYOR'S STATEMEN	TO OBTAIN A GROUND  N THE DOCUMENT OF R  T	DISTANCE, MULTIPLY A GRID DISTANCE E ECORD. DISTANCES MAY BE EITHER GRID
MEASURED DIST .00006558. RECORD DISTAN GROUND, AS PE This Corne the Profes	TANCES SHOWN HEREON NCES SHOWN HEREON AF ER SAID RECORD. SUR\	ARE GRID DISTANCES.  RE AS THEY APPEAR OF  /EYOR'S STATEMEN  d by me or under my of  Act on FEBRUARY	TO OBTAIN A GROUND  N THE DOCUMENT OF R  T  Iirection in conformance	ECORD. 



## POST-CONSTRUCTION CORNER RECORD



SEE CR 2020-2701 APPARENT BC APPARENT POR OF LOT 61, POR OF LOT 13, TRACT No. 14955, M.M. 728/42-48 TRACT No. 14955 M.M. 728/42-48


## MONUMENT NOTES:

SET PUN SPK & 1-1/2" S.S. WSHR, STMPD "OCS", FLUSH IN AC, PER TIES SHOWN HEREON

FD LEAD, & 3/4" BR TAG STMPD "TIE RCE 23956", ON TOP OF CONC CURB, PER R1

FD MONUMENT AS DESCRIBED ON ADJACENT CORNER RECORD

LINE TABLE							
LINE #	MEASURED BEARING	MEASURED DISTANCE	RECORD DISTANCE	REF			
L1	N24°08'42"E	27.33'	27.35'	R1			
L2	N65°45'47"W	25.42'	25.42'	R1			
L3	N24°05'48"E	26.38'	26.40'	R1			
L4	N65°46'03"W	24.68'	24.68'	R1			
L5	N08°38'33"W	40.92'	40.92	R2			
L6	N89°38'14"E	23.53'	23.53'	R2			
L7	N08°32'04"W	35.64'	35.64'	R2			
L8	N89°35'05"E	22.90'	22.90'	R2			
L9	N17°47'34"W	441.42'	441.46'	R3			
L10 (CHORD)	N28°36'47"W	93.72'	93.70'	R3			
L11	N39°21'41"W	53.73	53.72'	R3			
L12	N77°39'40"W	29.47	29.47	R2			

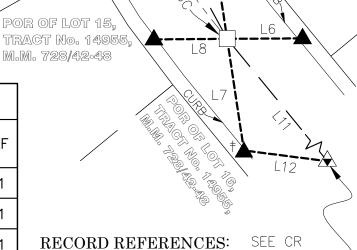

2020-2704 APPARENT EC

POR OF LOT 60,

TRACT No. 14955, M.M. 728/42-48

R1 CR 2017-1405

R2 CR 2017-1404

R3 TR 14955 M.M.728/42-48

## LEGEND:

- REF LINE 1: MEAS BTWN

MONS

---- REF LINE 2: APPARENT CL

--- REF LINE 3: TIE LINES

S.S. STAINLESS STEEL

POINT IS COMMON ON ADJACENT CORNER RECORD

OCS ORANGE COUNTY SURVEYOR