				Agency Index		
COIN	NER F	\L OO		Document Number	2020-2	2704
•	<u>INCORPORATED</u>			County of ORAN		, California
Brief Legal Des				<u>PPARENT INTERSE</u> /- NW'LY OF PROSI		ROSPECTOR CT;
	-		RNER TYPE			ATES (Optional)
				N Elevation		_E
	=	ernment Corner	☐ Control ☐ Property	11-4-	Metric	U.S. Survey Foot
	☐ I Mea	nder	☐ Property	/ Horizontal D		
		0110	☐ Other			Date
•	Date of Su	rvey <u>AUGUST</u>	14, 2020	Vertical Datu	m	
						rces Code §§8801-8819 rces Code §§8890-8902
PLS Act Ref:	☐ 8765(d)	 ⊠ 8771				Other:
Corner/	Left as found	☐ Establ	ished	☐ Rebuilt		Pre-Construction
Monument:		ged 🛛 Reest		Referenced	=	Post-Construction
Marrative of co	rner identified and	monument as fo	nund set res	et, replaced, or remo	ved.	
	#2 for description (ouria, set, res	et, replaced, or reme	veu.	
THE PURPOSE	OF THIS RECORD IS	TO DOCUMENT	THE PERPETU	JATION OF FOUND MOI	NUMENT(S) PUI	RSUANT TO THE PLS ACT
SECTION 8//I.	M(1) = M(1) = M(1)			E THE DOINTS CHOUNT		
LOCATIONS. RI		EL, OR LOT LINE	S, OR ANY O	F THE POINTS SHOWN THER DATA RELATED		IRUE BOUNDARY N OF PROPERTY RIGHTS A
LOCATIONS. RID DISPLAYED FOR BEARINGS SHO	GHT OF WAY, PARC R GRAPHICAL REPRI WWN HEREON ARE A	EL, OR LOT LINE ESENTATION ONL SSUMED AND AF	S, OR ANY O Y. RE DISPLAYED	THER DATA RELATED FOR ANGULAR RELAT	TO DELINEATIO ONSHIP ONLY.	N OF PROPERTY RIGHTS A
LOCATIONS. RID DISPLAYED FOR BEARINGS SHO MEASURED DIS 1.00006548.	GHT OF WAY, PARC R GRAPHICAL REPRI WN HEREON ARE A TANCES SHOWN HE	EL, OR LOT LINE ESENTATION ONL SSUMED AND AF REON ARE GRID	S, OR ANY O Y. RE DISPLAYED DISTANCES. T	THER DATA RELATED FOR ANGULAR RELAT O OBTAIN A GROUND	TO DELINEATIO ONSHIP ONLY. DISTANCE, MU	N OF PROPERTY RIGHTS A
LOCATIONS. RID DISPLAYED FOR BEARINGS SHO MEASURED DIS 1.00006548. RECORD DISTA	GHT OF WAY, PARC R GRAPHICAL REPRI WN HEREON ARE A TANCES SHOWN HE	EL, OR LOT LINE ESENTATION ONL SSUMED AND AF REON ARE GRID	S, OR ANY O Y. RE DISPLAYED DISTANCES. T	THER DATA RELATED FOR ANGULAR RELAT O OBTAIN A GROUND	TO DELINEATIO ONSHIP ONLY. DISTANCE, MU	N OF PROPERTY RIGHTS A LTIPLY A GRID DISTANCE NCES MAY BE EITHER GRII
LOCATIONS. RID DISPLAYED FOR BEARINGS SHO MEASURED DIS 1.00006548. RECORD DISTA	GHT OF WAY, PARC R GRAPHICAL REPRI WN HEREON ARE A STANCES SHOWN HE NCES SHOWN HEREO PER SAID RECORD.	EL, OR LOT LINE ESENTATION ONL SSUMED AND AF REON ARE GRID ON ARE AS THE	S, OR ANY O Y. RE DISPLAYED DISTANCES. T Y APPEAR ON	THER DATA RELATED FOR ANGULAR RELAT O OBTAIN A GROUND THE DOCUMENT OF F	TO DELINEATIO ONSHIP ONLY. DISTANCE, MU	N OF PROPERTY RIGHTS A LTIPLY A GRID DISTANCE NCES MAY BE EITHER GRII
LOCATIONS. RIC DISPLAYED FOR BEARINGS SHO MEASURED DIS 1.00006548. RECORD DISTA GROUND, AS F	GHT OF WAY, PARC R GRAPHICAL REPRI WIN HEREON ARE A STANCES SHOWN HE NCES SHOWN HEREO PER SAID RECORD.	EL, OR LOT LINE ESENTATION ONL SSUMED AND AF REON ARE GRID ON ARE AS THE	S, OR ANY OY. RE DISPLAYED DISTANCES. T Y APPEAR ON STATEMENT	THER DATA RELATED FOR ANGULAR RELAT O OBTAIN A GROUND THE DOCUMENT OF F	TO DELINEATIO ONSHIP ONLY. DISTANCE, MU RECORD. DISTA	N OF PROPERTY RIGHTS A LTIPLY A GRID DISTANCE NCES MAY BE EITHER GRII
LOCATIONS. RIC DISPLAYED FOR BEARINGS SHO MEASURED DIS 1.00006548. RECORD DISTA GROUND, AS P	GHT OF WAY, PARC R GRAPHICAL REPRI WIN HEREON ARE A STANCES SHOWN HEREO PER SAID RECORD. GRAPHICAL REPRI STANCES SHOWN HEREO STANC	EL, OR LOT LINE ESENTATION ONL SSUMED AND AF REON ARE GRID ON ARE AS THE SURVEYOR'S S Epared by me or	S, OR ANY OY. RE DISPLAYED DISTANCES. THE STATEMENT ON THE STATEMENT OF T	THER DATA RELATED FOR ANGULAR RELAT O OBTAIN A GROUND THE DOCUMENT OF F	TO DELINEATIO ONSHIP ONLY. DISTANCE, MU RECORD. DISTAI	N OF PROPERTY RIGHTS A LTIPLY A GRID DISTANCE NCES MAY BE EITHER GRID NOR MORE ON MORE OF THE OR OF THE
BEARINGS SHO MEASURED DIS 1.00006548. RECORD DISTA GROUND, AS F	GHT OF WAY, PARC R GRAPHICAL REPRI WIN HEREON ARE A STANCES SHOWN HE NCES SHOWN HEREO PER SAID RECORD. Ger Record was pressional Land Surve	EL, OR LOT LINE ESENTATION ONL SSUMED AND AF REON ARE GRID ON ARE AS THE SURVEYOR'S S Epared by me or Eyors' Act on	S, OR ANY O Y. RE DISPLAYED DISTANCES. T Y APPEAR ON STATEMENT under my dir EBRUARY 2	THER DATA RELATED FOR ANGULAR RELAT O OBTAIN A GROUND THE DOCUMENT OF F Tection in conformance 23, 2021	TO DELINEATIO ONSHIP ONLY. DISTANCE, MU ECORD. DISTAN e with	N OF PROPERTY RIGHTS A LTIPLY A GRID DISTANCE NCES MAY BE EITHER GRID NOTED LAND SUPPLY NOTED LAND SUPPL












POST-CONSTRUCTION CORNER RECORD



SEE CR 2020-2703, APPARENT BC RECORD REFERENCES:

R1 CR 2017-1404

appàrent ec

R2 TR 14955 M.M.728/42-48

POR OF LOT 59, TRACT No. 14955, M.M. 728/42-48


MONUMENT NOTES:

SET PUN SPK & 1-1/2" S.S. WSHR, STMPD "OCS", FLUSH IN AC, PER TIES SHOWN HEREON

A FD LEAD, & 3/4" BR TAG STMPD "TIE RCE 23956", ON TOP OF CONC CURB, PER R1

FD MONUMENT AS DESCRIBED ON ADJACENT CORNER RECORD

LINE TABLE								
LINE #	MEASURED BEA <mark>RING</mark>	MEASURED DISTANCE	RECORD DISTANCE	REF				
L1	N12°45'28"E	23.14'	23.15'	R1				
L2	N77°41'19"W	32.70'	32.70'	R1				
L3	N12°49'30"E	23.71'	23.72'	R1				
L4	N77°39'40"W	29.47	29.47'	R1				
L5	N08°45'27"E	33.39'	33.39'	R1				
L6	N62°18'01"W	33.51'	33.52'	R1				
L7	N08°47'57"E	32.59'	32.60'	R1				
L8	N62°19'51"W	36.28	36.28'	R1				
L9 (CHORD)	N18°02'23"W	89.26	89.31	R2				
L10	N33°54'20"W	48.16'	48.17'	R2				
L11	N39°21'41"W	53.73	53.72'	R2				
L12	S08°32'04"E	35.64	35.64'	R1				

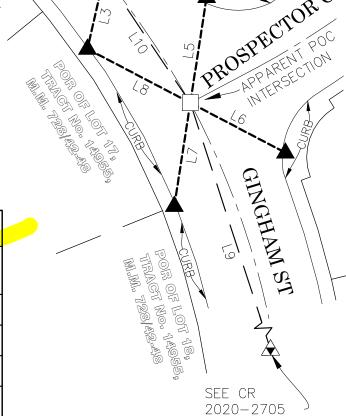

LEGEND:

--- REF LINE 1: MEAS BTWN MONS

APPARENT BC

---- REF LINE 3: TIE LINES

S.S. STAINLESS STEEL

POINT IS COMMON ON ADJACENT

CORNER RECORD

OCS ORANGE COUNTY SURVEYOR