

Orange County Surveyor

MANHOLE DETAIL:

JOB NO: JH YTC

DATE: 10/10/2023

CREW: LOFGREEN

STREET: JH YTC



TIME: 1:35 AM / PM

MANHOLE TYPE: SEWER

LID POINT NO: 402393

PHOTO NO: _____

PIPE MATERIAL: PVC

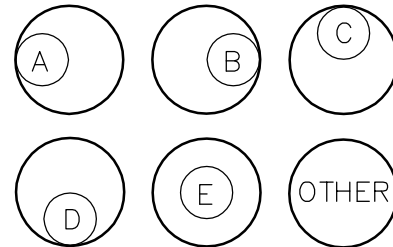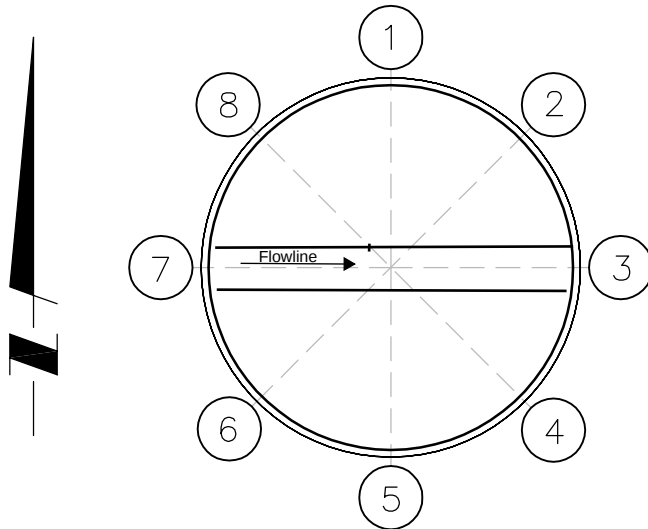

RIM OFFSET TYPE: D

POINT:	RIM ELEV:	INVERT:	F.L. ELEV:	PIPE DIA:	
1					WET / DRY
2					WET / DRY
3	132.73	13.47	119.26	10 IN	WET / DRY
4					WET / DRY
5					<u>WET</u> / DRY
6					WET / DRY
7	132.73	13.68	119.05	10 IN	<u>WET</u> / DRY
8					WET / DRY
CNTR:					WET / DRY