

Orange County Surveyor

MANHOLE DETAIL:

JOB NO: JH YTC

DATE: 02/29/2024

CREW: LOFGREEN

STREET: JUSTICE WAY



TIME: 2:23 AM / (PM)

MANHOLE TYPE: SEWER

LID POINT NO: 435418

PHOTO NO: _____

PIPE MATERIAL: PVC

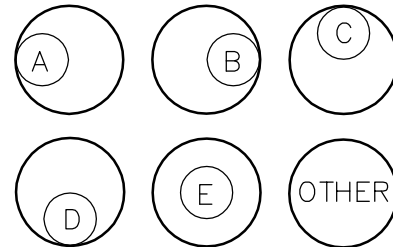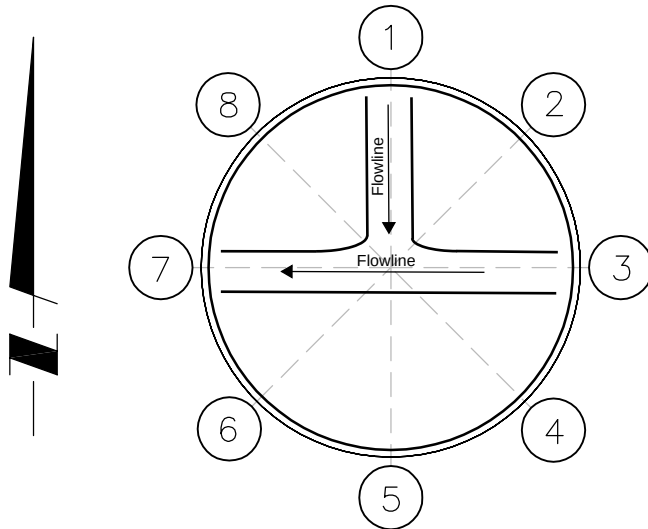

RIM OFFSET TYPE: _____

POINT:	RIM ELEV:	INVERT:	F.L. ELEV:	PIPE DIA:	
<u>1</u>	<u>128.98</u>	<u>7.14</u>	<u>121.84</u>	<u>8 IN</u>	<u>(WET)</u> / DRY
<u>2</u>	_____	_____	_____	_____	WET / DRY
<u>3</u>	<u>128.98</u>	<u>7.65</u>	<u>121.33</u>	<u>8 IN</u>	<u>(WET)</u> / DRY
<u>4</u>	_____	_____	_____	_____	WET / DRY
<u>5</u>	_____	_____	_____	_____	WET / DRY
<u>6</u>	_____	_____	_____	_____	WET / DRY
<u>7</u>	<u>128.98</u>	<u>7.75</u>	<u>121.23</u>	<u>8 IN</u>	<u>(WET)</u> / DRY
<u>8</u>	_____	_____	_____	_____	WET / DRY
CNTR:	_____	_____	_____	_____	WET / DRY