

Orange County Surveyor

MANHOLE DETAIL:

JOB NO: JH YTC

DATE: 02/09/2024

CREW: J. Russo/ A. Payan

STREET: Justice Center Way



TIME: 8:15 AM / PM

MANHOLE TYPE: Sewer

LID POINT NO: 435623

PHOTO NO: 20

PIPE MATERIAL: PVC

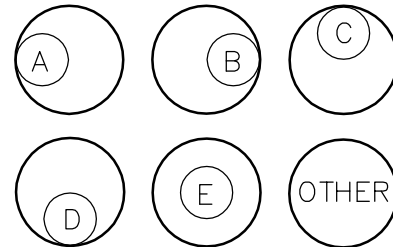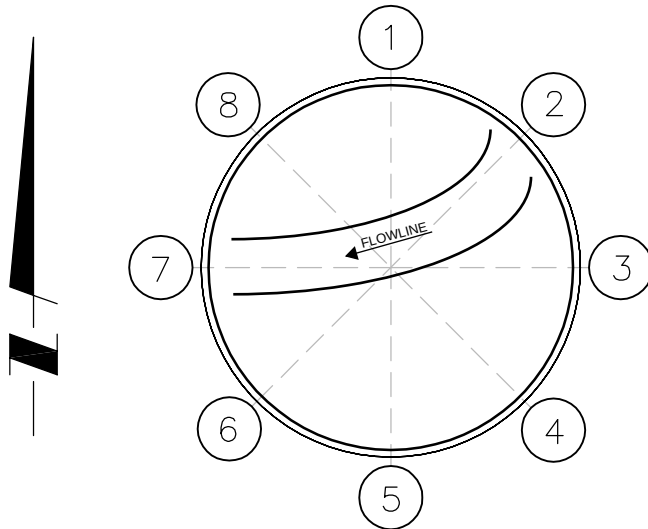

RIM OFFSET TYPE: C

POINT:	RIM ELEV:	INVERT:	F.L. ELEV:	PIPE DIA:	
1					WET / DRY
2	129.11	7.14	121.97	8 IN	WET / DRY
3					WET / DRY
4					WET / DRY
5					WET / DRY
6					WET / DRY
7	129.11	7.22	121.89	8 IN	WET / DRY
8					WET / DRY
CNTR:					WET / DRY