

Orange County Surveyor

MANHOLE DETAIL:

JOB NO: JH YTC

DATE: 02/29/2024

CREW: LOFGREEN

STREET: JUSTICE WAY



TIME: 2:00 AM / PM

MANHOLE TYPE: STORM DRAIN

LID POINT NO: 435859

PHOTO NO: _____

PIPE MATERIAL: RCP

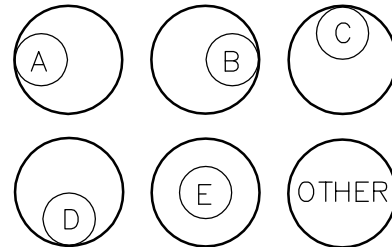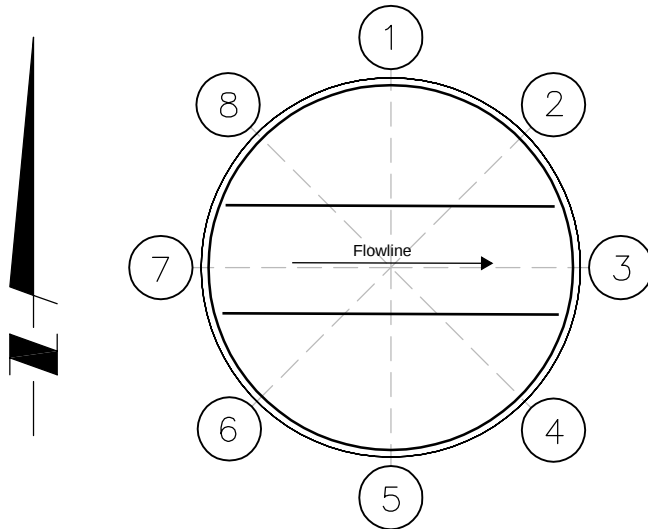

RIM OFFSET TYPE: D

POINT:	RIM ELEV:	INVERT:	F.L. ELEV:	PIPE DIA:	
1					WET / DRY
2					WET / DRY
3	128.73	9.54	119.19	60"	WET / <u>DRY</u>
4					WET / DRY
5					WET / DRY
6					WET / DRY
7	128.73	9.47	119.26	60"	WET / <u>DRY</u>
8					WET / DRY
CNTR:					WET / DRY