

Orange County Surveyor

MANHOLE DETAIL:

JOB NO: JH YTC

DATE: 02/09/2024

CREW: J. Russo/ A. Payan

STREET: Justice Center Way



TIME: 8:30 AM / PM

MANHOLE TYPE: Sewer

LID POINT NO: 435869

PHOTO NO: 21

PIPE MATERIAL: PVC

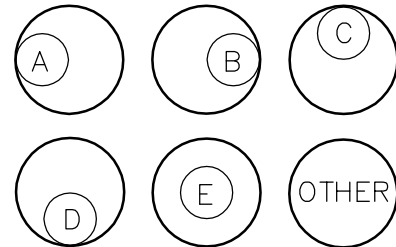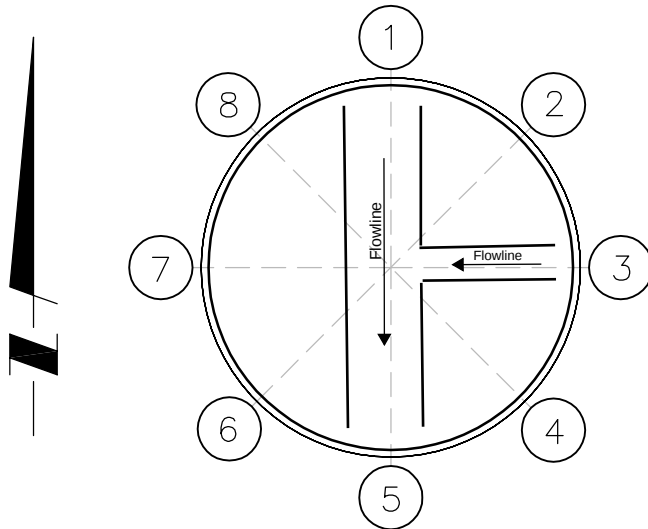

RIM OFFSET TYPE: E

POINT:	RIM ELEV:	INVERT:	F.L. ELEV:	PIPE DIA:	
1	129.80	13.30'	116.50	10 IN	<u>WET</u> / DRY
2					WET / DRY
3	129.80	12.57'	117.23	8 IN	<u>WET</u> / DRY
4					WET / DRY
5	129.80	13.40'	116.40	10 IN	<u>WET</u> / DRY
6					WET / DRY
7					WET / DRY
8					WET / DRY
CNTR:					WET / DRY